



HAROLD H. KOLB

REGISTERED PROFESSIONAL LAND SURVEYOR
LAKE GENEVA, WISCONSIN

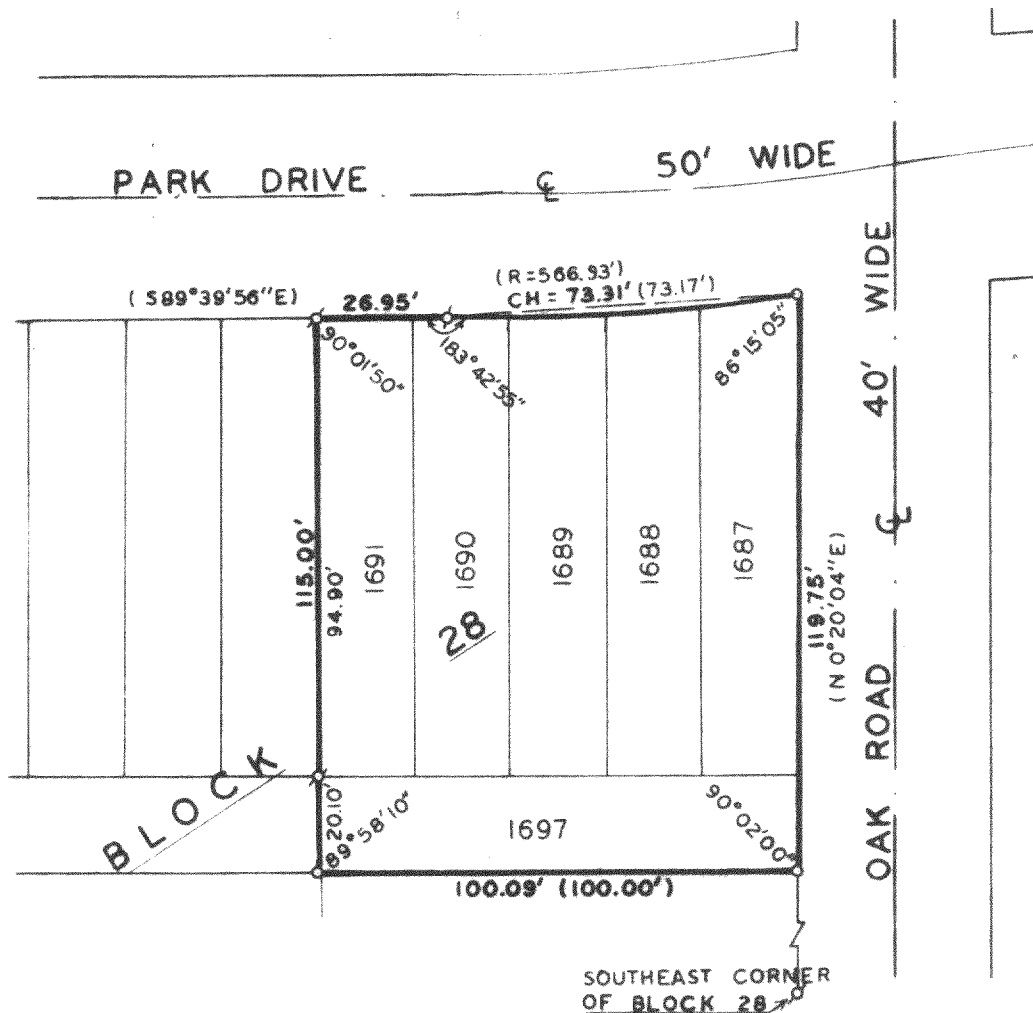

PLAT OF SURVEY OF

Lots 1687-1691 and lot 1697, Block
28, Lake Como Beach Subdivision,
T2N, R17E, Walworth County, Wisconsin.

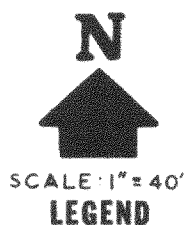


- φ — IRON PIPE FOUND
- — IRON PIPE PLACED
- — CONCRETE MONUMENT
- x — SPIKE
- () — AS PLATTED

OWNER: Max Misiurak
Park Drive Box 691
Lake Geneva, Wis.

ACCURACY: Distances $\pm 0.01'$
Angles $\pm 05''$
Error of closure
less than $1/3000$

I, HAROLD H. KOLB, DO HEREBY CERTIFY THAT I HAVE
SURVEYED THE PROPERTY HEREON DESCRIBED ACCORDING
TO THE OFFICIAL RECORDS, AND THAT THE PLAT HEREON
IS A CORRECT REPRESENTATION OF THE LOT LINES.

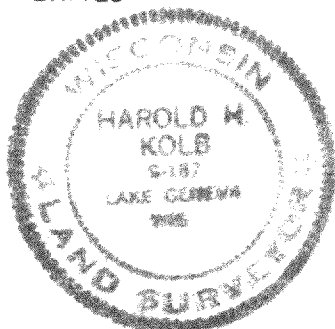

Harold H. Kolb
HAROLD H. KOLB
WISCONSIN REGISTERED LAND SURVEYOR, S-187
DATE *Feb. 17, 1975*

JLCB-265

217-436