
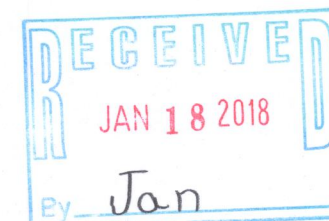


LOCUST DRIVE

(40' WIDE)

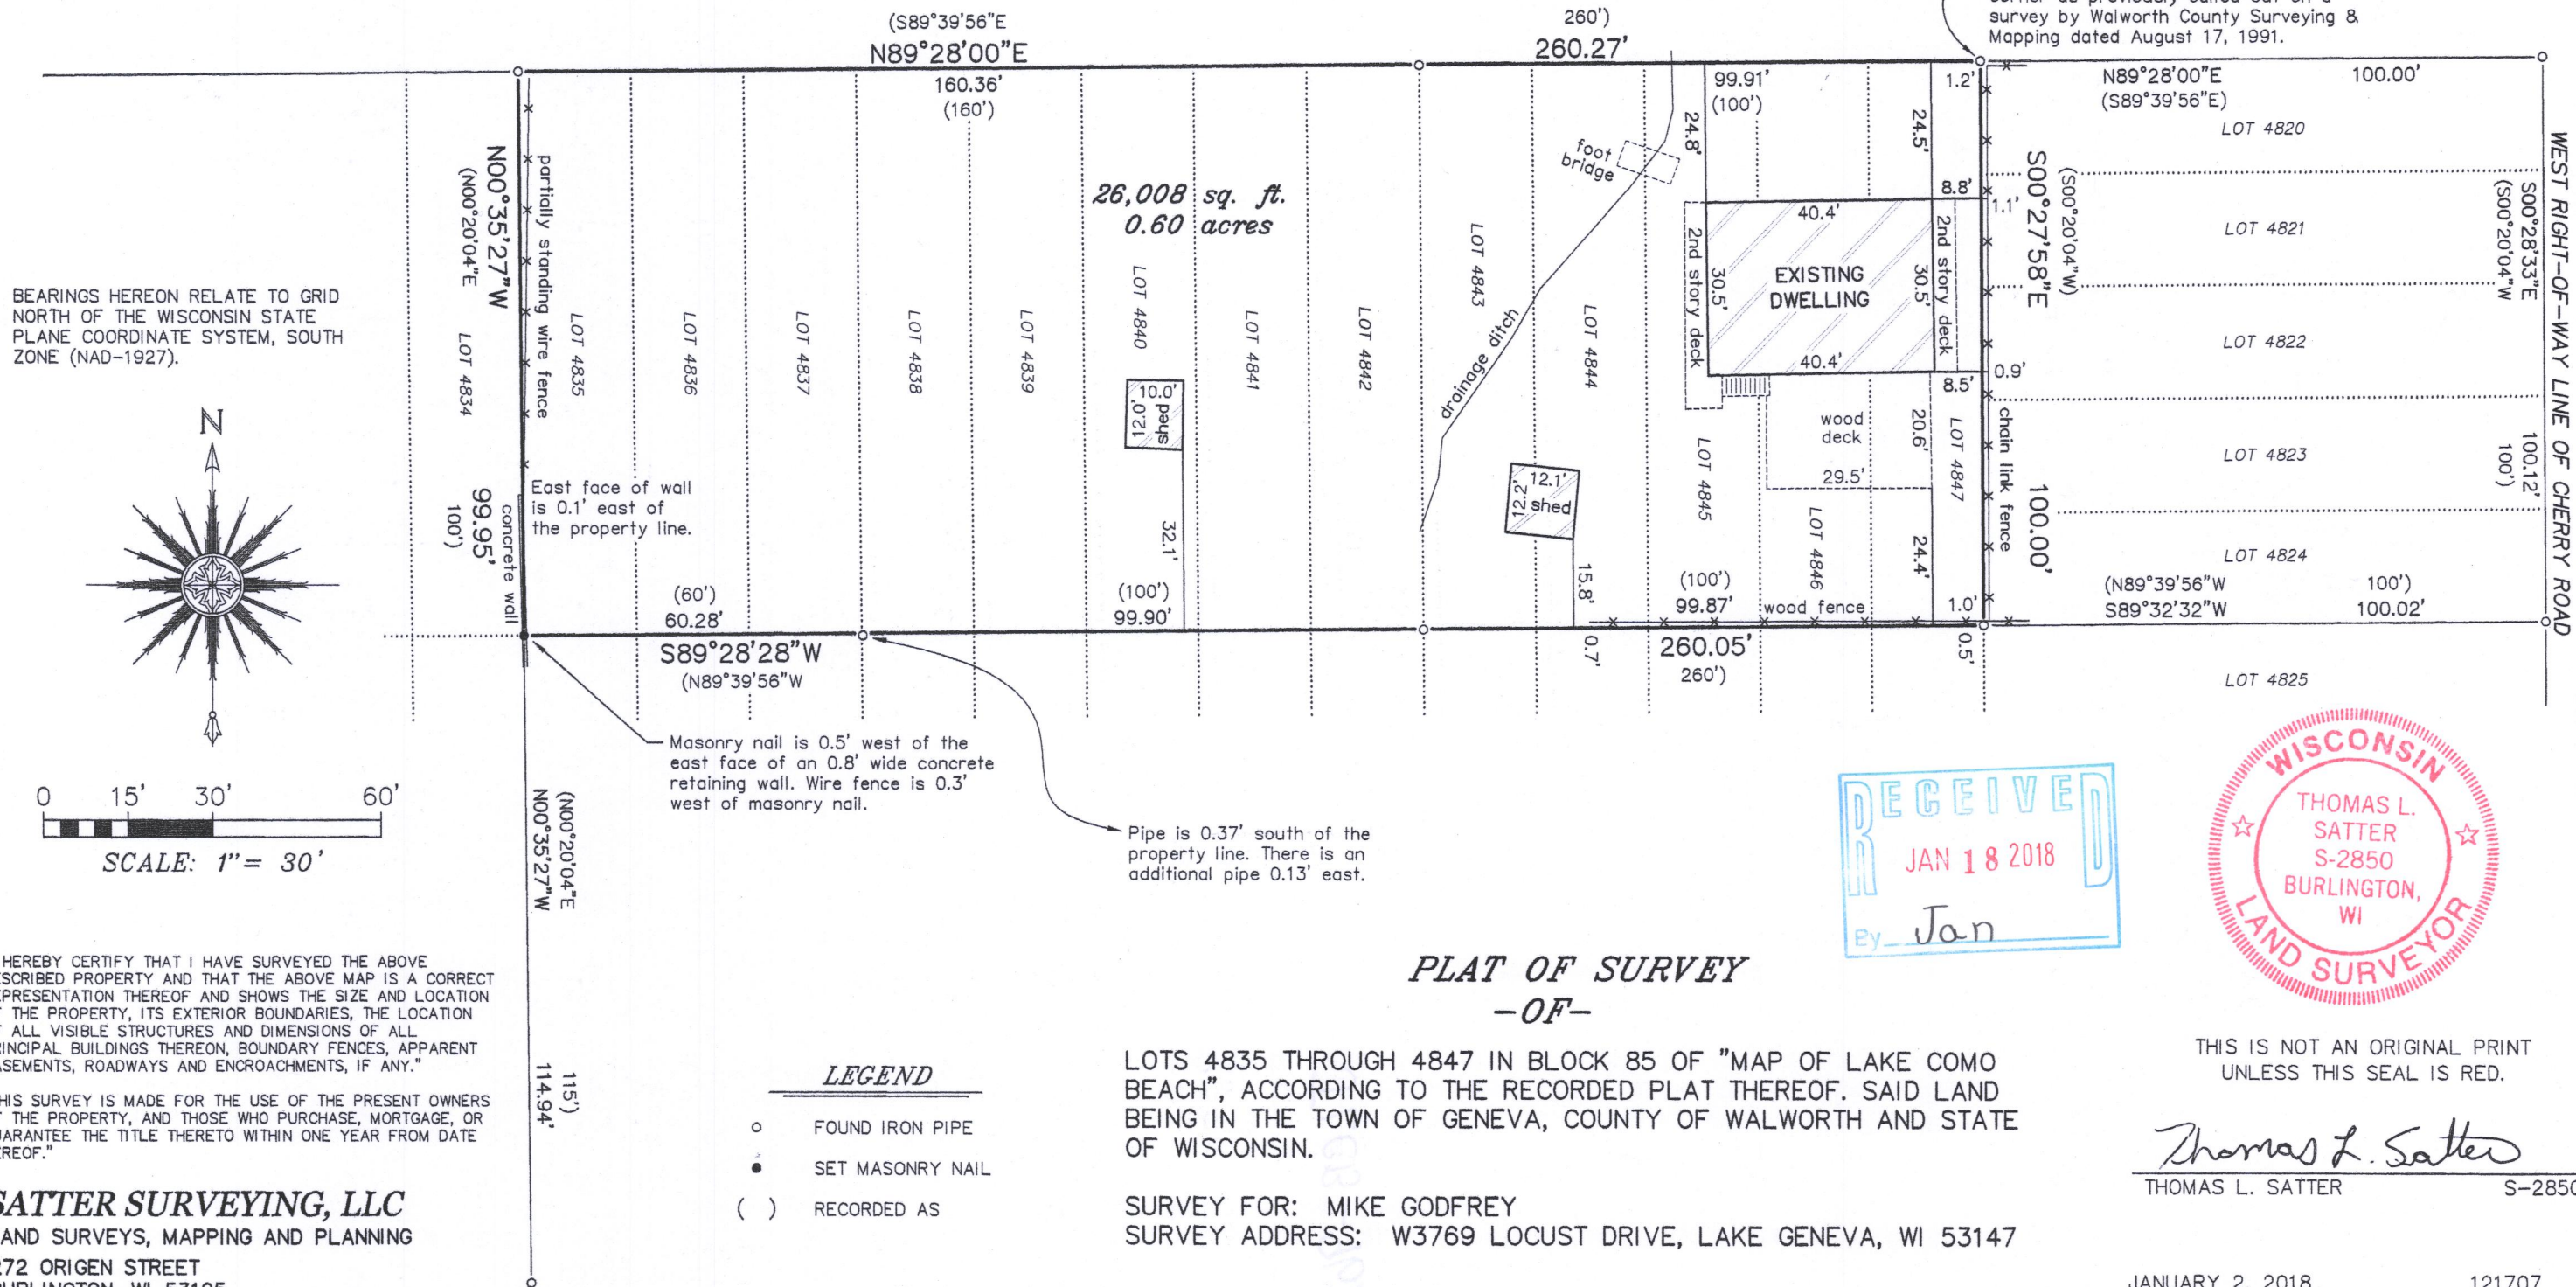

THIS IS NOT AN ORIGINAL PRINT
UNLESS THIS SEAL IS RED.

Thomas L. Satter
THOMAS L. SATTER S-2850

JANUARY 2, 2018
DATE

121707
JOB NUMBER

JLCB-962

217-4408