


PLAT OF SURVEY - AS BUILT UNITS 22-04 & 22-05

GENEVA NATIONAL CONDOMINIUM NO. 22
LOCATED IN PART OF THE NW 1/4 OF THE SE 1/4
OF SECTION 29, TOWN 2 NORTH, RANGE 17 EAST,
TOWN OF GENEVA, WALWORTH COUNTY, WISCONSIN

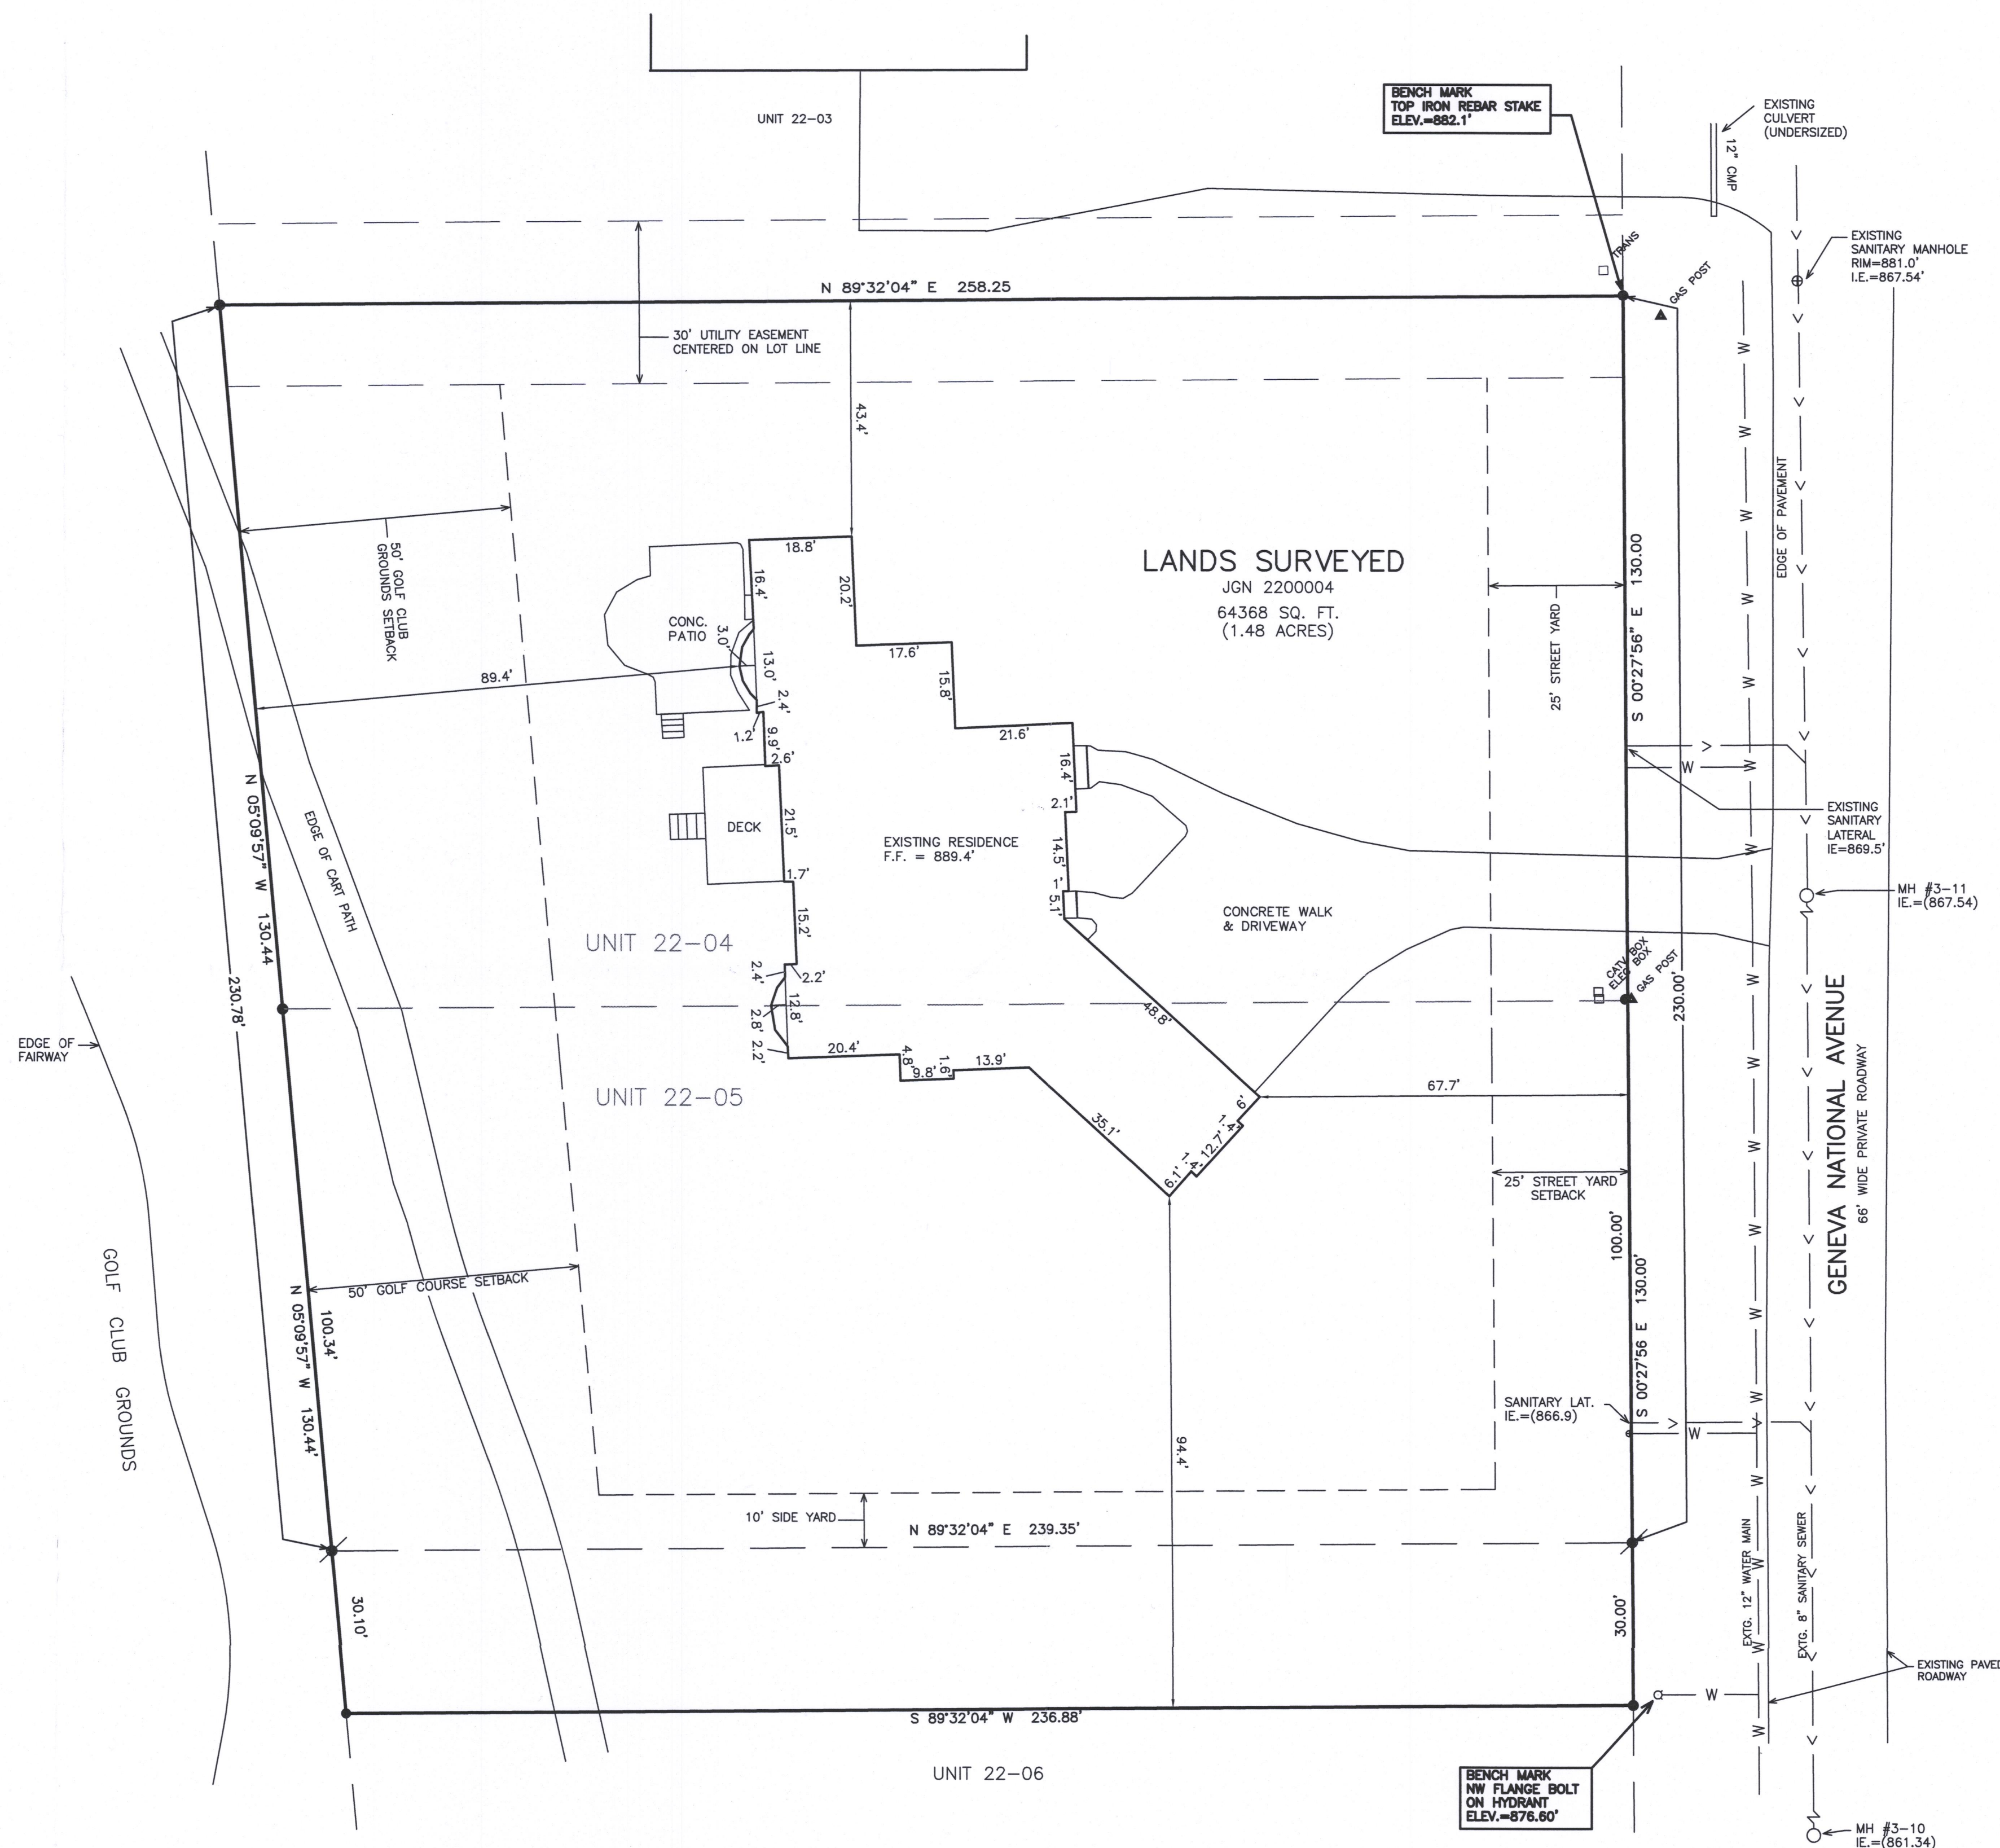



NOTE: COPIES OF THIS MAP TO WHICH THE FOLLOWING CERTIFICATE WILL APPLY SHOW THE SURVEYOR'S ORIGINAL SEAL AND SIGNATURE IN RED INK. COPIES BY ANY OTHER MEANS MAY HAVE ALTERATIONS WHICH DO NOT REPRESENT THE SURVEYOR'S WORK PRODUCT.

I HEREBY CERTIFY THAT THE ABOVE DESCRIBED PROPERTY HAS BEEN SURVEYED UNDER MY DIRECTION AND THAT THE ABOVE MAP IS A TRUE REPRESENTATION THEREOF AND SHOWS THE SIZE AND LOCATION OF THE PROPERTY AND ITS EXTERIOR BOUNDARIES. THIS SURVEY IS MADE FOR THE USE OF THE PRESENT OWNERS OF THE PROPERTY, AND ALSO THOSE WHO PURCHASE, MORTGAGE, OR GUARANTEE THE TITLE THERETO WITHIN ONE YEAR FROM THE DATE HEREOF.

DATED: 01/31/2017

03/01/2018 REVISED TO
SHOW AS BUILT RESIDENCE

BRIAN M. CARLSON P.L.S. 2039

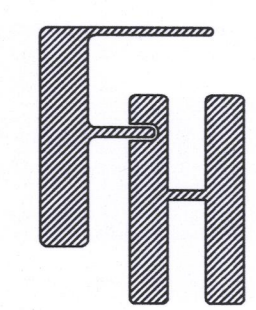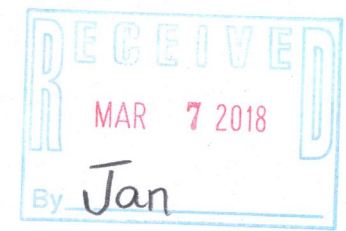

PLAT OF SURVEY - AS BUILT
UNIT 22-04 & 22-05
GENEVA NATIONAL CONDO. NO. 22

WORK ORDERED BY -
CAROL SCOVOTT
36 CANYON LANE
Mc FARLAND, WI 53558

FARRIS, HANSEN & ASSOCIATES, INC.
ENGINEERING - ARCHITECTURE - SURVEYING
7 RIDGWAY COURT P.O. BOX 437
ELKHORN, WISCONSIN 53121
OFFICE: (262) 723-2098 FAX: (262) 723-5886

REVISIONS
03/01/2018 - LB
AS BUILT

PROJECT NO.
3269-22-05.16

DATE
01/31/2017

SHEET NO.
1 OF 1

JGN 22-4 217-4413