

LAND-MARK SURVEYING

Mark L. Miritz

Wisconsin Professional Land Surveyor S-2582

N9330 Knuteson Drive
Whitewater, WI 53190
Phone: (262) 495-3284
MARKMIRITZ@
LAND-MARKSURVEYING.COM

PLAT OF SURVEY

TAX PARCEL JLCB 01561

9,982 SQ. FT.

LONGFELLOW DRIVE


(50' WIDE)

LEGAL DESCRIPTION


LOTS 7355 THRU 7359 AND LOTS 7360 THRU 7363, BLOCK 126, LAKE COMO
BEACH SUBDIVISION FIRST MAP, LOCATED IN SECTION 28, TOWN 2 NORTH,
RANGE 17 EAST, WALWORTH COUNTY, WISCONSIN.

OWNERS:

LUIS FLORES
ELSA I. FLORES
6318 W. BRYAN MAWR AVE.
CHICAGO, IL 60646

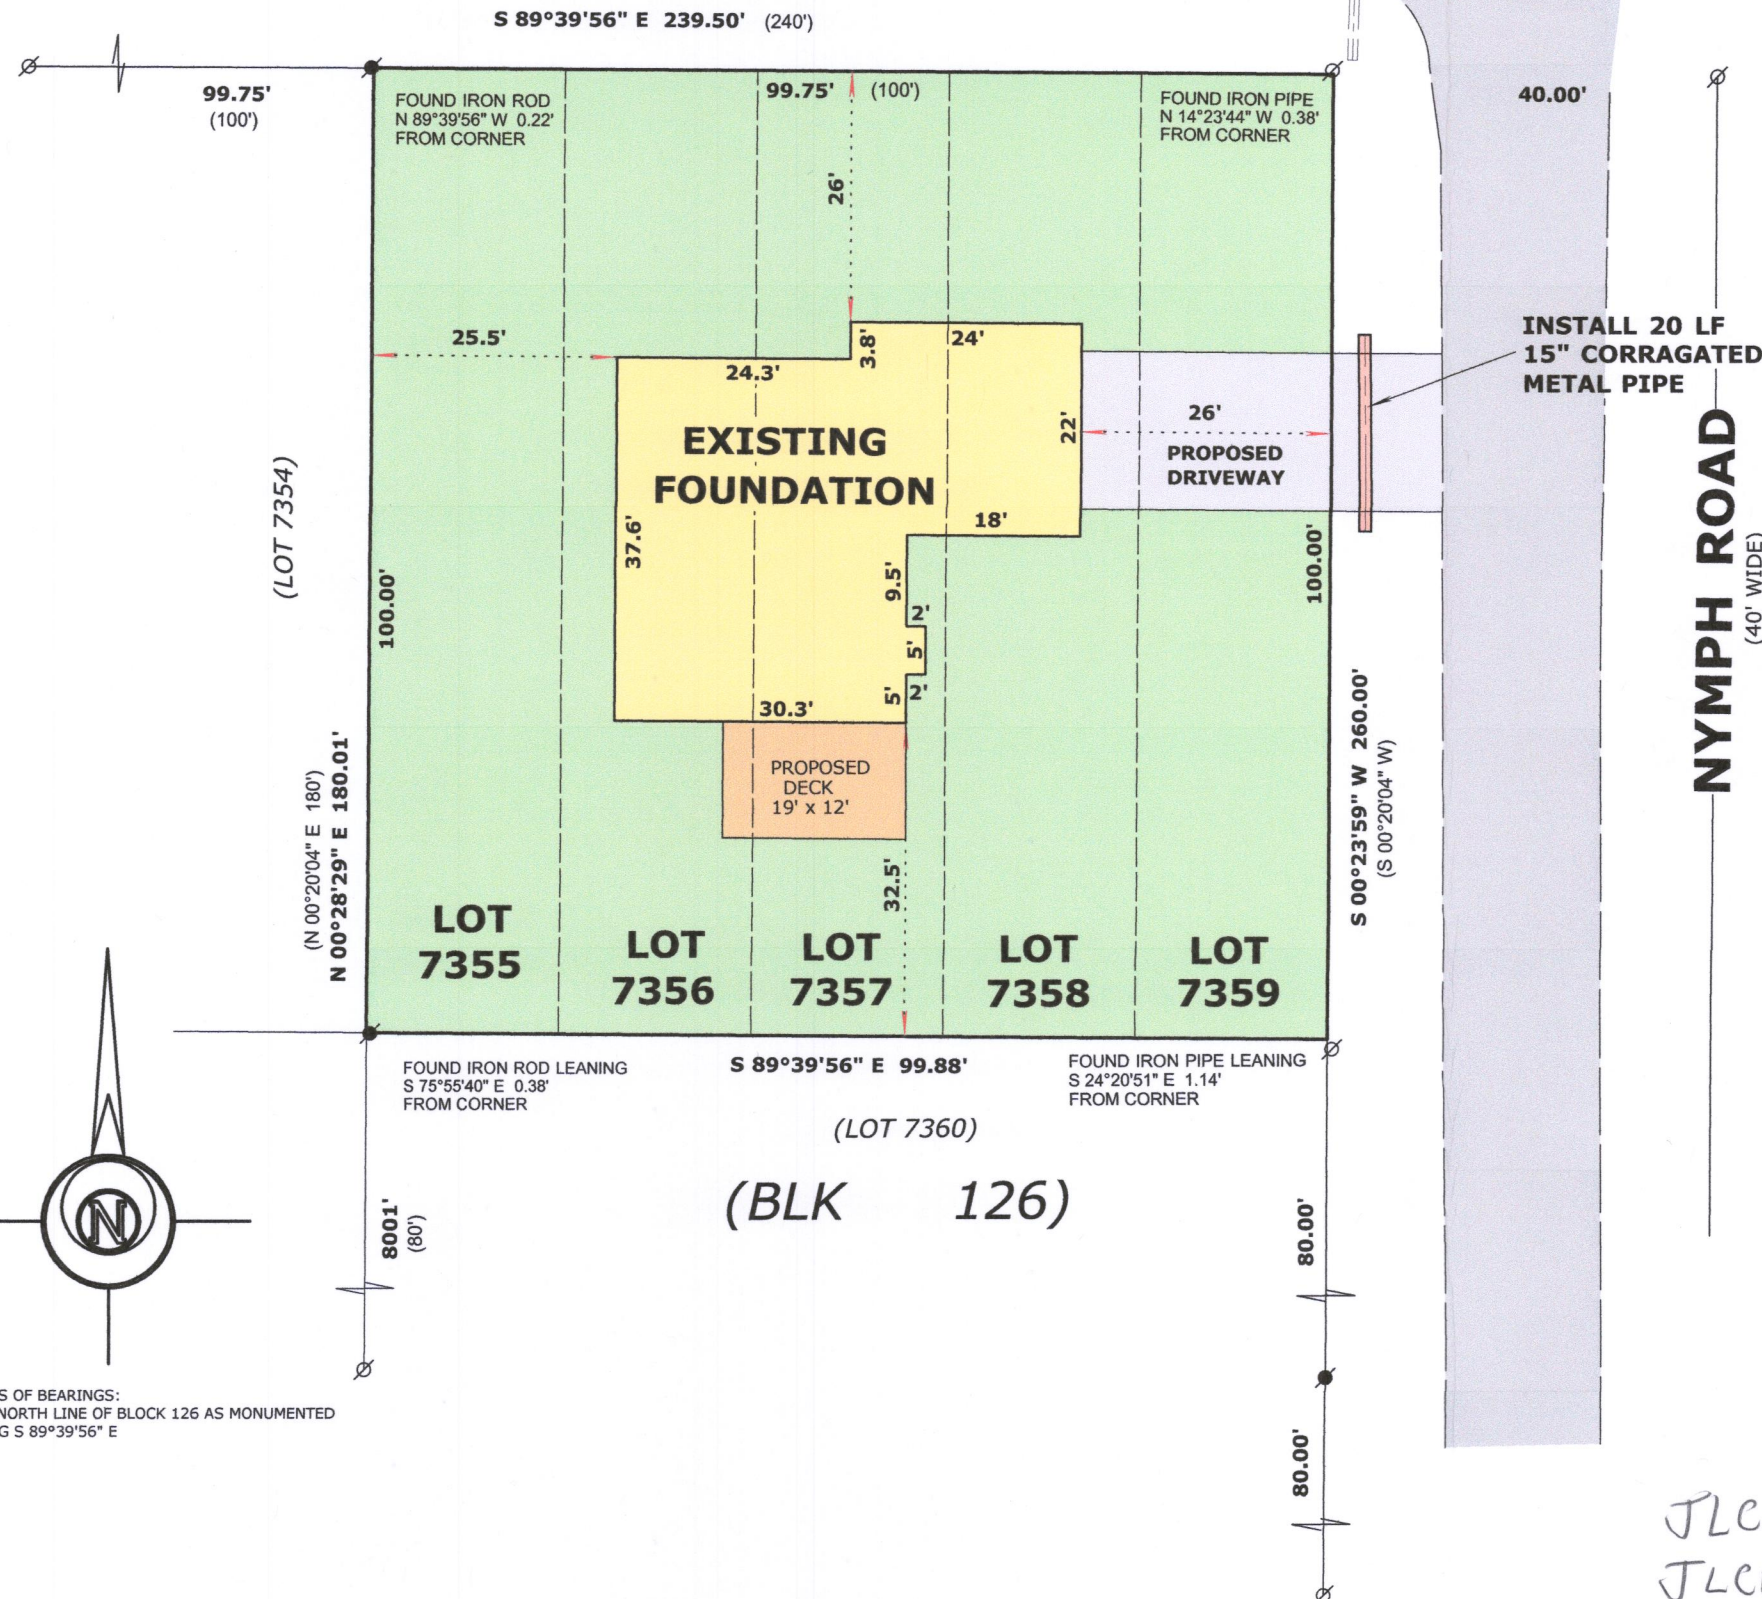

BASIS OF BEARINGS:
THE NORTH LINE OF BLOCK 126 AS MONUMENTED
BEING S 89°39'56" E

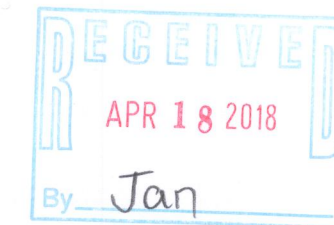

LEGEND

- FOUND IRON PIPE
- FOUND IRON ROD
- (x x) RECORDED AS DIMENSION
- x — EXISTING FENCE

SCALE: 1 INCH = 20 FEET

"I hereby certify that the above described property has been surveyed by me or under my direction and that the above map is a true representation thereof and shows the size and location of the property, its exterior boundaries, the location of all visible structures and dimensions of all principal buildings thereon, boundary fences, apparent easements, roadways and visible encroachments, if any."
"This survey is made for the use of the present owners of the property, and also those who purchase, mortgage, or guarantee the title thereto within one year from date hereof."

Mark L. Miritz
MARK L. MIRITZ
WISCONSIN PROFESSIONAL
LAND SURVEYOR S-2582

DATE: February 1, 2018 JOB NO. 17.813

JLCB-1561
JLCB-1562

REVISED APRIL 2, 2018
TO SHOW FOUNDATION
"AS BUILT"

217-4428