


PLAT OF SURVEY

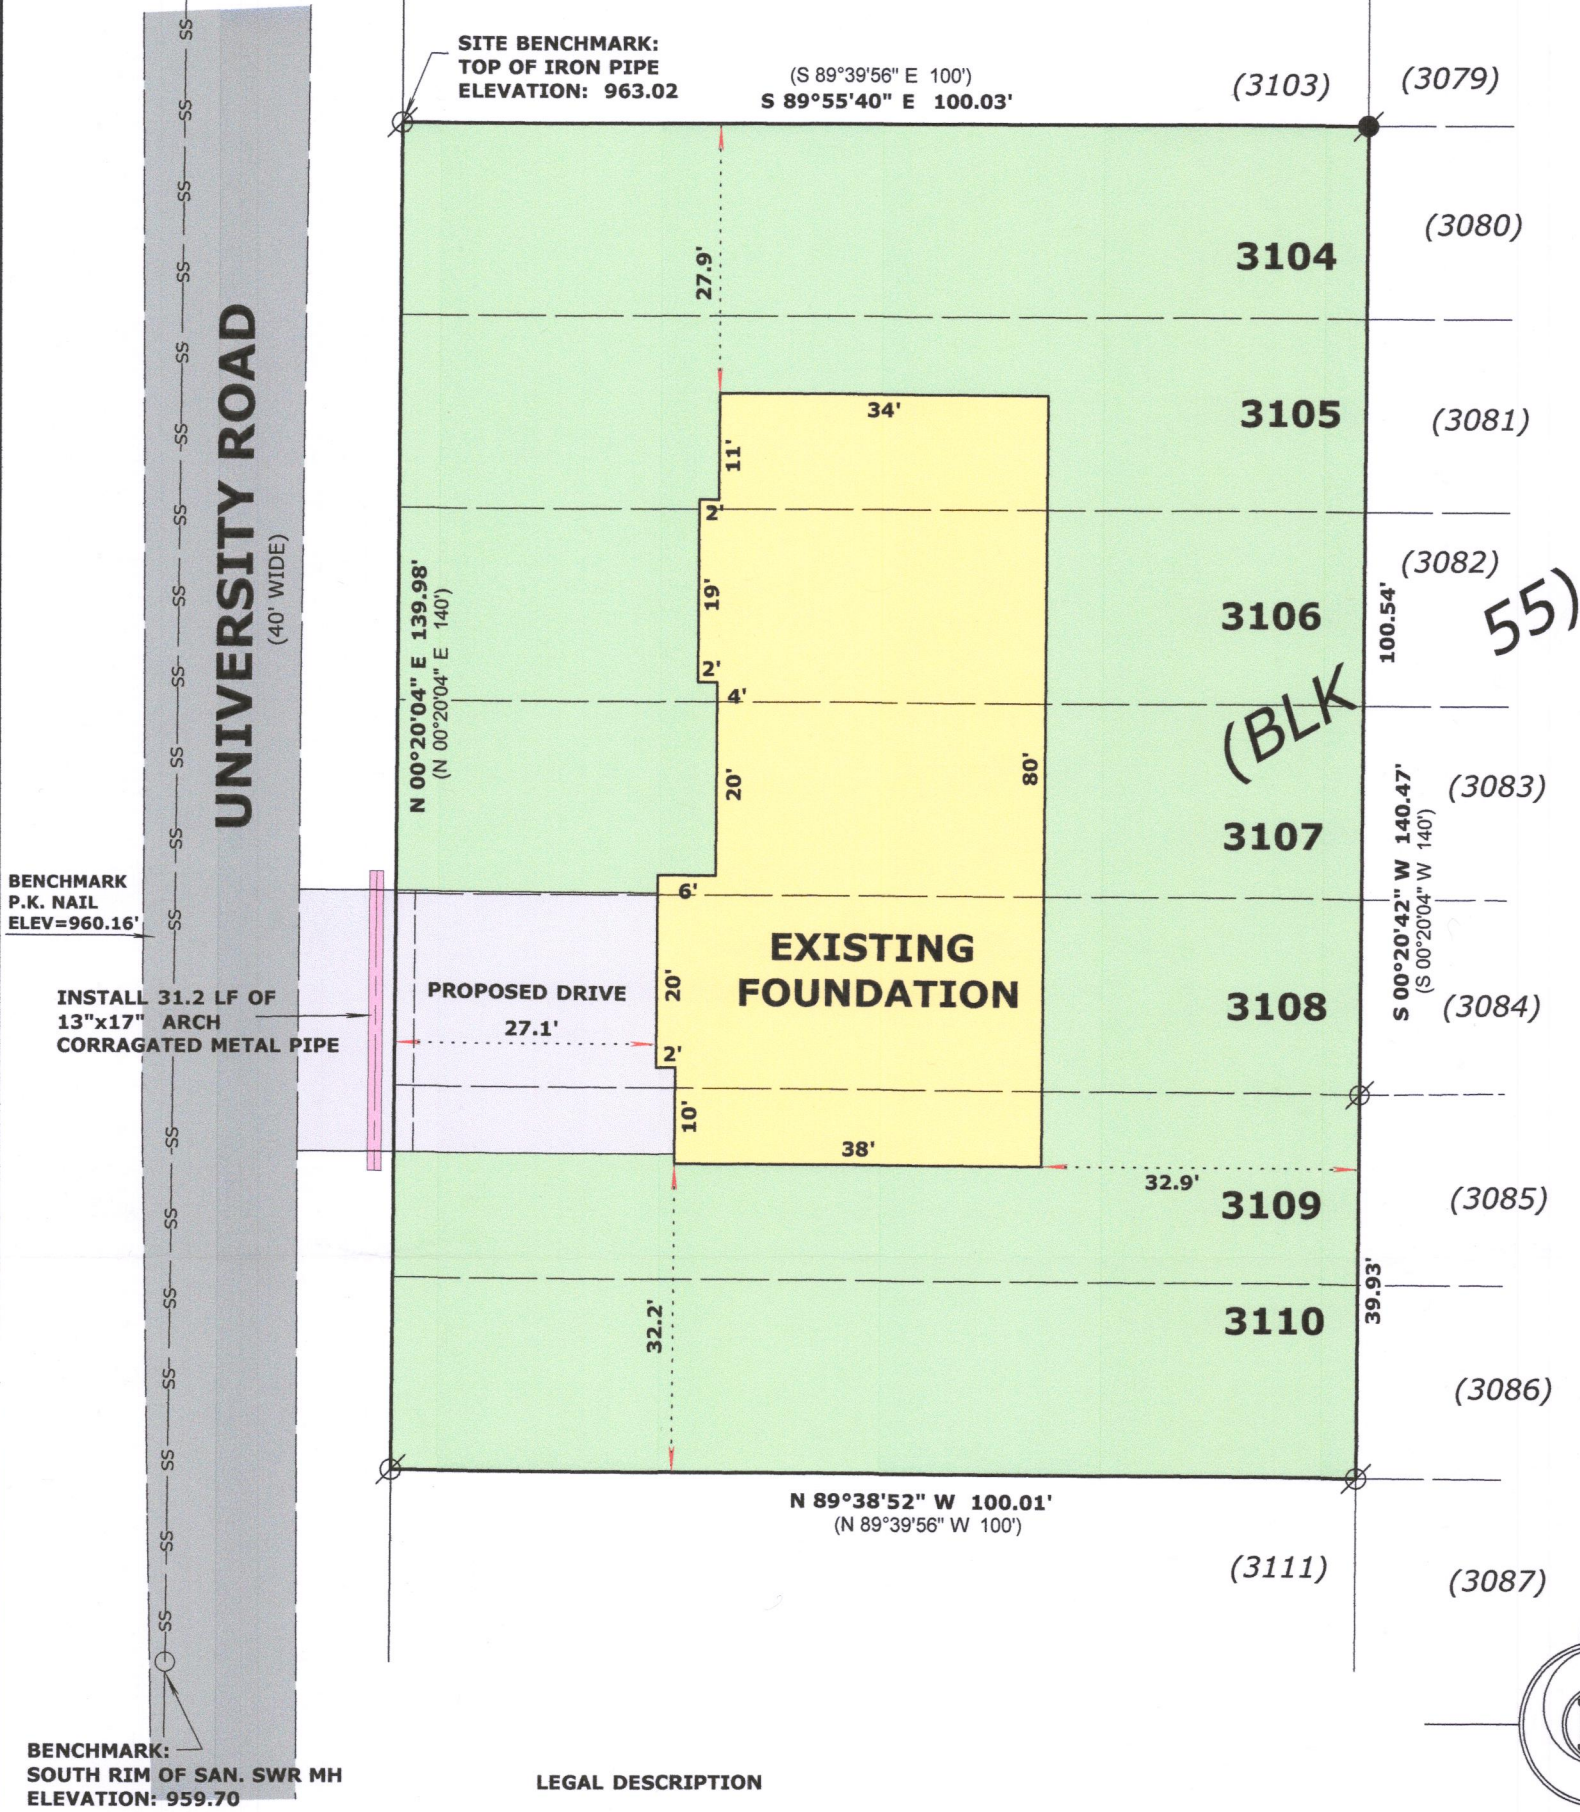

LEGAL DESCRIPTION

LOCATED IN THE SOUTHWEST 1/4 OF THE SOUTHWEST 1/4,
SECTION 22, TOWNSHIP 2 NORTH, RANGE 17 EAST, IN THE
TOWN OF GENEVA, WALWORTH COUNTY, WISCONSIN

LOTS 3104 THRU 3110, INCLUSIVE, IN BLOCK 55, LAKE
COMO BEACH SECOND MAP.

LEGEND

- FOUND IRON PIPE
FOUND IRON ROD
(X X) RECORDED AS DIMENSION

SCALE: 1 INCH = 20 FEET

"I hereby certify that the above described property has
been surveyed by me or under my direction and that the
above map is a true representation thereof and shows the
size and location of the property, its exterior boundaries,
the location of all visible structures and dimensions of all
principal buildings thereon, boundary fences, apparent
easements, roadways and visible encroachments, if any."
"This survey is made for the use of the present owners of
the property, and also those who purchase, mortgage, or
guarantee the title thereto within one year from date
hereof."

Mark L. Miritz
MARK L. MIRITZ
WISCONSIN PROFESSIONAL
LAND SURVEYOR S-2582

DATE: December 11, 2017 JOB NO. 17.1204

REVISED APRIL 23, 2018 TO
SHOW FOUNDATION "AS BUILT"



JLCB-560

217-4463