

PREPARED FOR
SUNRISE HOMES,
INC.


ORDERED BY
STEVE
BERGHOLTZ

PLAT OF SURVEY

- OF -

LOT 6 OF MAPLE TREE FARMS A SUBDIVISION OF PART OF THE
NORTHWEST 1/4, SOUTHWEST 1/4 AND SOUTHEAST 1/4 OF THE
SOUTHEAST 1/4 OF SECTION 33, TOWNSHIP 2 NORTH, RANGE 17 EAST,
TOWN OF GENEVA, COUNTY OF WALWORTH AND STATE OF WISCONSIN.

PATHFINDER SURVEYING
(a NMB Company)
P.O BOX 322
LAKE GENEVA, WI. 53147
WWW.PATHFINDERSURVEYING.NET
262-248-8303

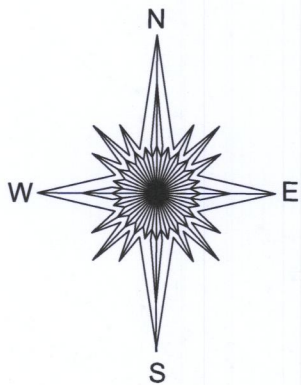

FOUNDATION CERTIFICATION

The foundation of the residence depicted hereon
has been constructed as located. Top of
Foundation = 1043.59. All other elevations are
from survey January 29, 2018.

Mark R. Madsen

March 26, 2018

PROPERTY ADDRESS: _____ Maple Tree Lane

Proposed Top of Foundation 1042.17
Proposed Finished Garage Floor 1041.83
Proposed Finished Yard Grade 1041.50

Id	Bearing	Distance
L1	S 6°20'15" W	71.70'
L2	N 89°10'10" E	24.80'
L3	S 6°20'15" W	50.00'
L4	N 6°20'15" E	50.00'
L5	N 89°10'10" E	24.80'
L6	S 6°20'15" W	65.41'

