


-OF-




SURVEY FOR: JIM PODY
SURVEY ADDRESS: W4052 LAKE SHORE DRIVE, LAKE GENEVA, WI 53147

○	FOUND IRON PIPE
●	FOUND IRON ROD IN SUBSURFACE IRON PIPE
♂	FOUND MASONRY NAIL
()	RECORDED AS

NOTE: REFER TO A CURRENT TITLE REPORT
FOR EASEMENTS, RESTRICTIONS OR COVENANTS
WHICH MAY AFFECT THIS PROPERTY.

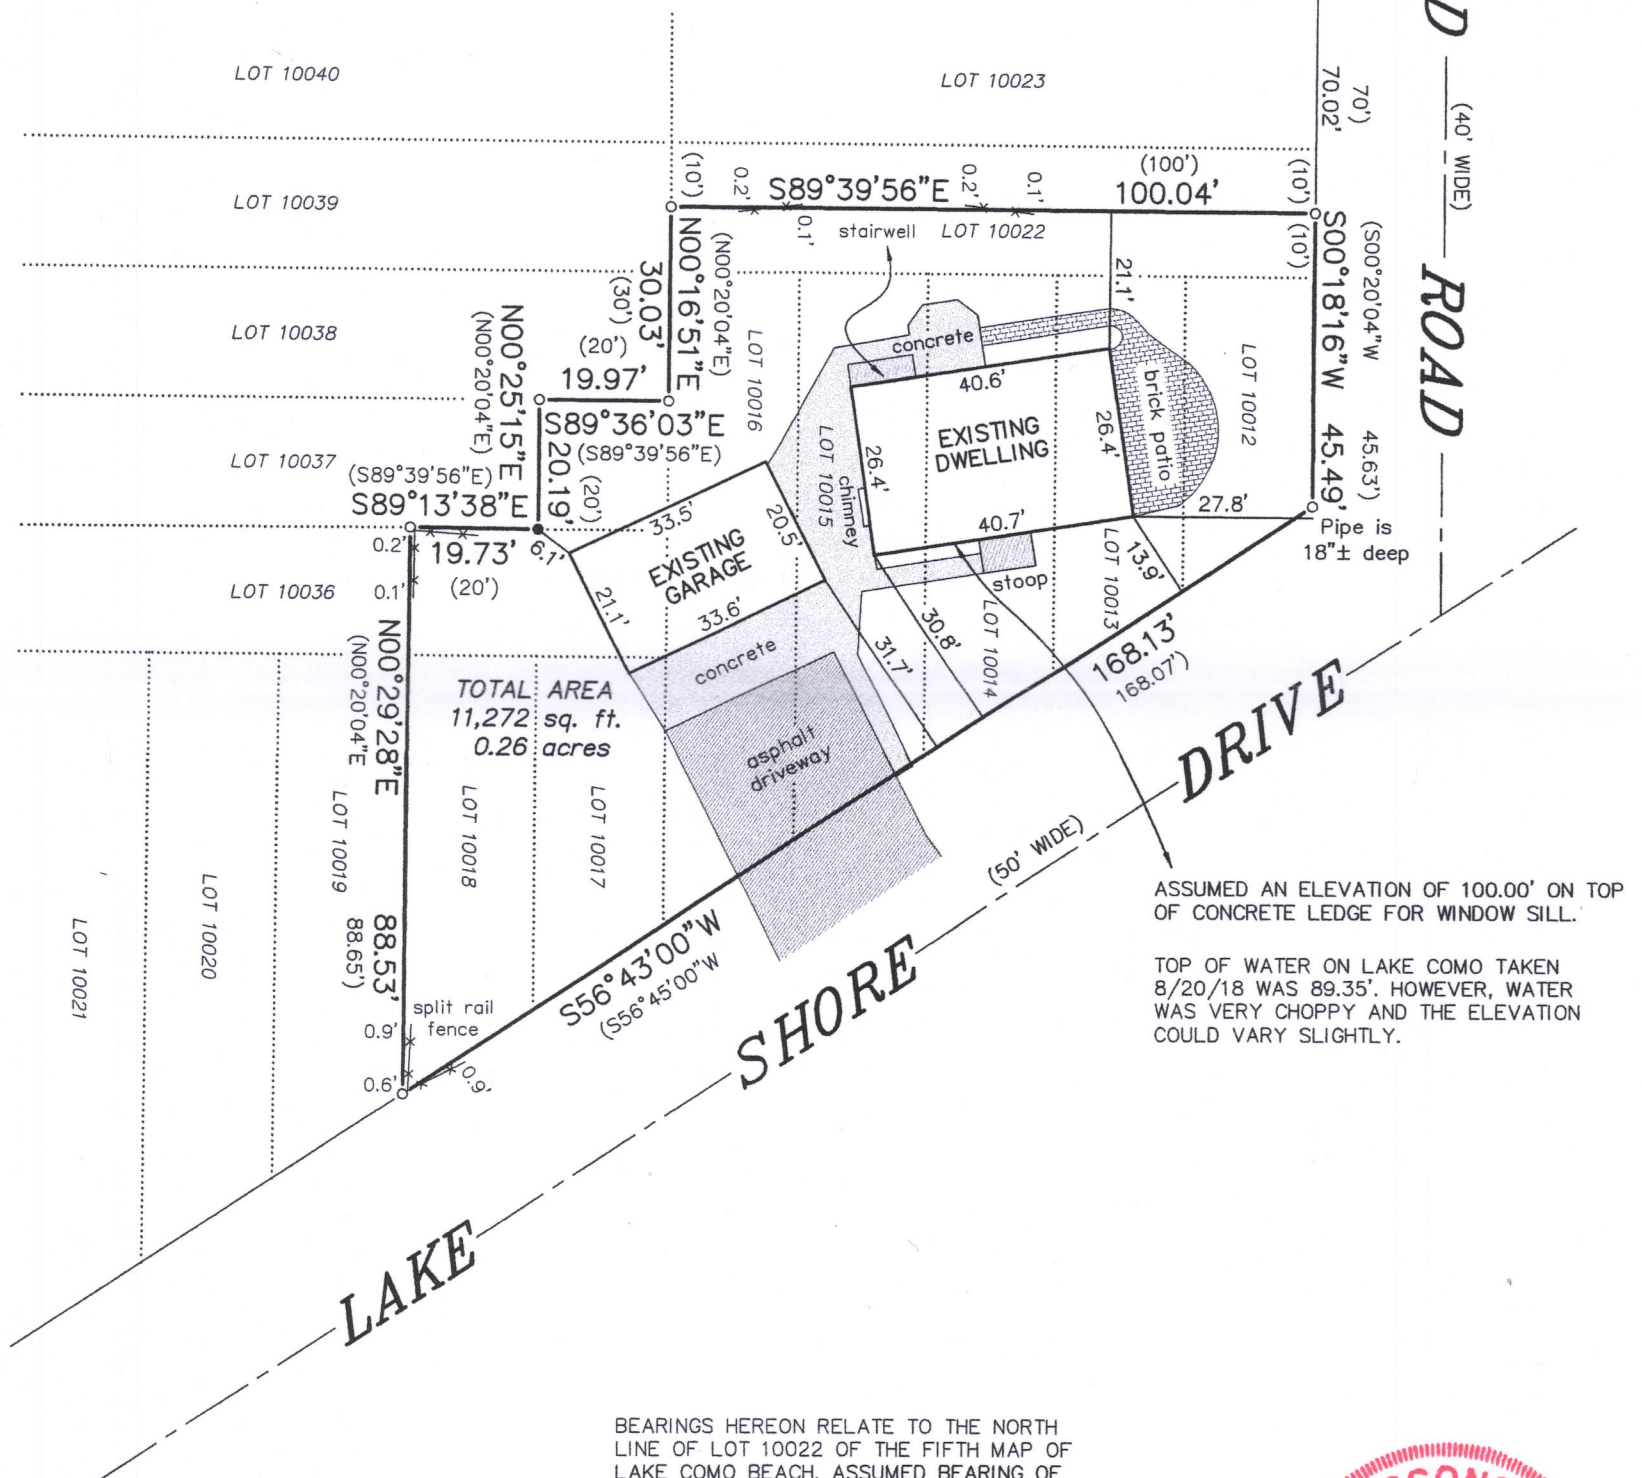

BEARINGS HEREON RELATE TO THE NORTH
LINE OF LOT 10022 OF THE FIFTH MAP OF
LAKE COMO BEACH. ASSUMED BEARING OF
SOUTH 89°39'56" EAST AS PLATTED.

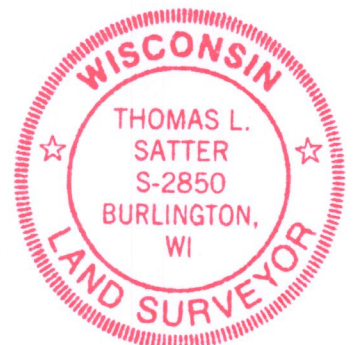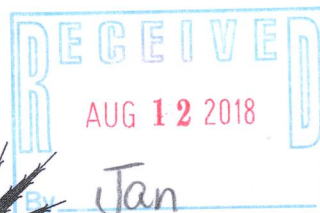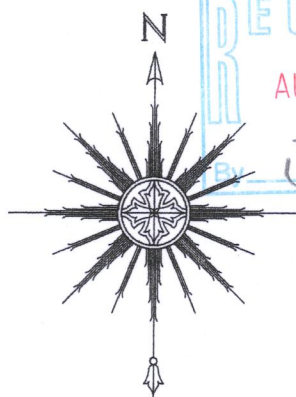

"I HEREBY CERTIFY THAT I HAVE SURVEYED THE ABOVE DESCRIBED PROPERTY AND THAT THE ABOVE MAP IS A CORRECT REPRESENTATION THEREOF AND SHOWS THE SIZE AND LOCATION OF THE PROPERTY, ITS EXTERIOR BOUNDARIES, THE LOCATION OF ALL VISIBLE STRUCTURES AND DIMENSIONS OF ALL PRINCIPAL BUILDINGS THEREON, BOUNDARY FENCES, APPARENT EASEMENTS, ROADWAYS AND ENCROACHMENTS, IF ANY."

"THIS SURVEY IS MADE FOR THE USE OF THE PRESENT OWNERS OF THE PROPERTY, AND THOSE WHO PURCHASE, MORTGAGE, OR GUARANTEE THE TITLE THERETO WITHIN ONE YEAR FROM DATE HEREOF."

THIS IS NOT AN ORIGINAL PRINT
UNLESS THIS SEAL IS RED.

Thomas L. Satter
THOMAS L. SATTER S-2850

SATTER SURVEYING, LLC
LAND SURVEYS, MAPPING AND PLANNING
272 ORIGEN STREET
BURLINGTON, WI 53105
262-661-4239

0 15' 30' 60'

SCALE: 1" = 30'

AUGUST 22, 2018
DATE

071809

JOB NUMBER

JLCB-2159A

217-4481