


HAROLD H. KOLB

REGISTERED PROFESSIONAL LAND SURVEYOR

LAKE GENEVA, WISCONSIN

WASHINGTON DRIVE

40' WIDE

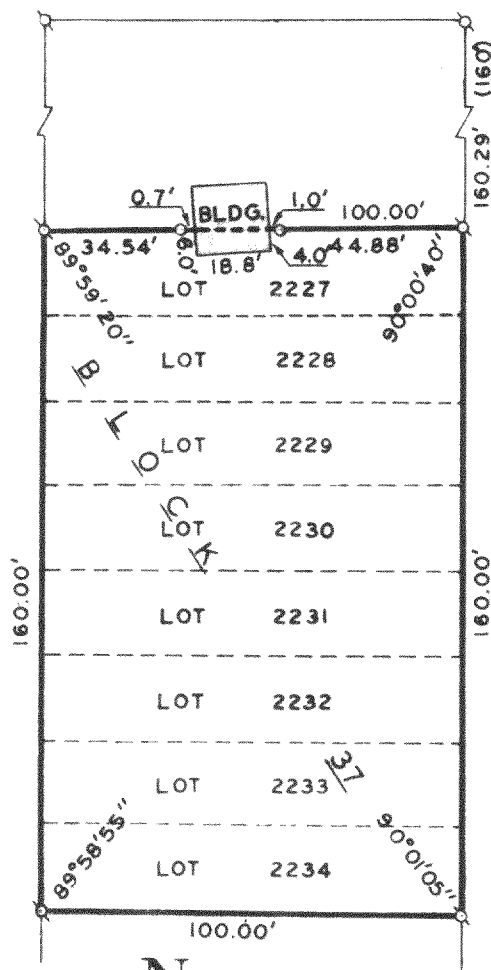

PLAT OF SURVEY OF

LOTS 2227-2234, BLOCK 37, LAKE
COMO BEACH SUBDIVISION, T2N,
R17E, WALWORTH COUNTY, WISCONSIN.


ACCURACY: DISTANCES $\pm 0.01'$
ANGLES $\pm 05''$
ERROR OF CLOSURE
LESS THAN $1/3000$

OWNER: HUGO FRUEHAUF

NOTE: ALL IRON PIPE FOUND ARE
WITHIN .04' AS SHOWN.

N
SCALE 1"=30'
LEGEND

- φ — IRON PIPE FOUND
- — IRON PIPE PLACED
- — CONCRETE MONUMENT
- x — SPIKE
- () — AS PLATTED

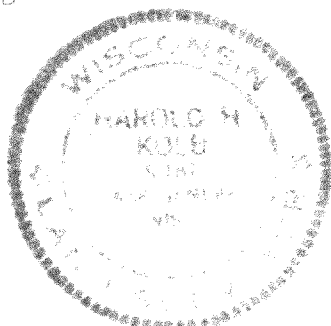

I, HAROLD H. KOLB, DO HEREBY CERTIFY THAT I HAVE
SURVEYED THE PROPERTY HEREON DESCRIBED ACCORDING
TO THE OFFICIAL RECORDS, AND THAT THE PLAT HEREON
IS A CORRECT REPRESENTATION OF THE LOT LINES.

Harold H. Kolb
HAROLD H. KOLB
WISCONSIN REGISTERED LAND SURVEYOR, S-187
DATE *May 31, 1975*

JLCB-321

217-449