



PREPARED FOR  
JASMIN EKICH

# A DRAWING

- OF -

PARCEL "A" Lots 10723 thru 10727, all inclusive Block 194,  
Lake Como Beach, a Subdivision located in Township 2 North,  
Range 17 East, Walworth County, Wisconsin.

PATHFINDER SURVEYING  
(a NMB Company)  
P.O BOX 322  
LAKE GENEVA, WI. 53147  
WWW.PATHFINDERSURVEYING.NET  
262-248-8303

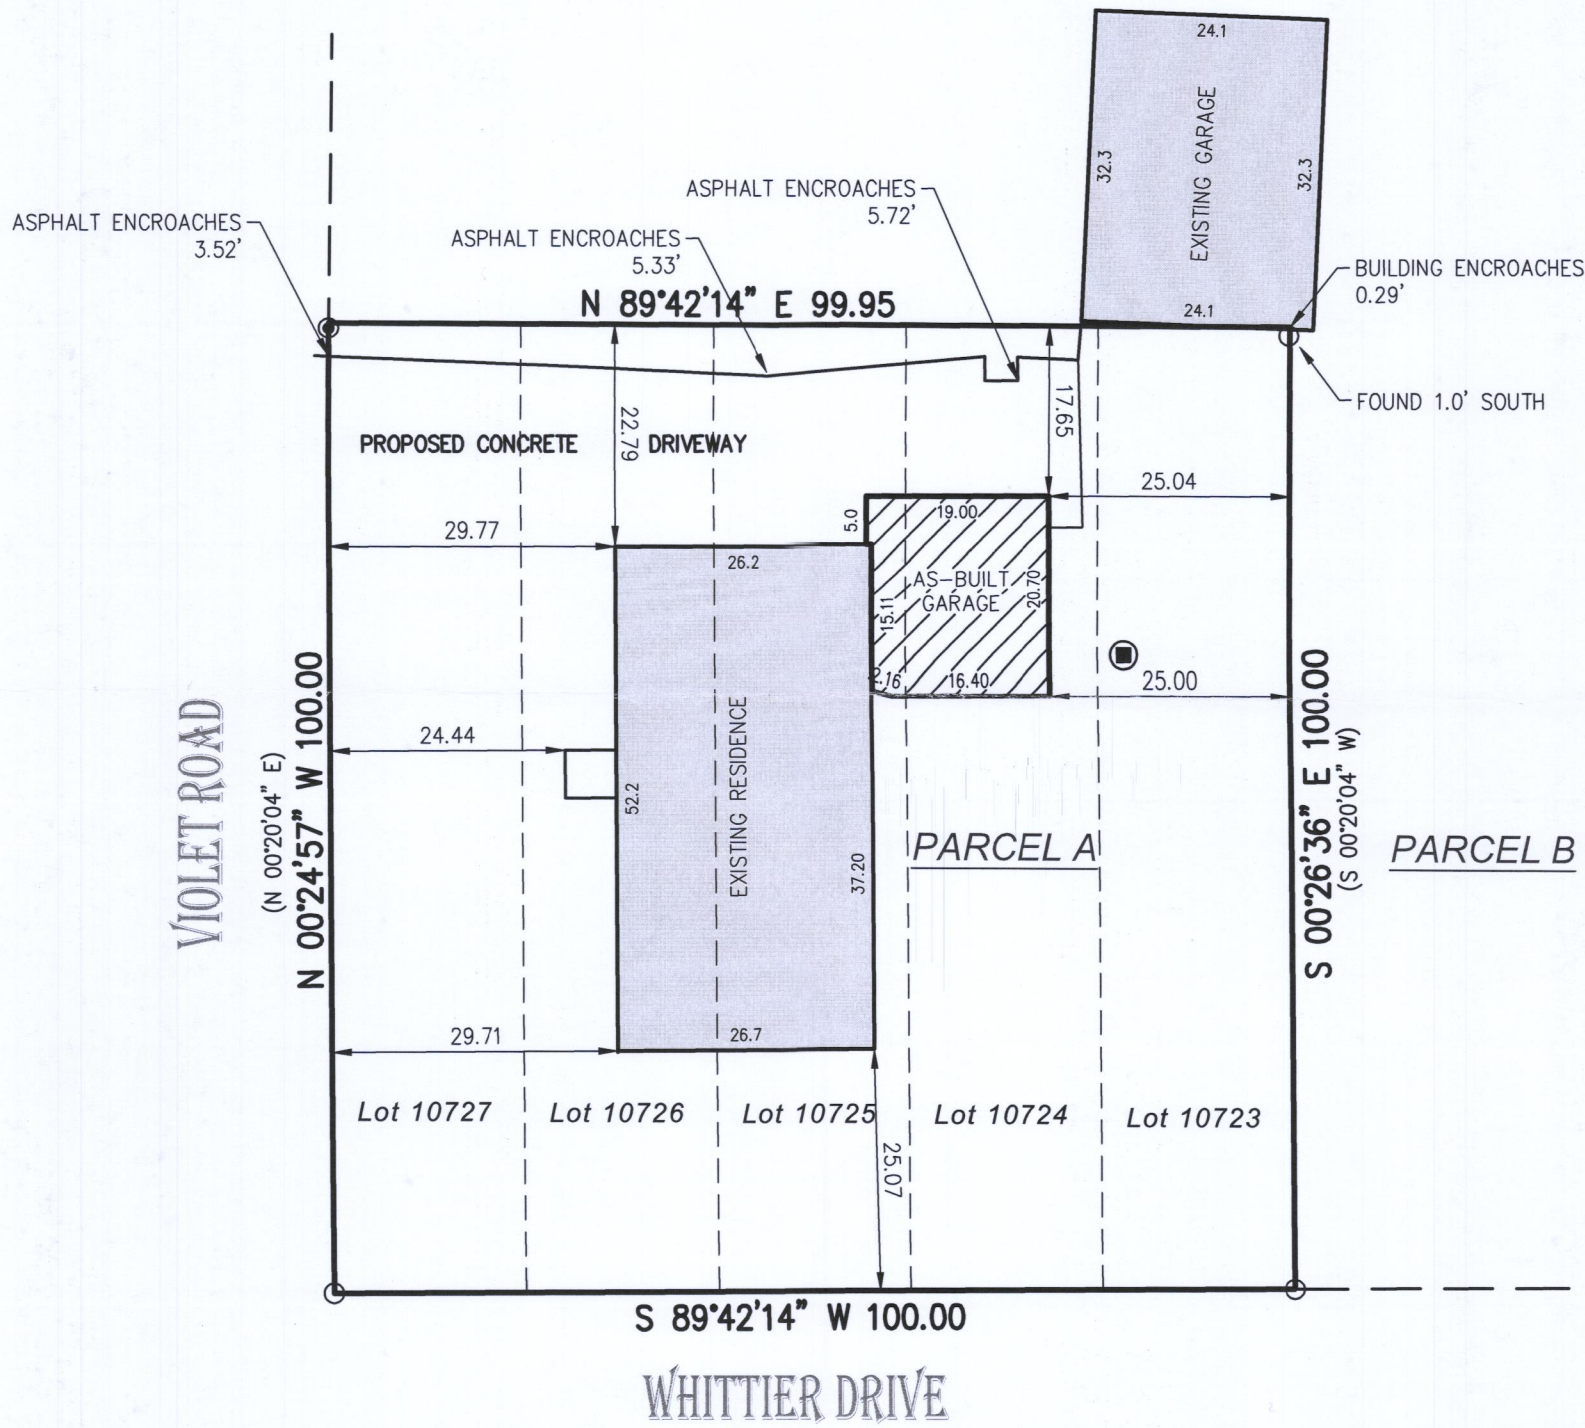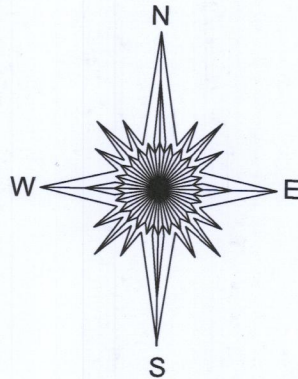

( ) = recorded as

■ = sanitary cover


● = "pk" nail

○ = found iron pipe

SCALE 1" = 20'

JOB # 2018.0023.01

TAX ID # JLCB 02327A

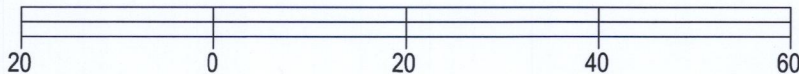


BASIS OF BEARING OF THIS PLAT: THE US STATE PLANE  
COORDINATE SYSTEM SOUTH ZONE, NAD 83. WISCORS.

I hereby certify that I have surveyed the above- described property and the  
above map is a true representation thereof and shows the size and  
location of the property, its exterior boundaries, the location and dimensions  
of all structures thereon, fences, apparent easements and roadways and  
visible encroachments if any to the best of my knowledge and belief.

This survey is made for the present owners of the property, and those who  
purchase, mortgage, or guarantee the title thereto, within one year from the  
date hereof.

DATED THIS 19TH DAY OF SEPTEMBER, 2018.

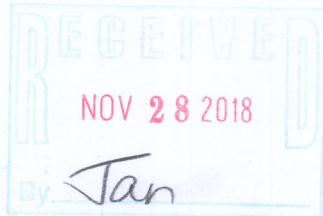

*Mark R. Madsen*  
MARK R. MADSEN S - 2271  
Wisconsin Professional Land Surveyor

JLCB02327A

217-4512