


REGISTERED PROFESSIONAL LAND SURVEYOR
LAKE GENEVA, WISCONSIN

SOUTH 1/4 COR.
OF SEC. 26-2-17

(S 89°19'W) (330.29')

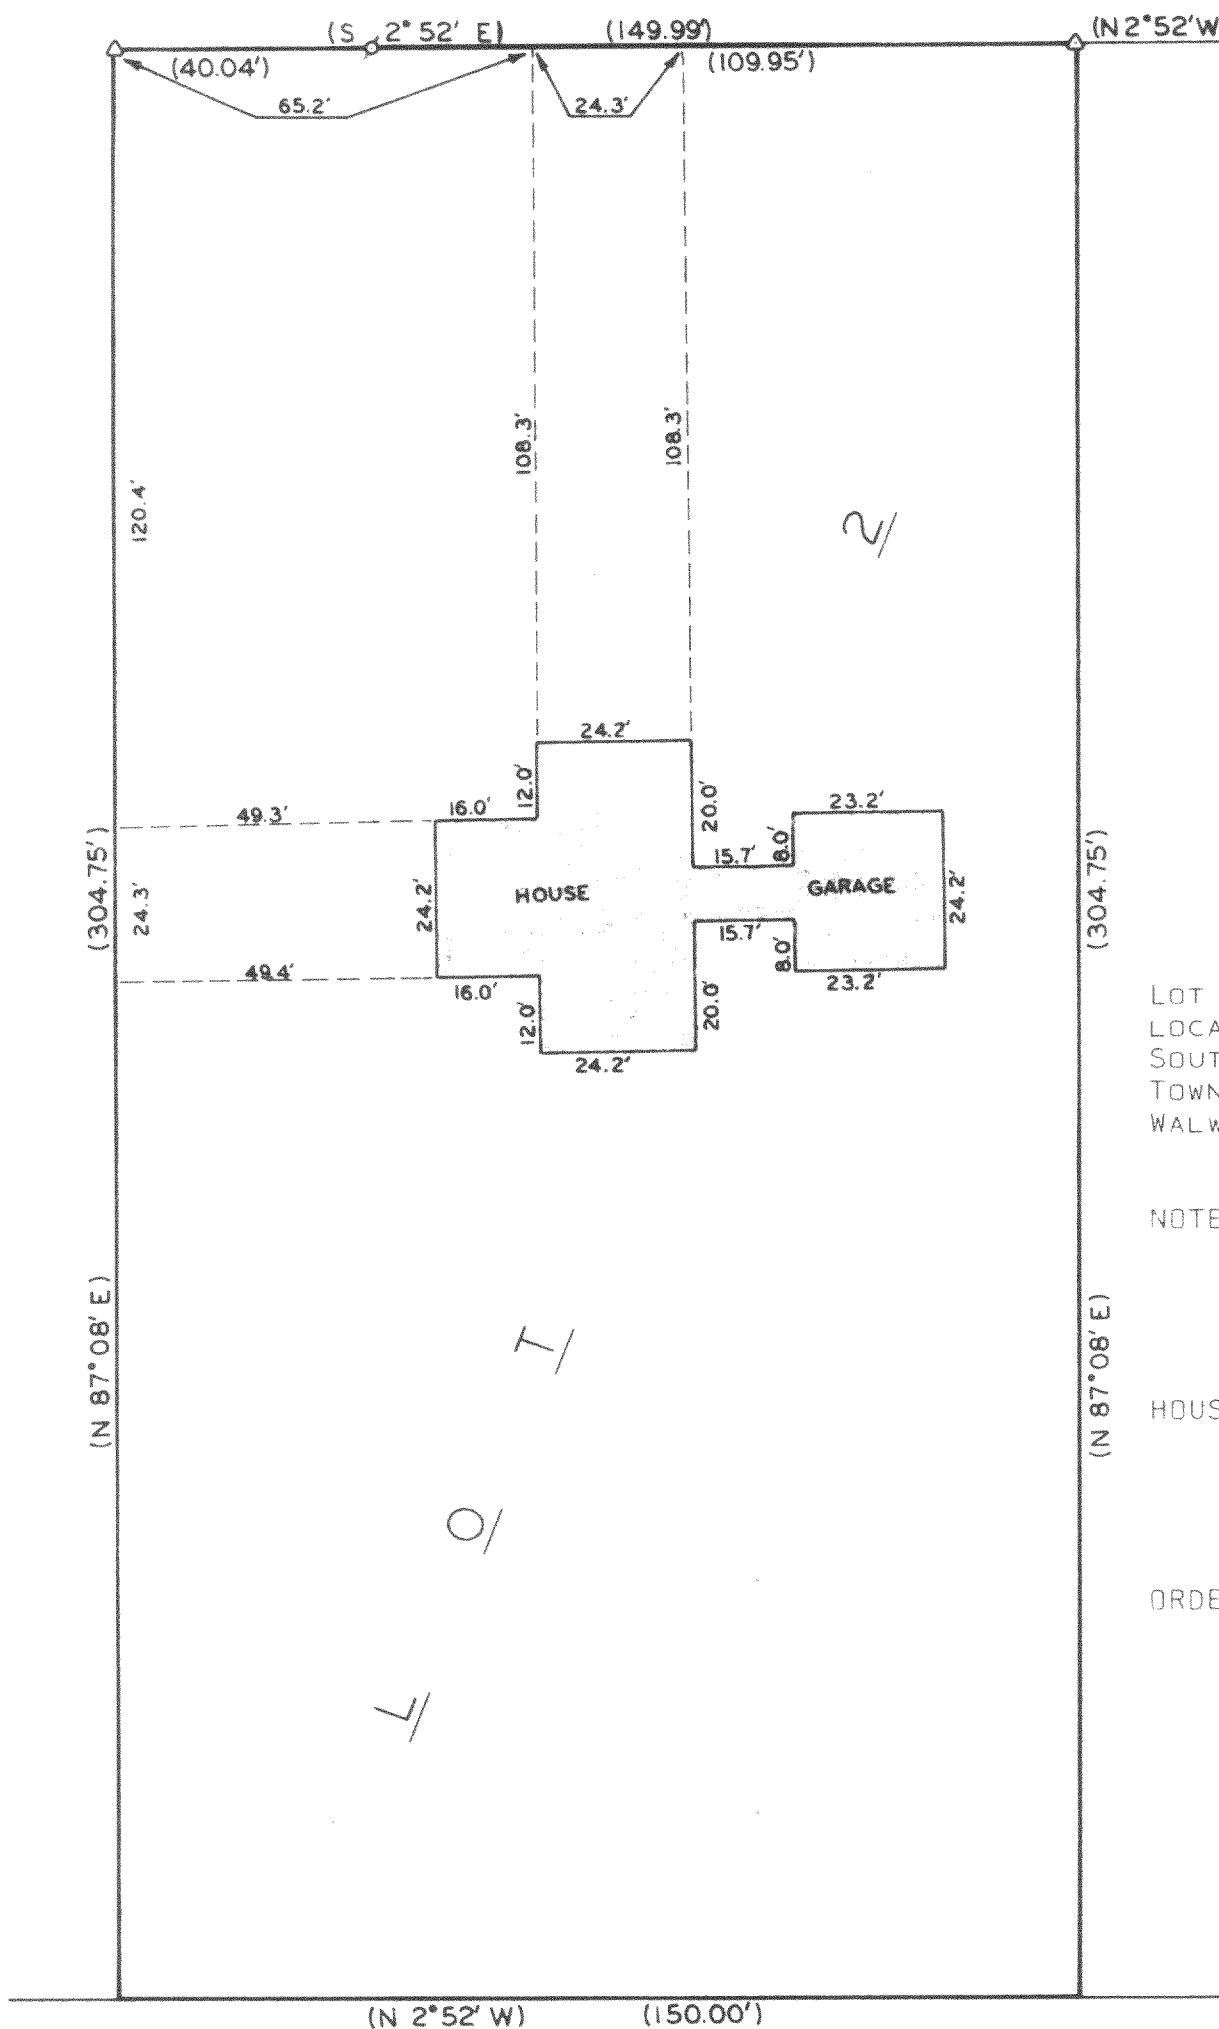

LOT 2 OF CERTIFIED SURVEY MAP NO. 660
LOCATED IN THE SOUTHEAST 1/4 OF THE
SOUTHWEST 1/4 OF SECTION 26,
TOWN 2 NORTH, RANGE 17 EAST,
WALWORTH COUNTY, WISCONSIN.

NOTE: CERTIFIED SURVEY BY:

THOMAS P.A. JENSEN
MARCH 14, 1977


HOUSE LOCATION BY:

KOLB LAND CONSULTING, INC.
SEPTEMBER 6, 1978

ORDERED BY:

M.K.M., INC.
ROUTE 4--GRAND VIEW DRIVE
LAKE GENEVA, WI 53147

MARSHALL STREET - 50' WIDE

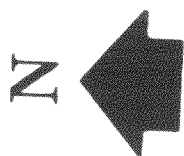

SCALE: 1"=30'
LEGEND

- φ — IRON PIPE FOUND
 ○ — IRON PIPE PLACED
 ● — CONCRETE MONUMENT
 x — SPIKE
 Δ — IRON ROD FOUND
 () — AS PLATTED

Harold H. Kohl

HAROLD H. KOLB
WISCONSIN REGISTERED LAND SURVEYOR, S-187
DATE SEPT. 6, 1978

217-454 K