
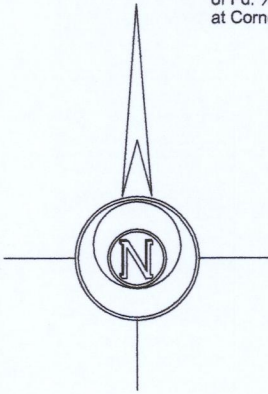


LAND-MARK SURVEYING
Mark L. Miritz
Wisconsin Professional Land Surveyor S-2582

N9330 Knuteson Drive
Whitewater, WI 53190
Phone: (262) 495-3284
MARKMIRITZ@
LAND-MARKSURVEYING.COM

LEGAL DESCRIPTION
LOCATED IN THE NORTHWEST 1/4 OF THE NORTHWEST 1/4, SECTION 26,
TOWNSHIP 2 NORTH, RANGE 17 EAST, IN THE TOWN OF GENEVA, WALWORTH
COUNTY, WISCONSIN
LOTS 10608 THRU 10615 (INCLUSIVE) ALL IN BLOCK 192, LAKE COMO BEACH
FIFTH MAP

PLAT OF SURVEY

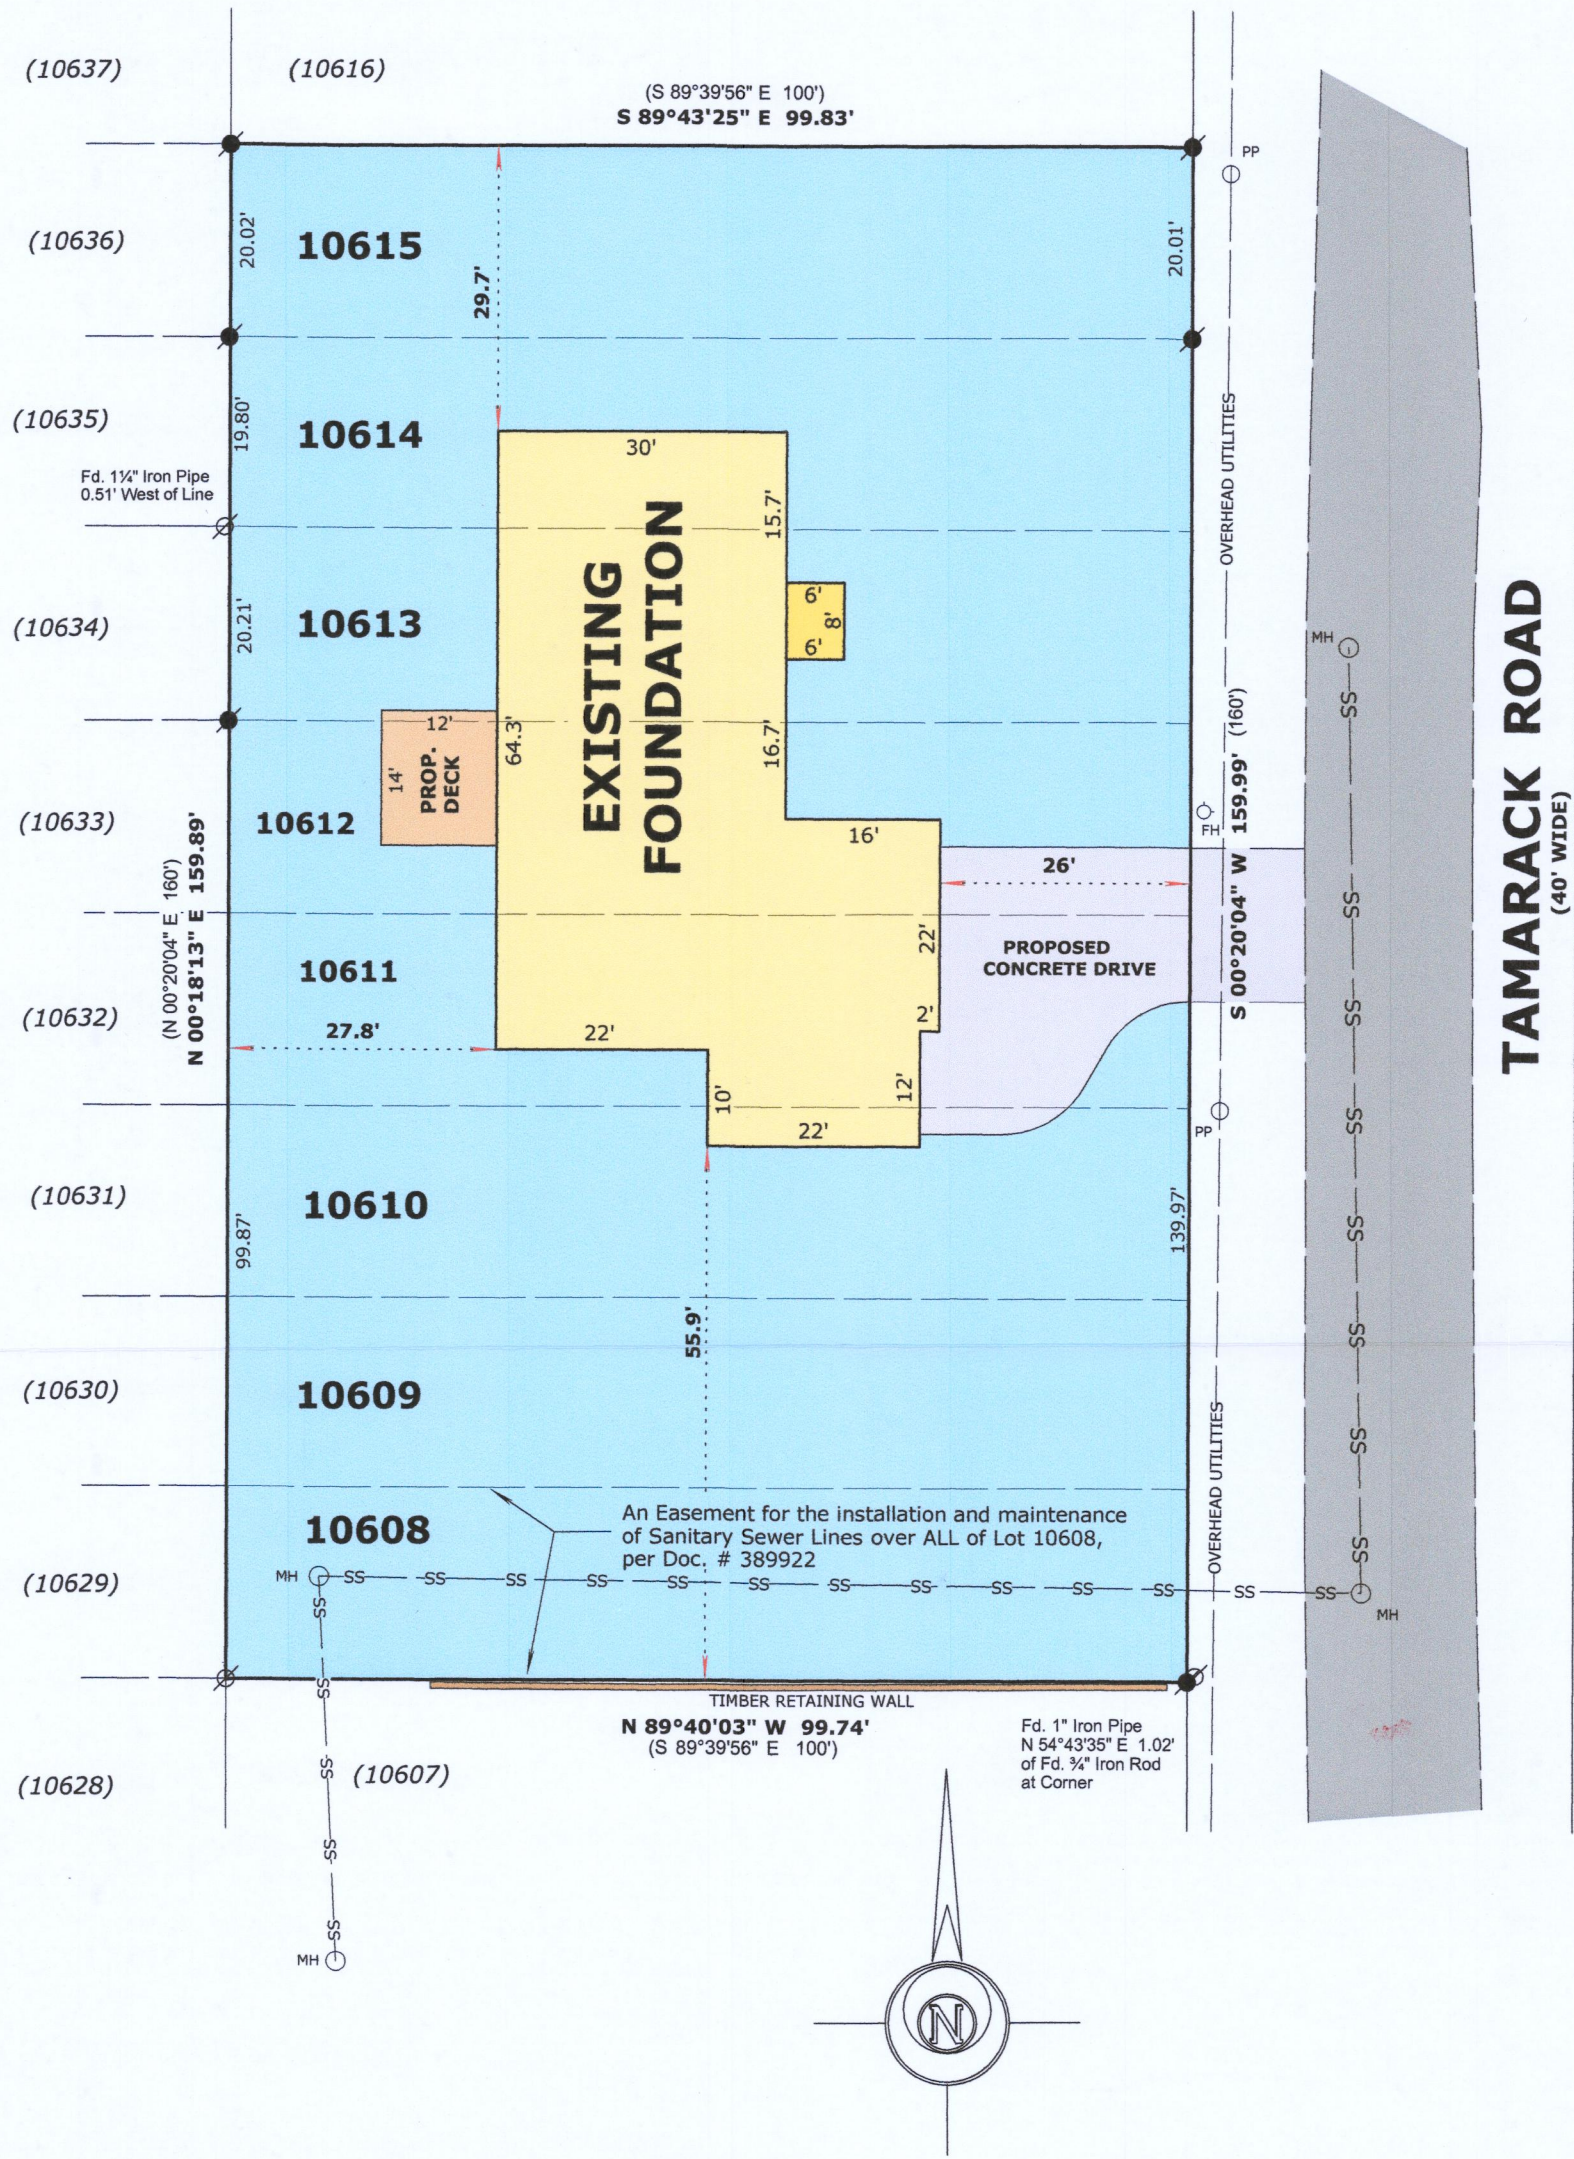

BASIS OF BEARINGS:
THE WEST LINE OF TAMARACK ROAD
BEING S 00°20'04\"/>

ORDERED BY:
BASSO BUILDERS INC.
405 SKYLINE DR.
LAKE GENEVA, WI. 53147

RECEIVED
NOV 25 2019
By *Jan*



- LEGEND
- FOUND IRON PIPE
 - FOUND IRON ROD
 - RECORDED AS DIMENSION

SCALE: 1 INCH = 20 FEET

"I hereby certify that the above described property has been surveyed by me or under my direction and that the above map is a true representation thereof and shows the size and location of the property, its exterior boundaries, the location of all visible structures and dimensions of all principal buildings thereon, boundary fences, apparent easements, roadways and visible encroachments, if any."
"This survey is made for the use of the present owners of the property, and also those who purchase, mortgage, or guarantee the title thereto within one year from date hereof."

Mark L. Miritz
MARK L. MIRITZ
WISCONSIN PROFESSIONAL
LAND SURVEYOR S-2582

REVISED OCT. 18, 2019 TO
SHOW FOUNDATION "AS BUILT"

DATE: August 10, 2019 JOB NO. 19.802

JLCB-02306 217-4600