
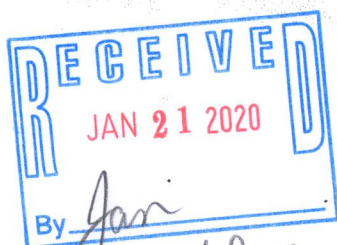


GARY L. MAJEWSKI
REGISTERED LAND SURVEYOR
EAGLE, WISCONSIN

FOR: BOB JOHNSON re: Magic

LEGAL DESCRIPTION: Lot 20, Consumers Company Subdivision and part of old Railroad R/W, description in Vol. 43 of Deeds on page 140 as Document No. 633568, Town of Geneva, Walworth County, Wisconsin.

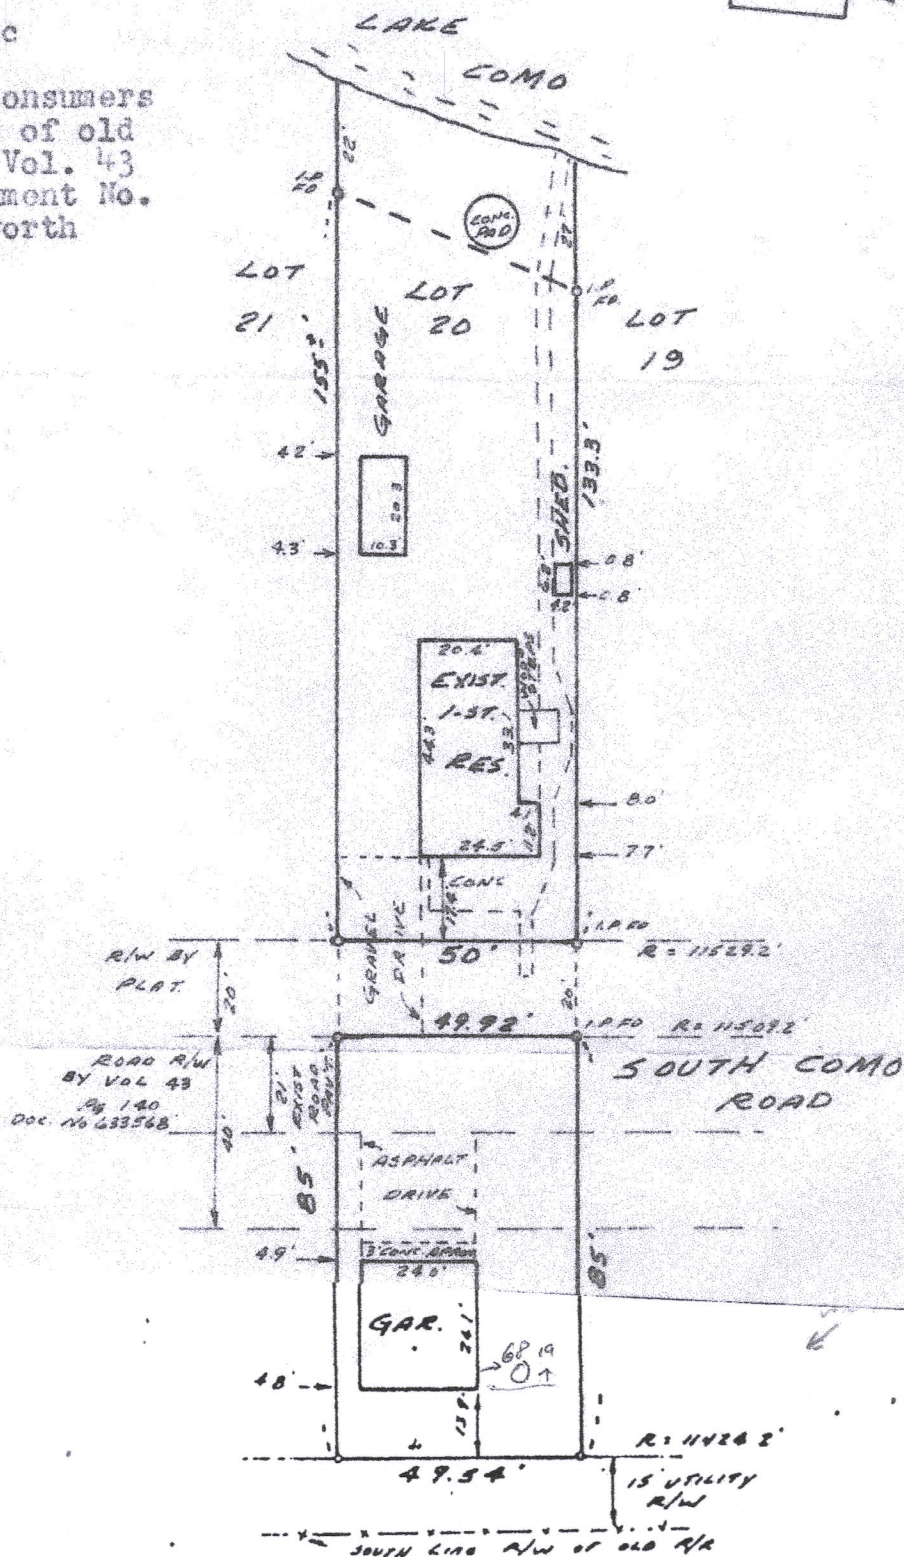

SURVEYOR'S CERTIFICATE

I have surveyed the above described property and the above map is a true representation thereof and shows the size and location of the property, its exterior boundaries, the location and dimensions of all visible structures thereon, fences, apparent easements and roadways and visible encroachments, if any.

This survey is made for the exclusive use of the present owners of the property, and also those who purchase, mortgage, or guarantee the title thereto within one (1) year from date hereof; and as to them I warrant the accuracy of said survey and map.


STATE OF WISCONSIN
COUNTY OF WAUKESHA

I, GARY L. MAJEWSKI, DO HEREBY CERTIFY THAT I HAVE MADE THIS SURVEY AND THAT THE INFORMATION SHOWN ON THE ABOVE PLAT OF SURVEY IS A CORRECT REPRESENTATION THEREOF.

Revised October 11, 1979

DATED THIS 21th DAY OF September 19 79

PLAT NO. GENEVA 2 BOOK Wal. Co. 1 PAGE 13

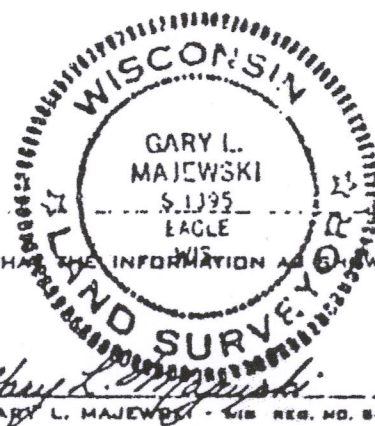

JCON-6 217-4617