

LAND-MARK SURVEYING

Mark L. Miritz

Wisconsin Professional Land Surveyor S-2582

N9330 Knuteson Drive
Whitewater, WI 53190
Phone: (262) 495-3284

MARKMIRITZ@
LAND-MARKSURVEYING.COM

PLAT OF SURVEY

LEGAL DESCRIPTION

Located in the Northeast 1/4 of the Southeast 1/4, Section 29, Township 2 North, Range 17 East, in the Town of Geneva, Walworth County, WI.


Lots 11377 thru 11380 (inclusive), Block 205, Lake Como Beach Fifth Map

OWNER:

Joseph A. Kumprey
Diane M. Kumprey
N8778 Wilmers Point Lane
East Troy, WI. 53120

APRICOT RD.

WILLOW RD.
(40' WIDE)

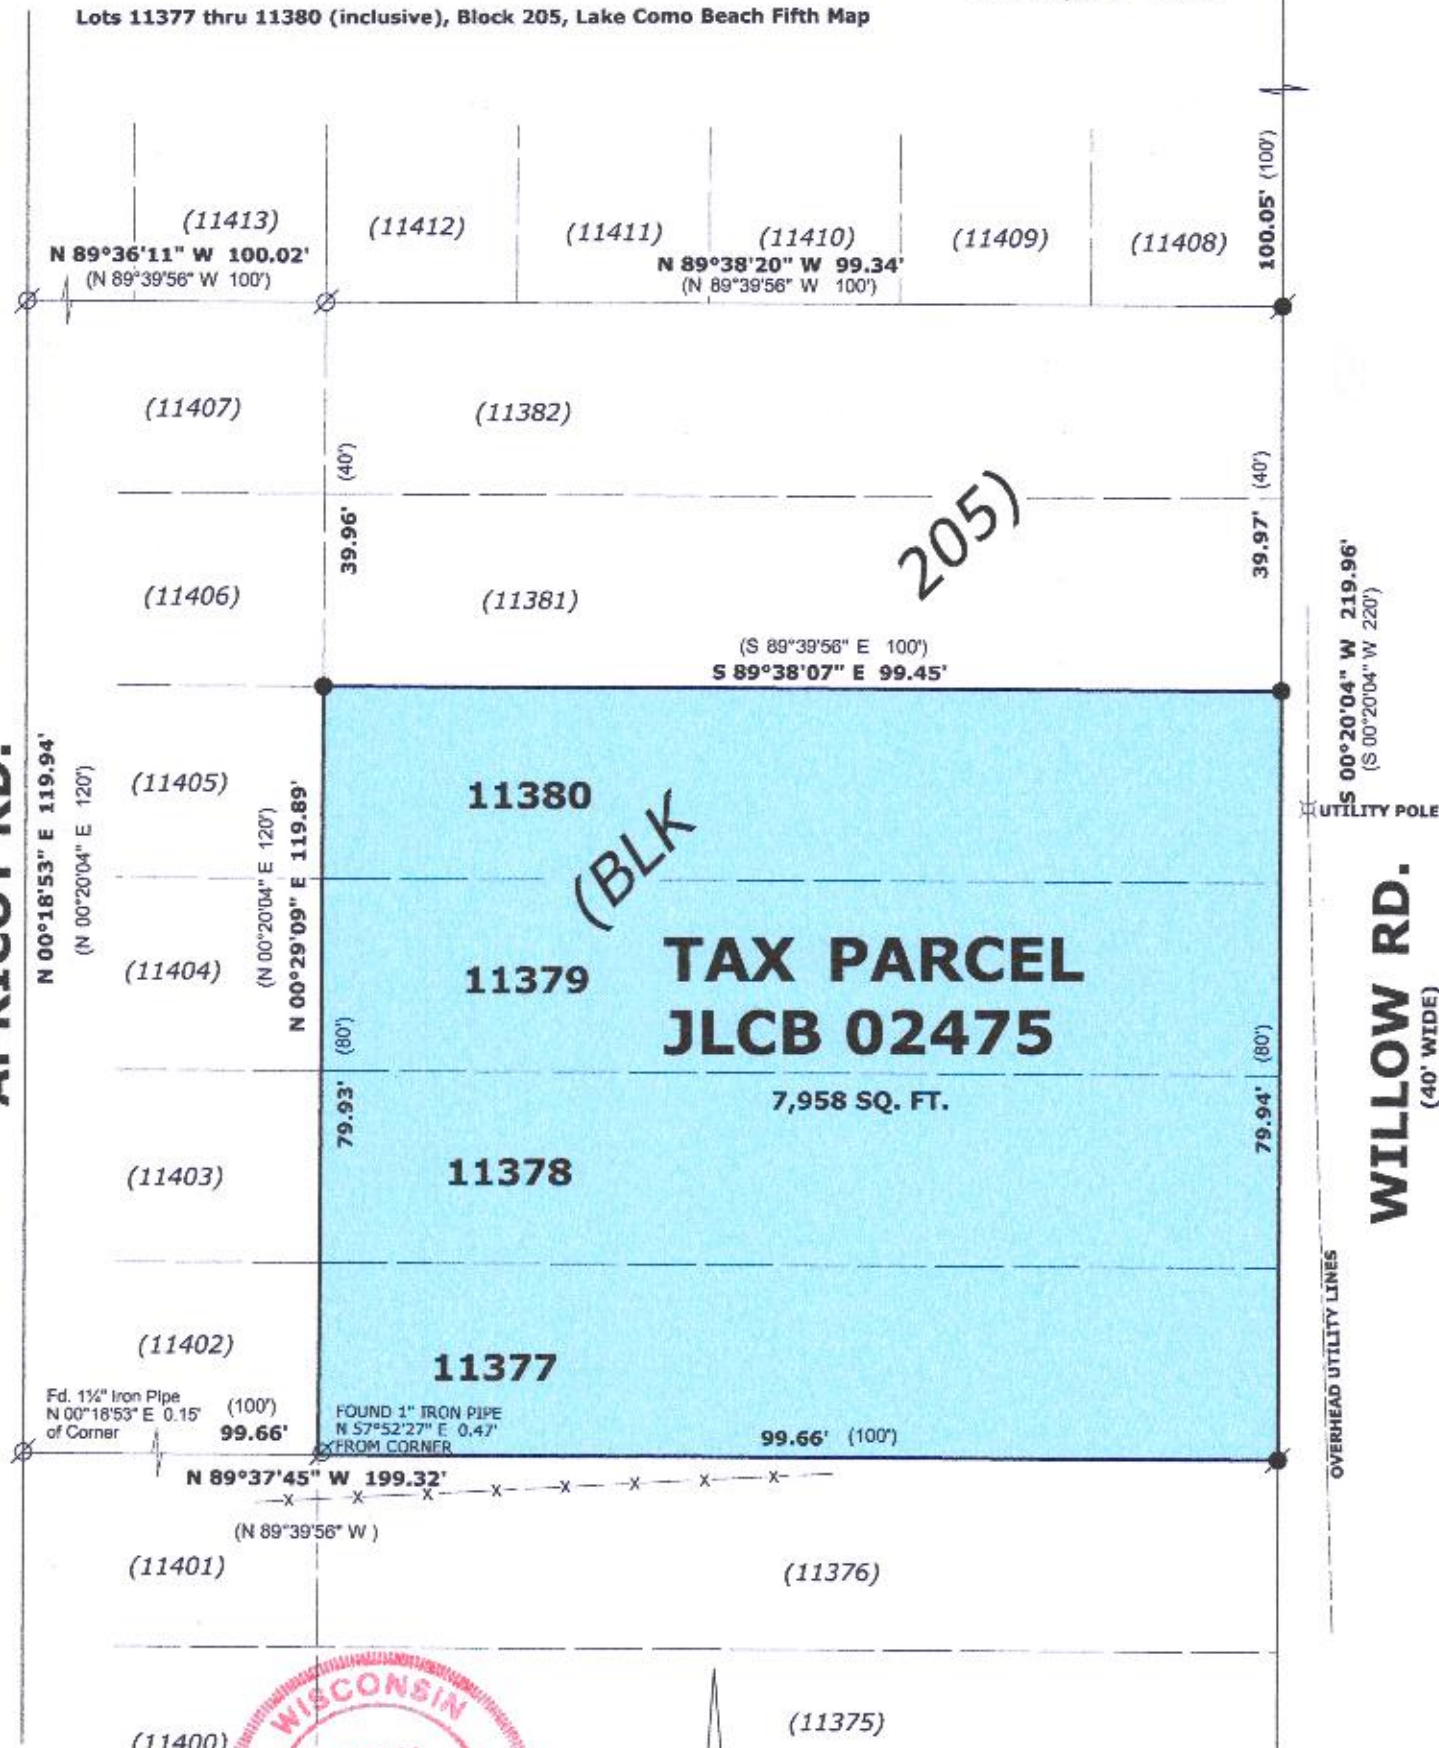

LEGEND

- FOUND IRON PIPE
- FOUND IRON ROD
- SET IRON ROD, 18" LONG, WEIGHING 1.5 LBS./LINEAL FT., 3/4" DIA.
- RECORDED AS DIMENSION
- EXISTING FENCE



Basis of Bearings:
The West Line of Willow Rd.
Being S 00° 20' 04" W



SCALE: 1 INCH = 20 FEET

"I hereby certify that the above described property has been surveyed by me or under my direction and that the above map is a true representation thereof and shows the size and location of the property, its exterior boundaries, the location of all visible structures and dimensions of all principal buildings thereon, boundary fences, apparent easements, roadways and visible encroachments, if any."
"This survey is made for the use of the present owners of the property, and also those who purchase, mortgage, or guarantee the title thereto within one year from date hereof."

Mark L. Miritz
MARK L. MIRITZ
WISCONSIN PROFESSIONAL
LAND SURVEYOR S-2582

DATE: April 11, 2020 JOB NO. 20.403

JLCB-2472

217-4633