

LAND-MARK SURVEYING

Mark L. Miritz
Wisconsin Professional Land Surveyor S-2582



N9330 Knuteson Drive
Whitewater, WI 53190
Phone: (262) 495-3284
MARKMIRITZ@
LAND-MARKSURVEYING.COM

PLAT OF SURVEY

LEGAL DESCRIPTION:

LOCATED IN THE SOUTHEAST 1/4 OF THE NORTHWEST 1/4, SECTION 26,
TOWNSHIP 2 NORTH, RANGE 17 EAST, IN THE TOWN OF GENEVA, WALWORTH
COUNTY, WISCONSIN

LOT 1, BLOCK 2, HAWTHORNE HILLS SUBDIVISION

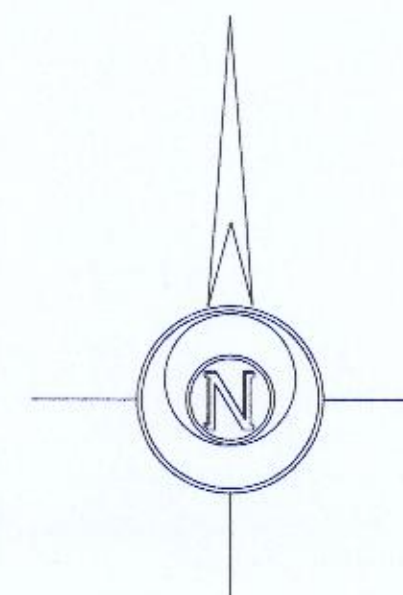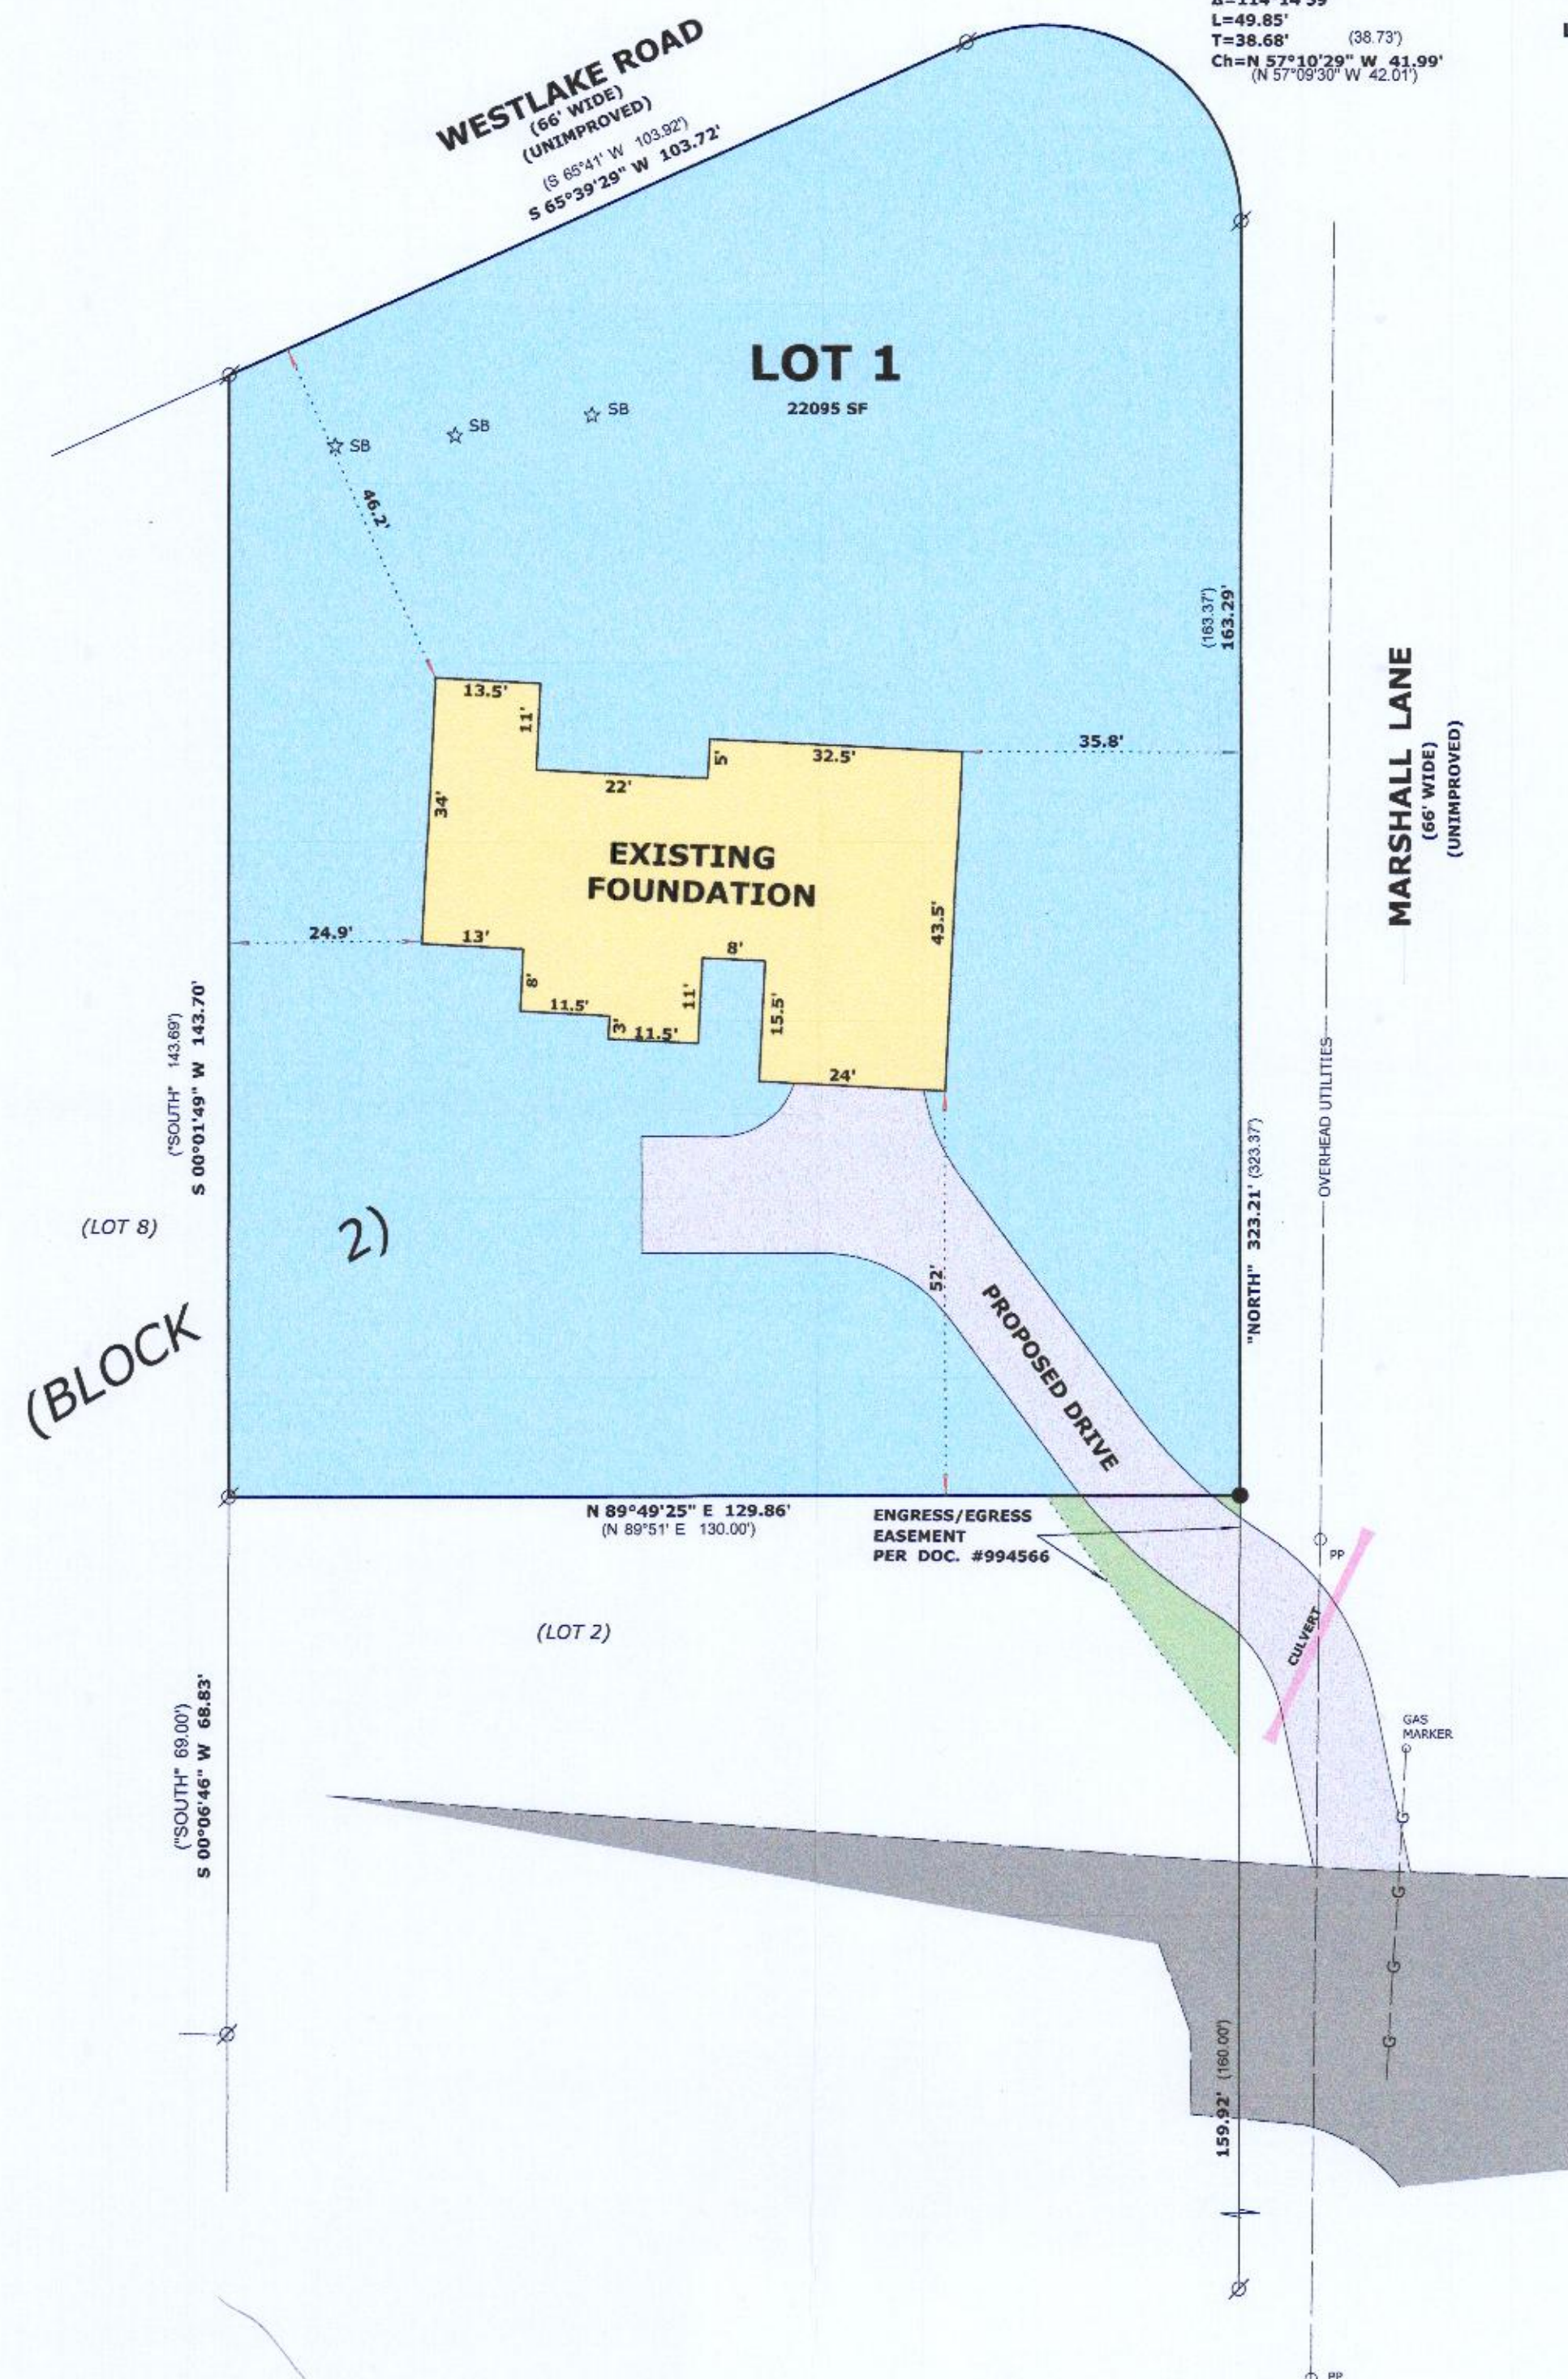

BASIS OF BEARINGS:
The West Line of Marshall Lane
Being "NORTH"

VERTICAL DATUM
To adjust elevations shown to the 1983 Vertical Datum
Add 114.00 feet to all elevations shown.

OWNER:
JOEL LAZZARONI
N4236 COUNTY RD. NN
ELKHORN, WI. 53121



LEGEND

- FOUND IRON PIPE
- SET IRON ROD, 18" LONG, WEIGHING 1.5 LBS./LINEAL FT., 3/4" DIA.
- (X X) RECORDED AS DIMENSION

SCALE: 1 INCH= 20 FEET

"I hereby certify that the above described property has been surveyed by me or under my direction and that the above map is a true representation thereof and shows the size and location of the property, its exterior boundaries, the location of all visible structures and dimensions of all principal buildings thereon, boundary fences, apparent easements, roadways and visible encroachments, if any."
"This survey is made for the use of the present owners of the property, and also those who purchase, mortgage, or guarantee the title thereto within one year from date hereof."

Mark L. Miritz
MARK L. MIRITZ
WISCONSIN PROFESSIONAL
LAND SURVEYOR S-2582

REVISED DEC. 23, 2019 TO SHOW
FOUNDATION "AS BUILT"

DATE: September 12, 2019 JOB NO. 19.812

JHH-9

217-4638