

LAND-MARK SURVEYING

Mark L. Miritz
Wisconsin Professional Land Surveyor S-2582

N9330 Knuteson Drive
Whitewater, WI 53190
Phone: (262) 495-3284
MARKMIRITZ@
LAND-MARKSURVEYING.COM

PLAT OF SURVEY

LEGAL DESCRIPTION

JLCB02448

LOCATED IN THE NORTHEAST 1/4 OF SECTION 29, TOWN 2 NORTH,
RANGE 17 EAST, TOWN OF GENEVA, WALWORTH COUNTY,
WISCONSIN.

LOTS 11254-11258 INCLUSIVE AND LOTS 11225-11229 INCLUSIVE
OF BLOCK 202 OF LAKE COMO BEACH SUBDIVISION

JLCB02443

LOCATED IN THE NORTHEAST 1/4 OF SECTION 29, TOWN 2 NORTH,
RANGE 17 EAST, TOWN OF GENEVA, WALWORTH COUNTY,
WISCONSIN.

LOTS 11249-11253 INCLUSIVE AND LOTS 11220-11224 INCLUSIVE
OF BLOCK 202 OF LAKE COMO BEACH SUBDIVISION


WILLOW ROAD

(40' WIDE)
(UNIMPROVED ROAD)

VIOLET ROAD

(40' WIDE)

Basis of Bearings:
The West line of Violet Road
Being S 00°20'04" W

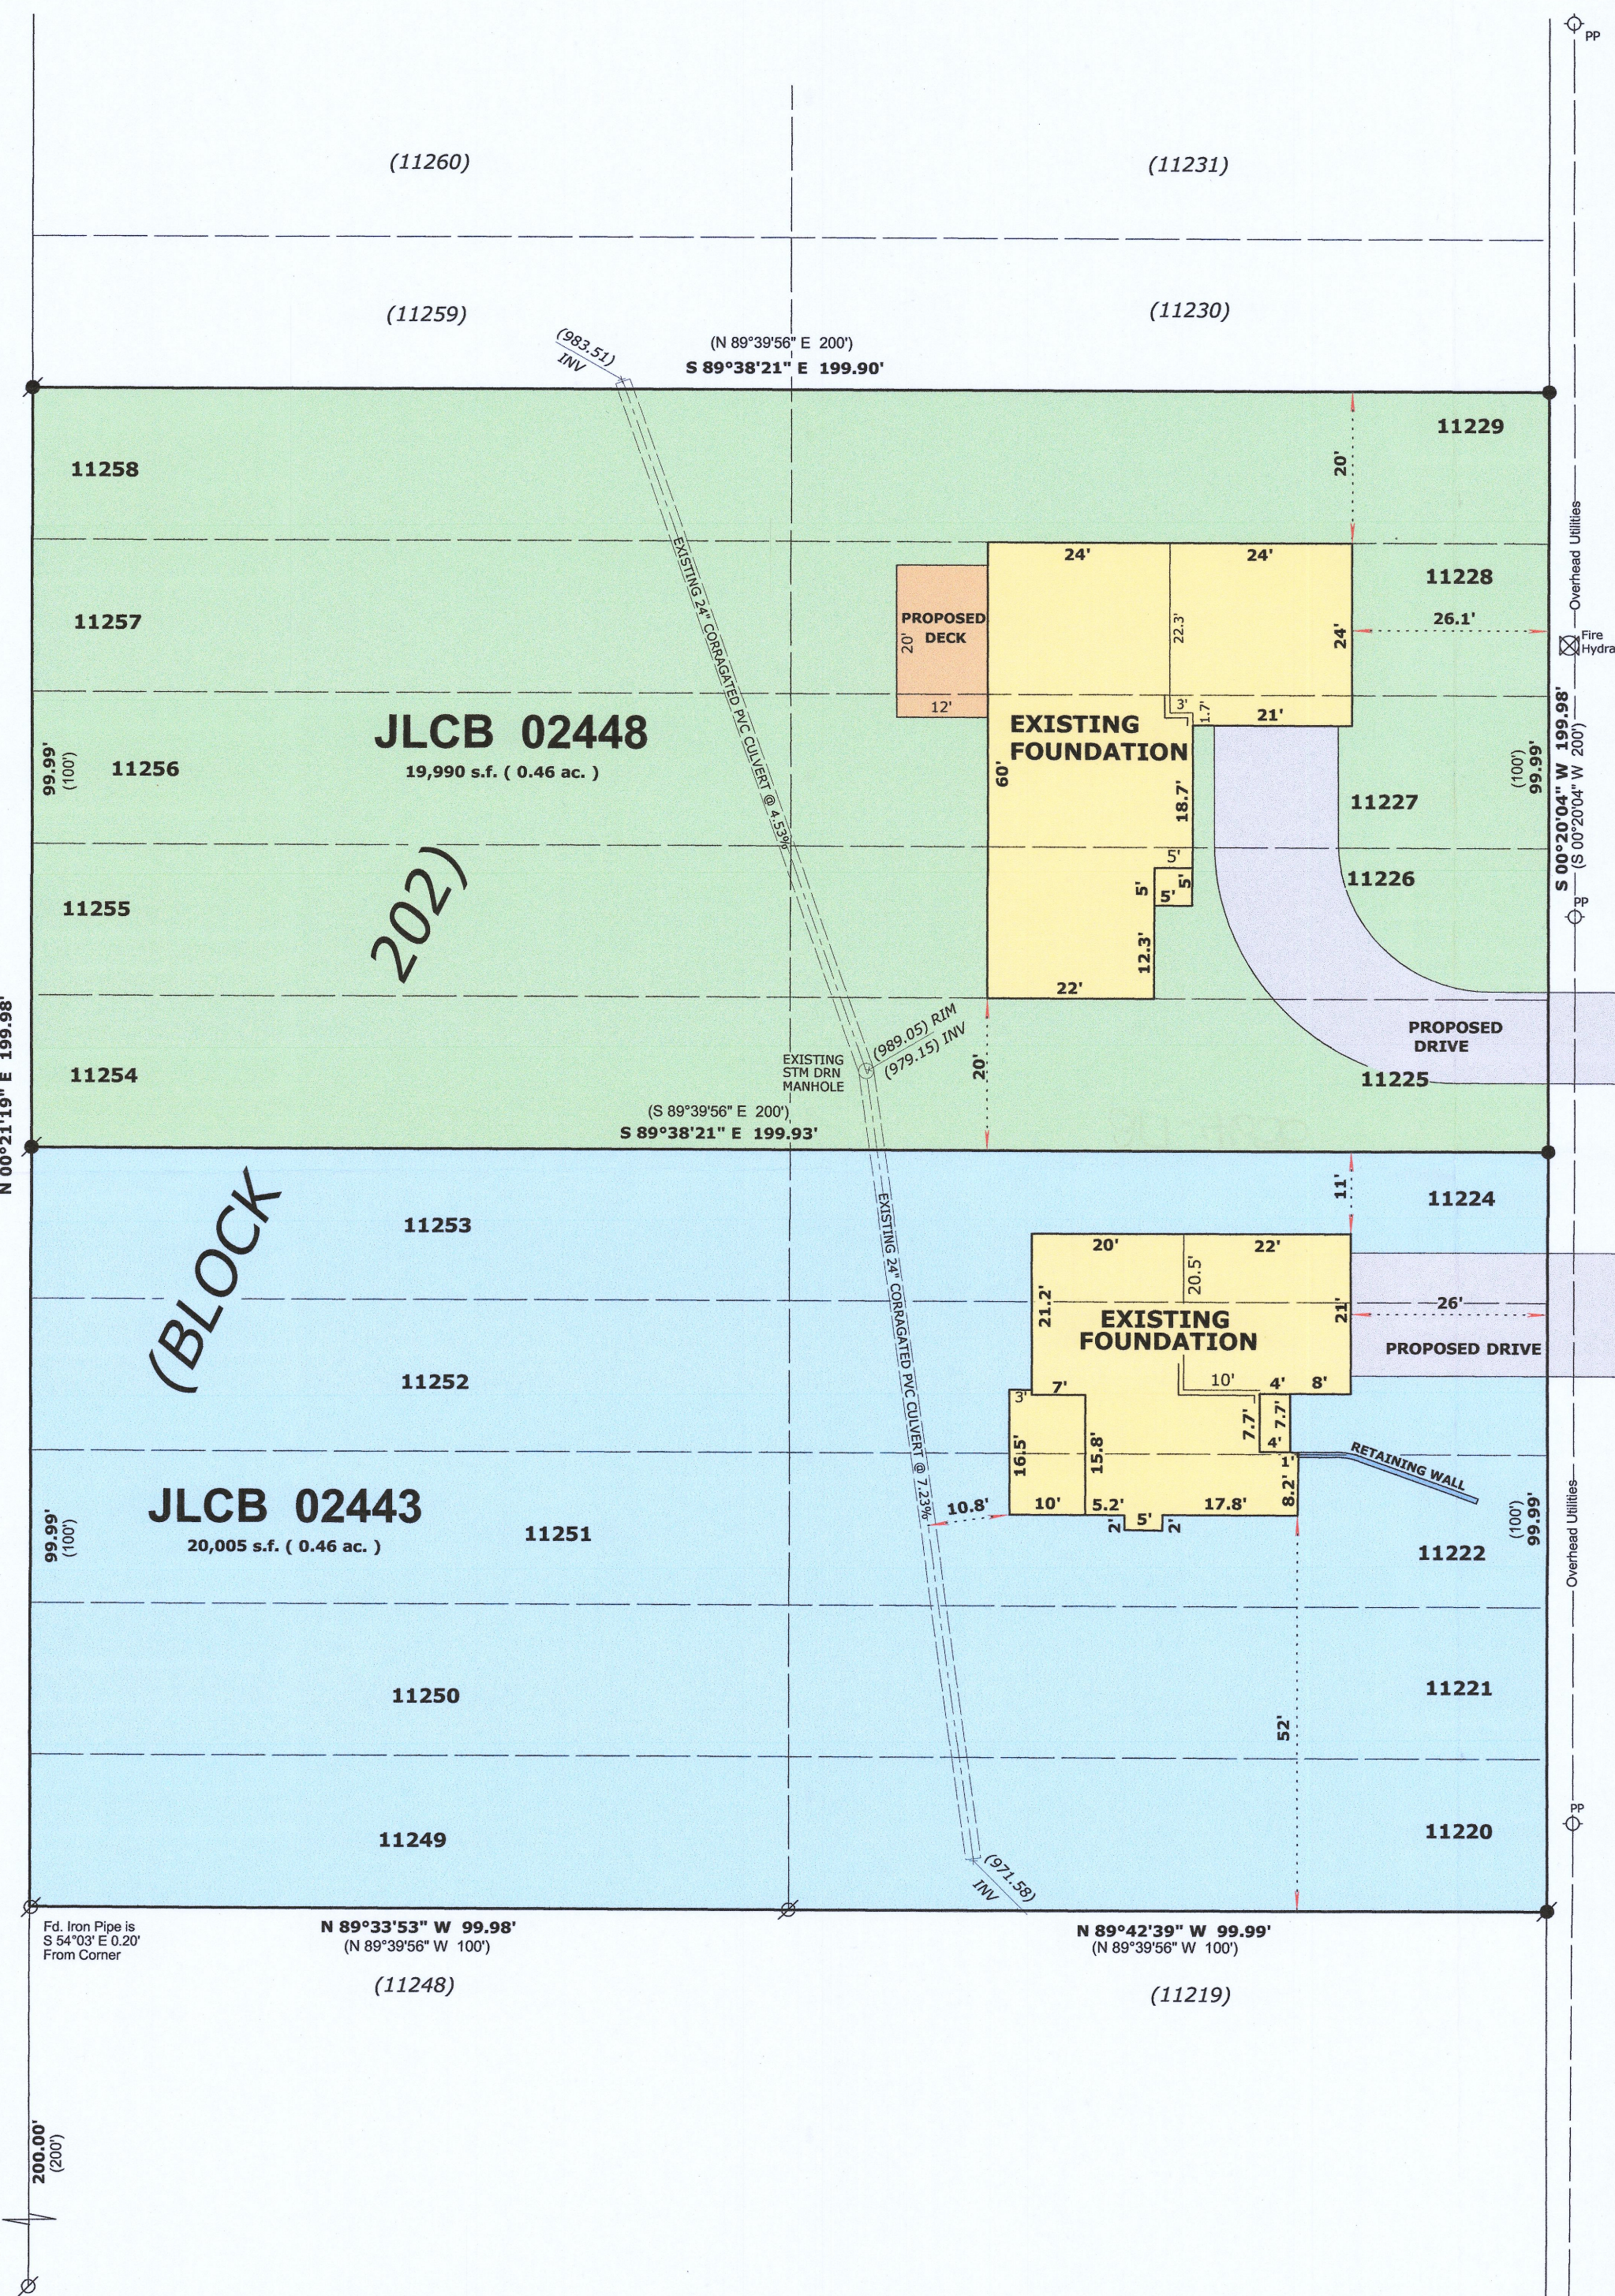

OWNER: BASSO BUILDERS, INC.
405 SKYLINE RD.
LAKE GENEVA, WI. 53147

LEGEND

- FOUND IRON PIPE
- FOUND IRON ROD
- SET IRON ROD, 18" LONG, WEIGHING
1.5 LBS./LINEAL FT., 3/4" DIA.
- RECORDED AS DIMENSION


SCALE: 1 INCH= 20 FEET

"I hereby certify that the above described property has
been surveyed by me or under my direction and that the
above map is a true representation thereof and shows the
size and location of the property, its exterior boundaries,
the location of all visible structures and dimensions of all
principal buildings thereon, boundary fences, apparent
easements, roadways and visible encroachments, if any."
This survey is made for the use of the present owners of
the property, and also those who purchase, mortgage, or
guarantee the title thereto within one year from date
hereof."

Mark L. Miritz
MARK L. MIRITZ
S-2582
WISCONSIN PROFESSIONAL
LAND SURVEYOR S-2582

REVISED JUNE 24, 2020 TO SHOW
FOUNDATIONS "AS BUILT"

DATE: November 30, 2019 JOB NO. 19.1001
19.1006

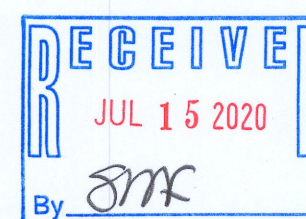

JLCB-2443 JLCB-2448

217-4655