


PLAT OF SURVEY
-OF-

BEARINGS HEREON RELATE TO THE SOUTH LINE OF BLOCK 133 OF LAKE COMO BEACH SUBDIVISION, ASSUMED BEARING OF SOUTH 89°39'56" EAST AS PLATTED.


LOTS 7847-7851 IN BLOCK 134 OF "LAKE COMO BEACH", ACCORDING TO THE RECORDED PLAT THEREOF. SAID LAND BEING IN THE TOWN OF GENEVA, COUNTY OF WALWORTH AND STATE OF WISCONSIN.

SURVEY FOR: ANTHONY SQUEO

NOTE: REFER TO A CURRENT TITLE REPORT FOR EASEMENTS, RESTRICTIONS OR COVENANTS WHICH MAY AFFECT THIS PROPERTY.

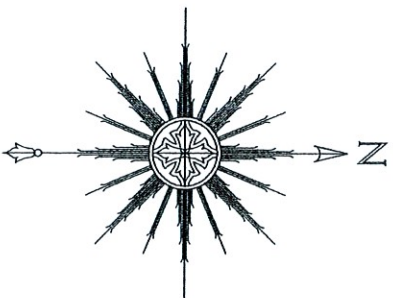

0 15' 30' 60'
SCALE: 1" = 30'

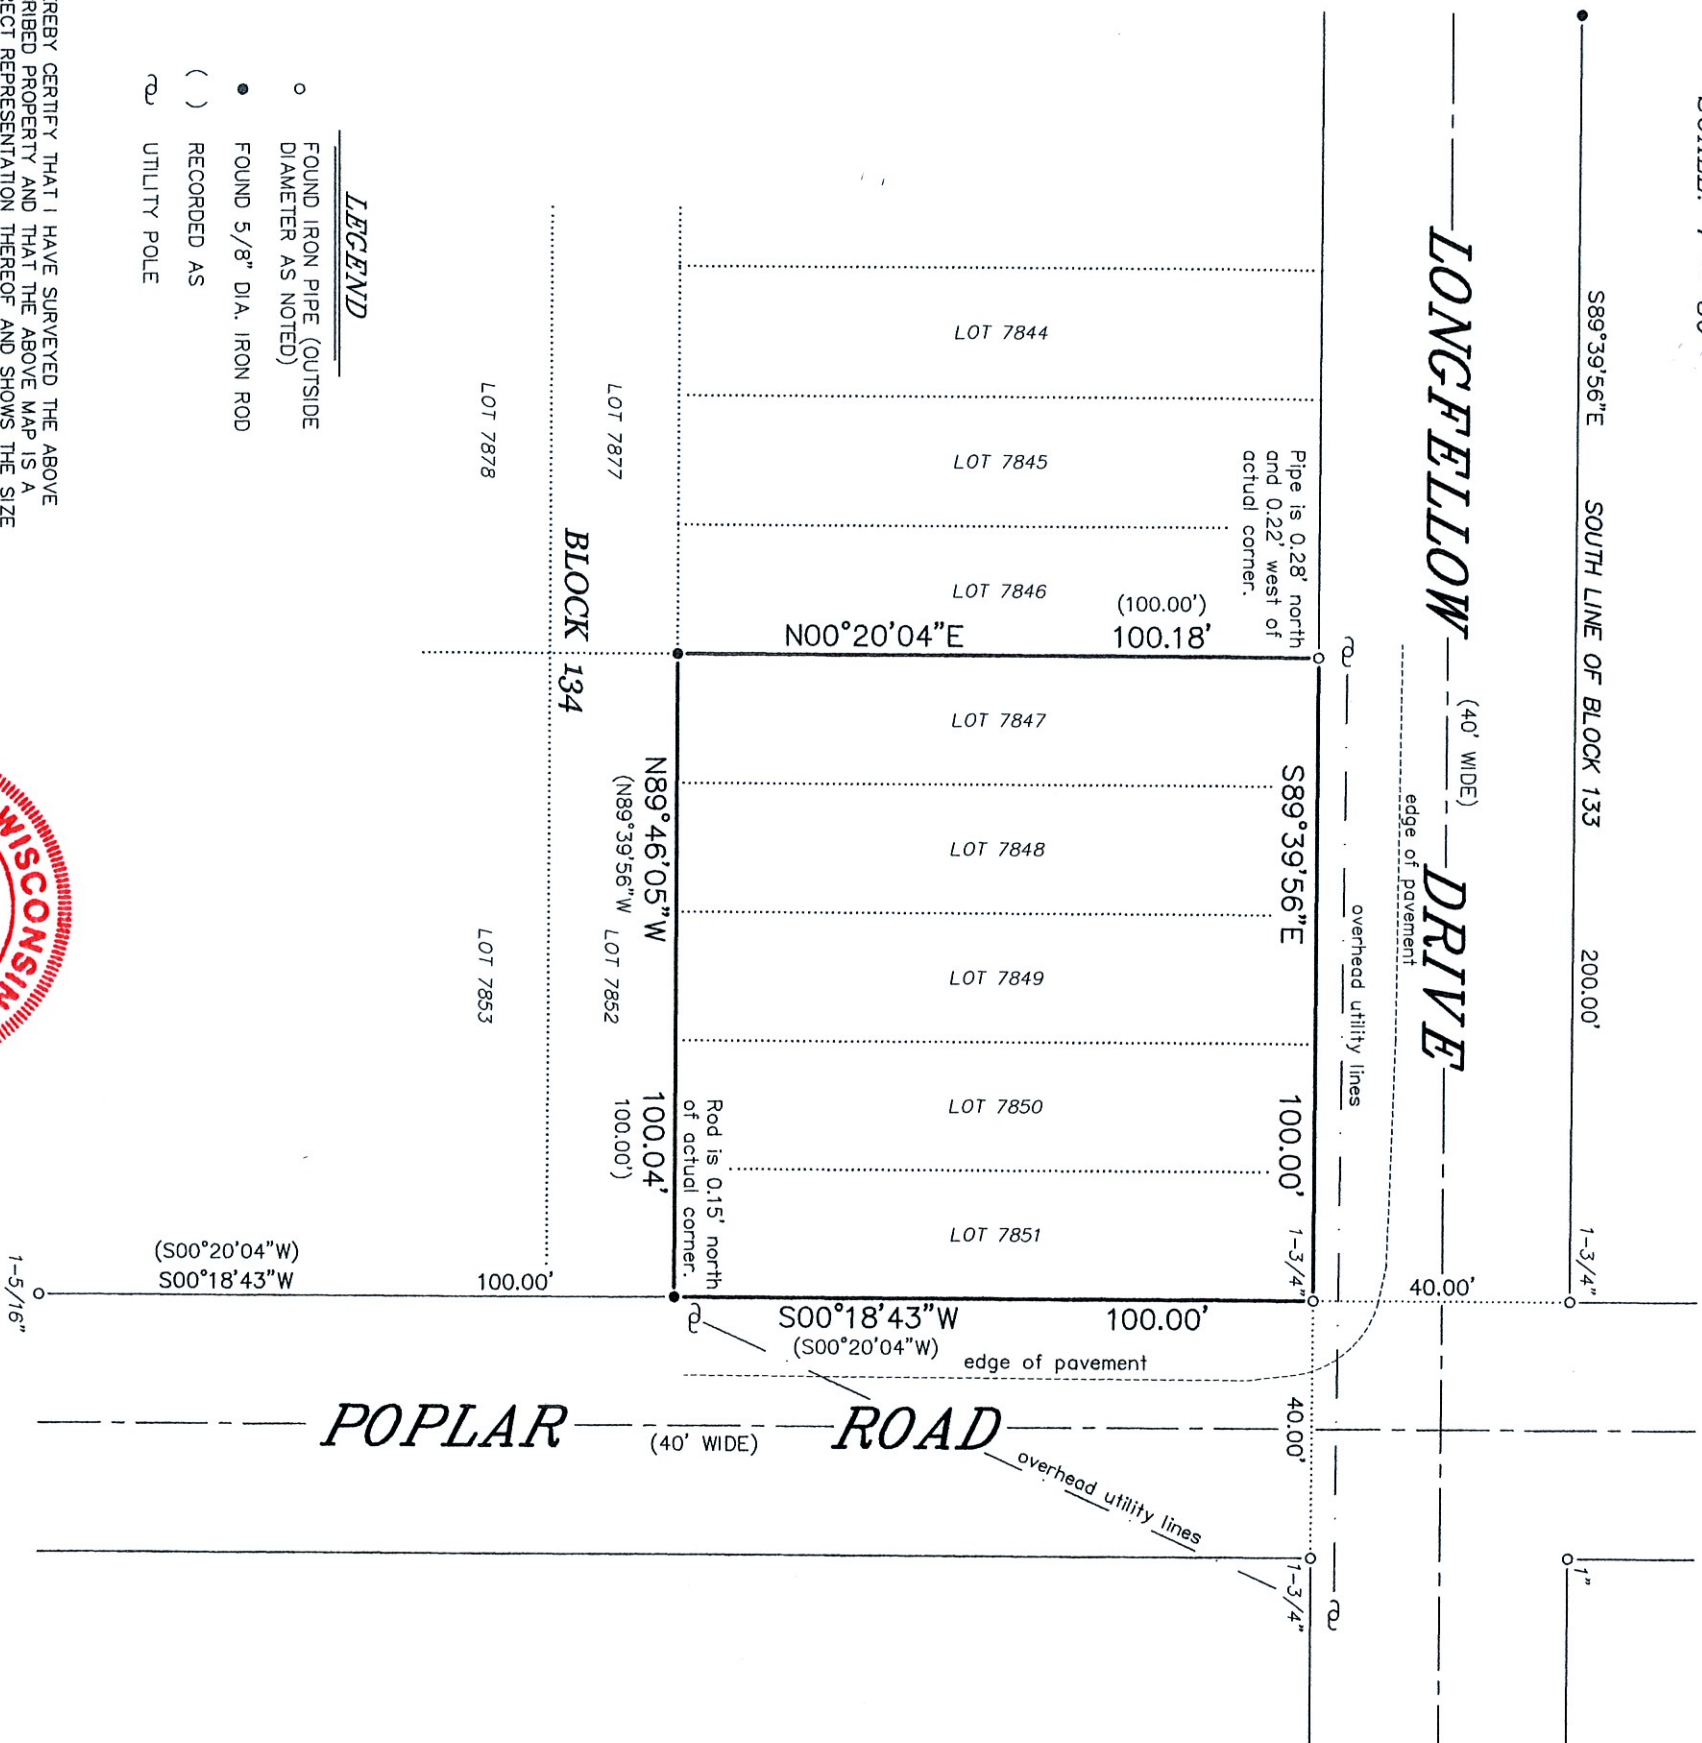

- LEGEND**
- FOUND IRON PIPE (OUTSIDE DIAMETER AS NOTED)
 - FOUND 5/8" DIA. IRON ROD
 - () RECORDED AS
 - ~ UTILITY POLE

"I HEREBY CERTIFY THAT I HAVE SURVEYED THE ABOVE DESCRIBED PROPERTY AND THAT THE ABOVE MAP IS A CORRECT REPRESENTATION THEREOF AND SHOWS THE SIZE AND LOCATION OF THE PROPERTY, ITS EXTERIOR BOUNDARIES, THE LOCATION OF ALL VISIBLE STRUCTURES AND DIMENSIONS OF ALL PRINCIPAL BUILDINGS THEREON, BOUNDARY FENCES, APPARENT EASEMENTS, ROADWAYS AND ENCROACHMENTS, IF ANY."

"THIS SURVEY IS MADE FOR THE USE OF THE PRESENT OWNERS OF THE PROPERTY, AND THOSE WHO PURCHASE, MORTGAGE, OR GUARANTEE THE TITLE THERETO WITHIN ONE YEAR FROM DATE HEREOF."



SATTER SURVEYING, LLC
LAND SURVEYS, MAPPING AND PLANNING
272 ORIGIN STREET
BURLINGTON, WI 53105
262-661-4239

THIS IS NOT AN ORIGINAL PRINT
UNLESS THIS SEAL IS RED.

THOMAS L. SATTER
Thomas L. Satter
S-2850
JULY 24, 2020
DATE
121807
JOB NUMBER