


LEGEND

●	FOUND 1" IRON PIPE		EXISTING CONCRETE
(XX)	RECORDED AS		EXISTING ASPHALT DRIVE
⊙	WELL		EXISTING BUILDING
○	4" PVC VENT		
U	UTILITY PEDESTAL		
— XC —	WIRE FENCE		

PLAT OF SURVEY

A PARCEL OF LAND LOCATED IN THE NORTHWEST 1/4 OF THE NORTHEAST 1/4 OF SECTION 34 IN TOWNSHIP 2 NORTH, RANGE 17 EAST, IN THE TOWN OF GENEVA, WALWORTH COUNTY, WISCONSIN.

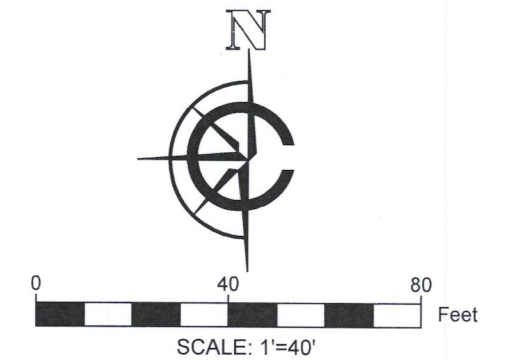

NOTE:
 1. BASIS OF BEARING: THE WISCONSIN STATE PLANE COORDINATE SYSTEM, NAD-83, SOUTH ZONE.
 2. FIELD WORK COMPLETED DECEMBER 29, 2020
 3. BUILDING SURVEYED TO THE EXTERIOR OF SIDING.
 4. FIELD CREW CHIEF: LOGAN RANDLE.

LEGAL DESCRIPTION:

A PARCEL OF LAND LOCATED IN THE NORTHWEST 1/4 OF THE NORTHEAST 1/4 OF SECTION 34 IN TOWNSHIP 2 NORTH, RANGE 17 EAST, IN THE TOWN OF GENEVA, WALWORTH COUNTY, WISCONSIN, MORE PARTICULARLY DESCRIBED AS:

LOT 25 IN THE WILDWOOD SUBDIVISION, AS RECORDED IN DOCUMENT # 575511 AT THE WALWORTH COUNTY REGISTER OF DEEDS.

SURVEY ORDERED BY:

JOEL REYENGA

PROPERTY ADDRESS:

N2806 WILDWOOD DR
 LAKE GENEVA, WI 53147

SURVEYOR:



PAUL H. VAN HENKELUM, PLS
 CARDINAL ENGINEERING LLC



"I HEREBY CERTIFY THAT I HAVE SURVEYED THE ABOVE DESCRIBED PROPERTY AND THE MAP IS A TRUE AND CORRECT REPRESENTATION OF ITS EXTERIOR BOUNDARIES AND SHOWS THE SIZE AND LOCATION OF ALL VISIBLE STRUCTURES, APPARENT EASEMENTS AND ENCROACHMENTS, IF ANY."

Paul H. Van Henkelum
 PAUL H. VAN HENKELUM, PLS #1931

12/30/2020
 DATE

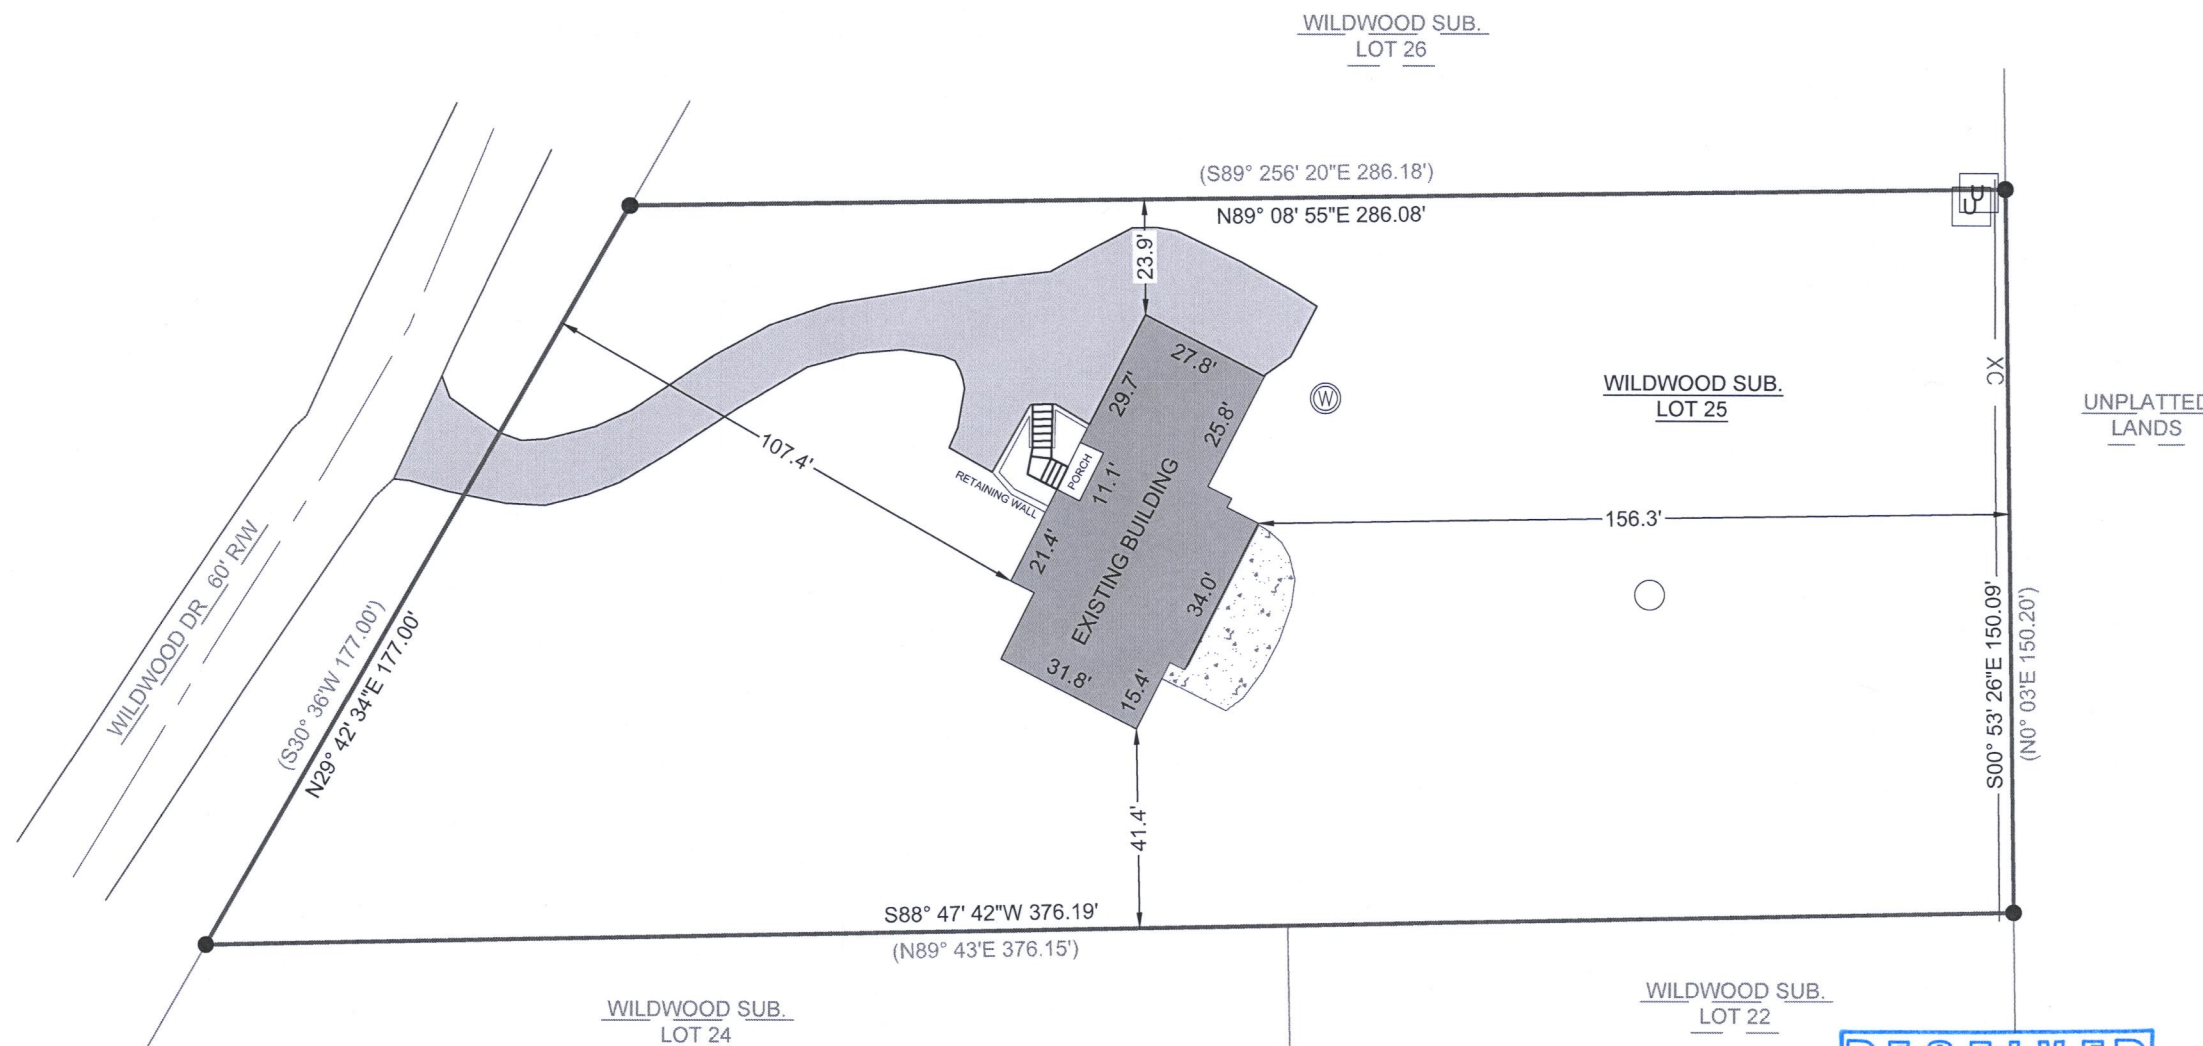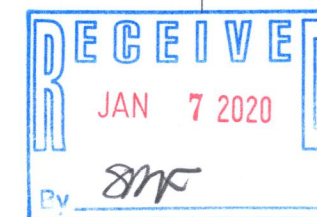

CARDINAL ENGINEERING LLC
 DESIGNING IN TRUE DIRECTIONS

PO BOX 281 - 1200 LA SALLE ST.
 LAKE GENEVA, WI 53147
 262-757-8776
 CARDINALENGINEERINGWI.COM

DATE: 12/29/20 JOB No. 20542
 SHEET 1 OF 1 JBM

JWS-24

217-4714