


HAROLD H. KOLB

REGISTERED PROFESSIONAL LAND SURVEYOR
LAKE GENEVA, WISCONSIN

LINCOLN DRIVE

BLOCK 102

HICKORY ROAD

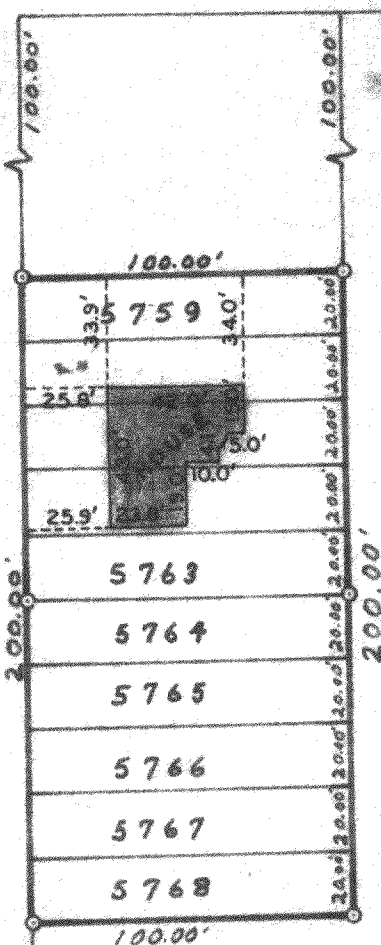

PLAT OF SURVEY OF


Lots 5759-5768, Block 102, Lake Como Beach,
a subdivision located in T 2 N, R 17 E,
Walworth County, Wisconsin.

N

SCALE 1" = 60'

LEGEND

- - IRON PIPE FOUND
- - IRON PIPE PLACED
- - CONCRETE MONUMENT
- x - SPIKE

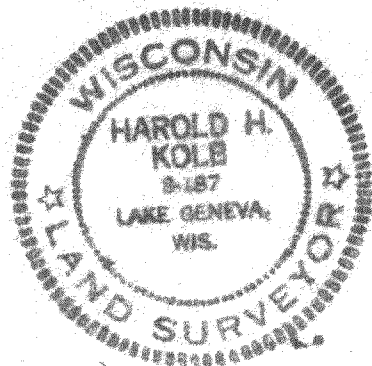

I, HAROLD H. KOLB, DO HEREBY CERTIFY THAT I HAVE
SURVEYED THE PROPERTY HEREON DESCRIBED ACCORDING
TO THE OFFICIAL RECORDS, AND THAT THE PLAT HEREON
IS A CORRECT REPRESENTATION OF THE LOT LINES.

Harold H. Kolb

HAROLD H. KOLB

WISCONSIN REGISTERED LAND SURVEYOR, S-187

DATE October 11, 1966

Revised: January 14, 1976

217-476

JLCB-1170

2-17-1984