

-ДО-


SURVEY FOR: LUANN SMITH - KEEFE REAL ESTATE



412 N. PINE STREET
BURLINGTON, WI
(262)-767-0225



B.W. SURVEYING, INC.

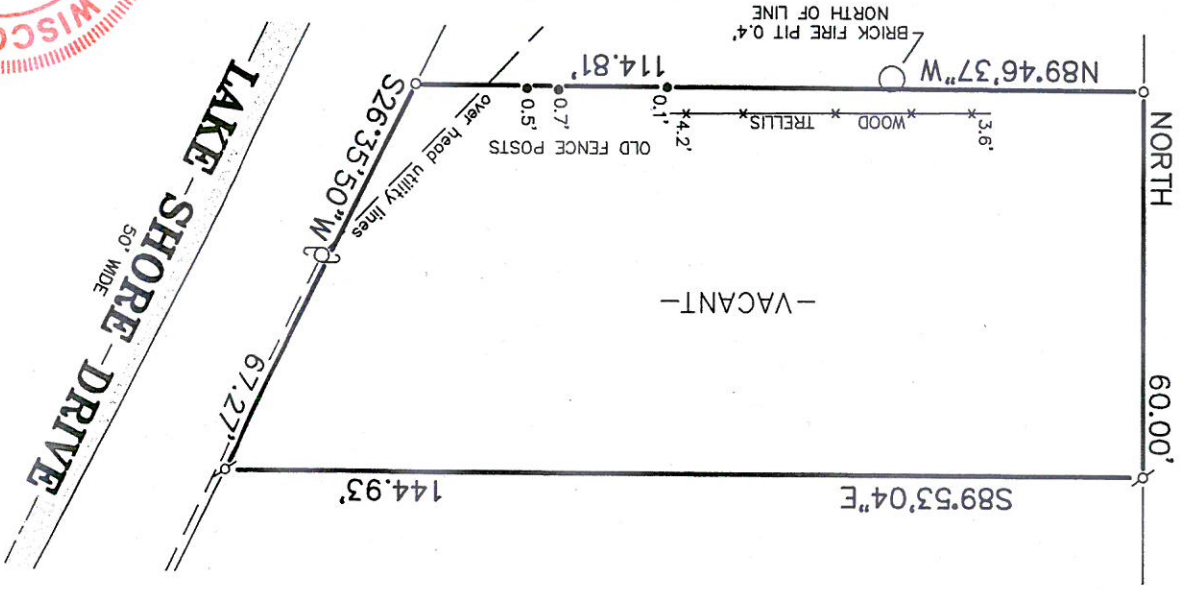

THIS IS NOT AN ORIGINAL PRINT
UNLESS THIS SEAL IS RED.

Robert J. Wetzel
S-1778

JANUARY 5, 2021
DATE

10314
JOB NUMBER