




SCALE 1"=20
O= IRON PIPE

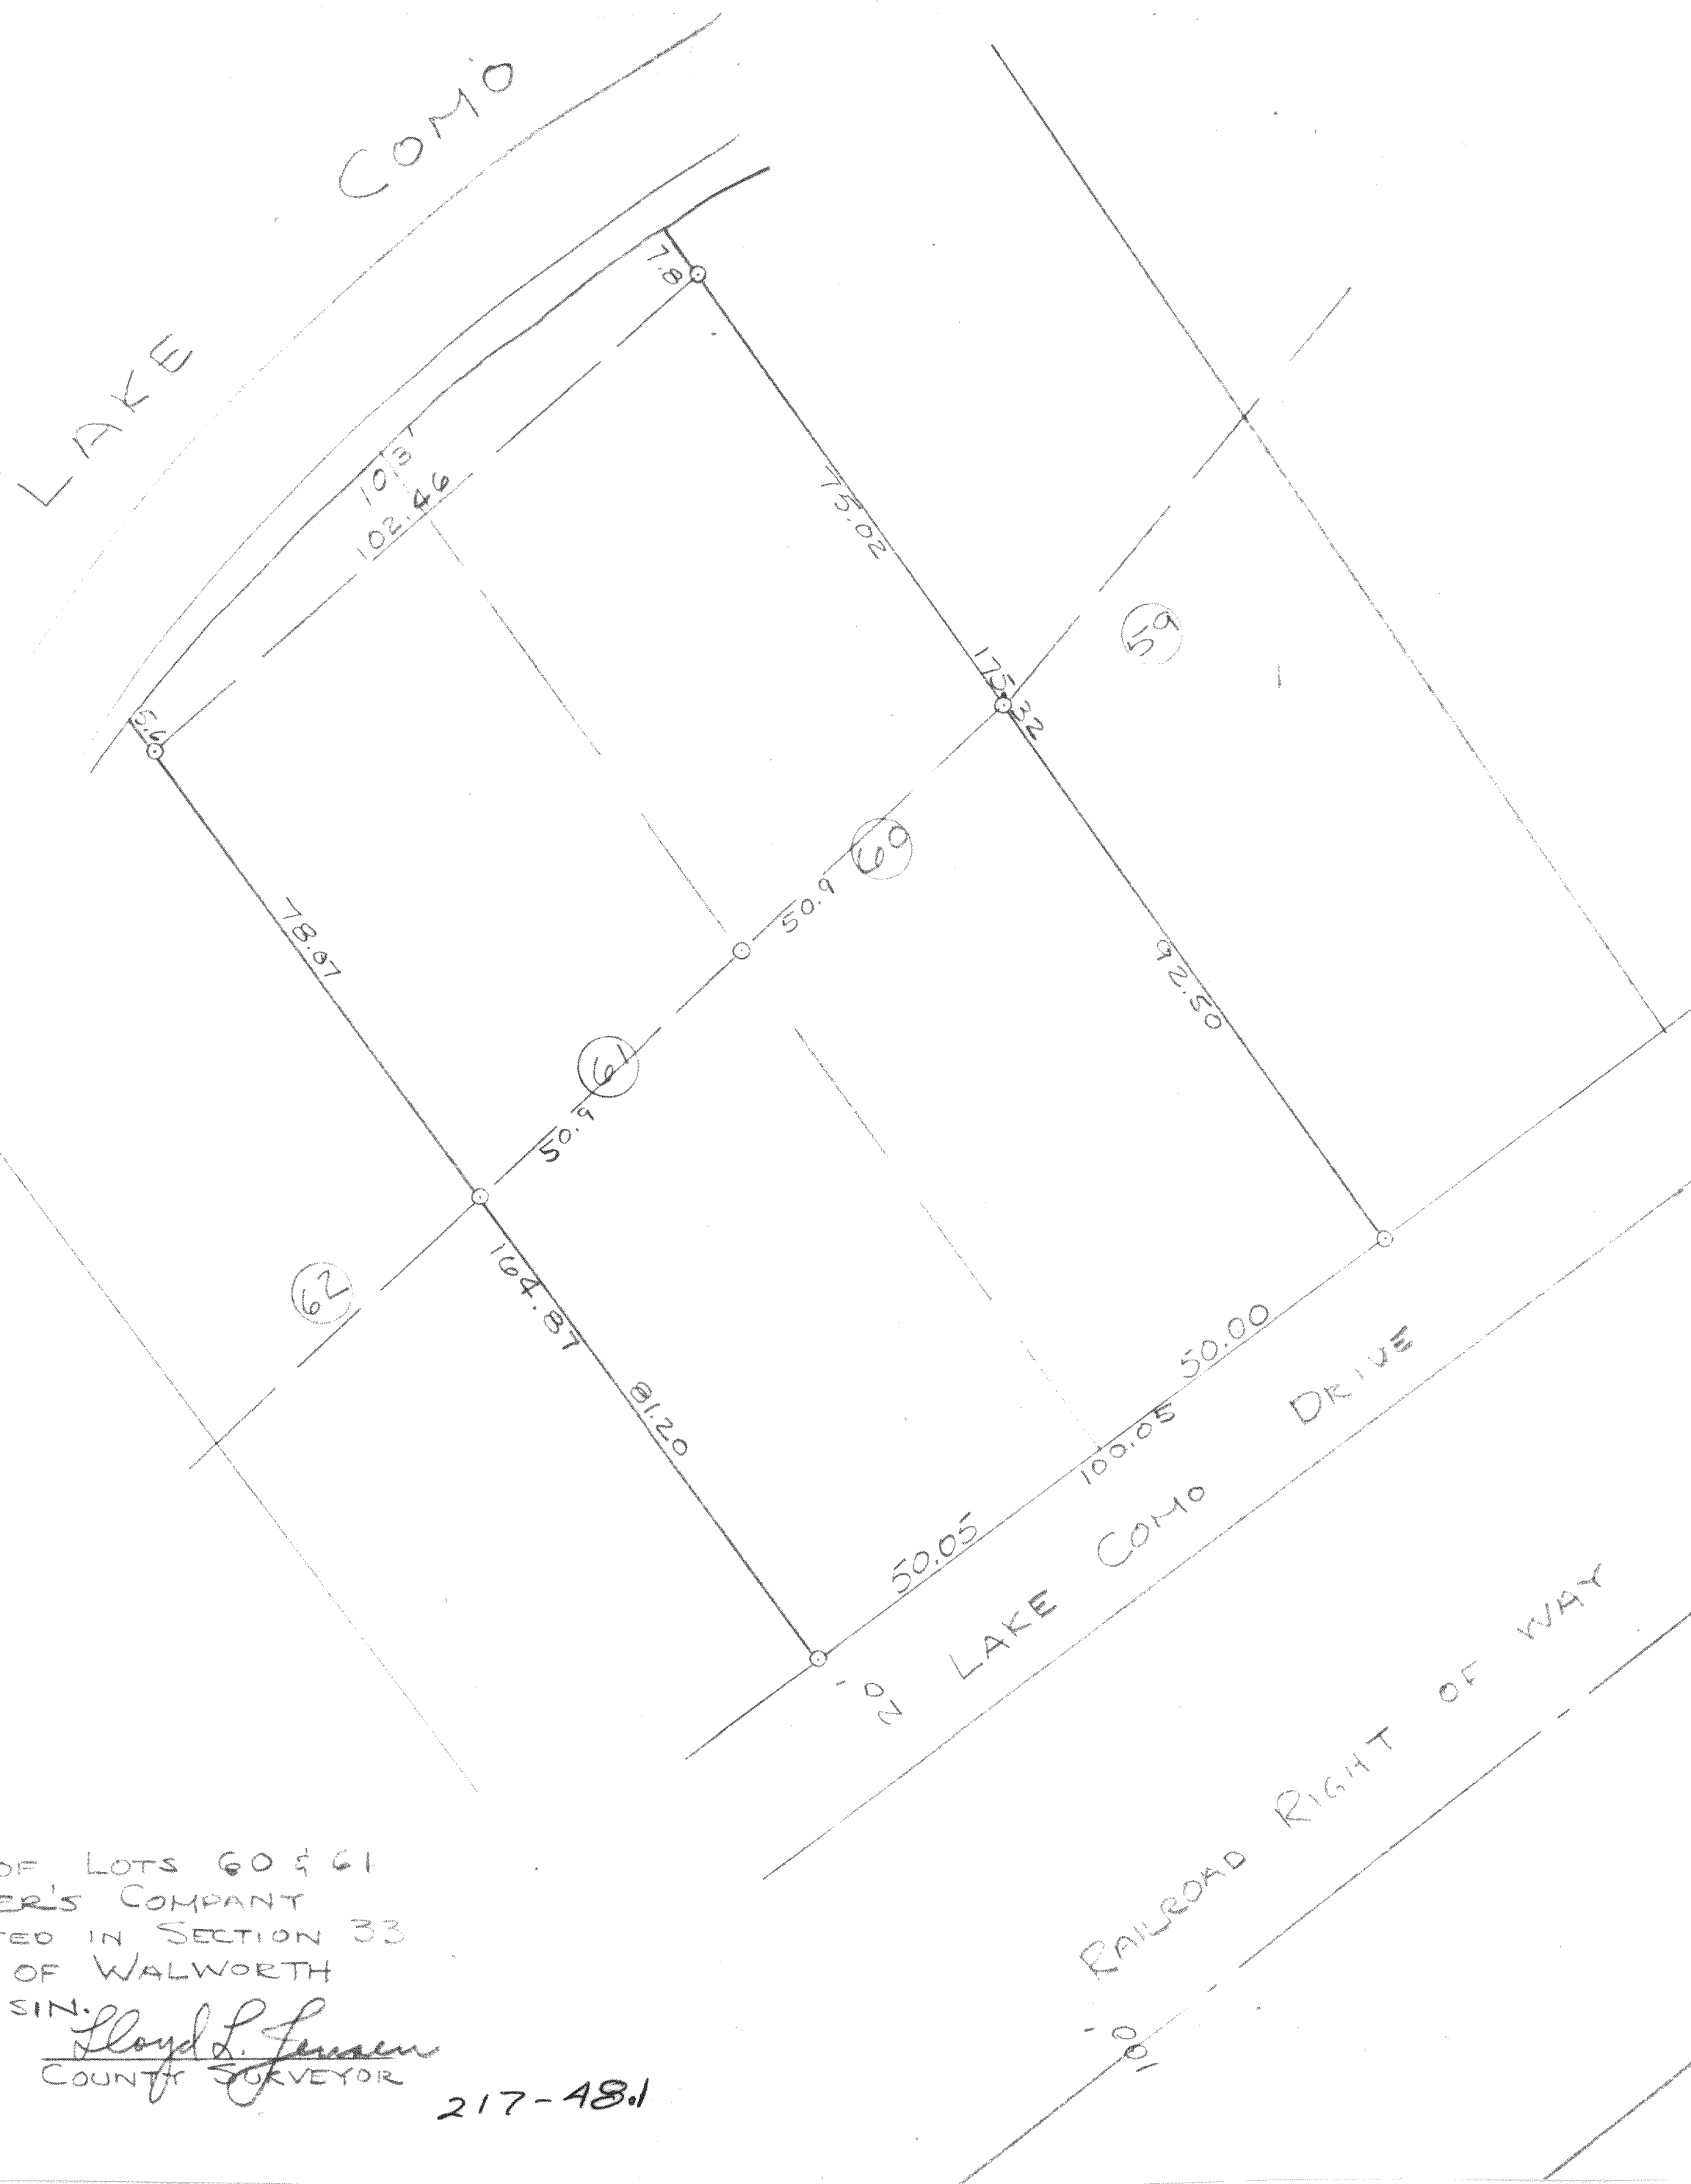

PLAT OF SURVEY OF LOTS 60 & 61
OF THE CONSUMER'S COMPANY
SUBDIVISION LOCATED IN SECTION 33
OF T2N R1E OF WALWORTH
COUNTY, WISCONSIN.

OCT. 1950

Lloyd L. Jensen
COUNTY SURVEYOR

217-48.1