


A PARCEL OF LAND LOCATED IN THE SOUTHWEST 1/4 OF THE NORTHEAST 1/4 OF SECTION 28 IN TOWNSHIP 2 NORTH, RANGE 17 EAST, IN THE TOWN OF GENEVA, WALWORTH COUNTY, WISCONSIN, MORE PARTICULARLY DESCRIBED AS:
LOTS 5622-5625 OF BLOCK 100 OF THE LAKE COMO BEACH SUBDIVISION AS RECORDED IN DOCUMENT #P255830 AS PER THE WALWORTH COUNTY REGISTER OF DEEDS.

FERN ROAD GRADING AND SITE PLAN
TOWN OF GENEVA, WALWORTH COUNTY, WI

PRELIMINARY


SITE AND GRADING PLAN

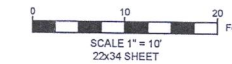

	STONE TRACKING PAD
	PROPOSED SIDEWALK DRIVEWAY
	EXISTING MANHOLE
	EXISTING WATER VALVE
	EXISTING HYDRANT
	FOUND .5" IRON PIPE
	FOUND IRON ROD

{ XX }

RECORDED AS

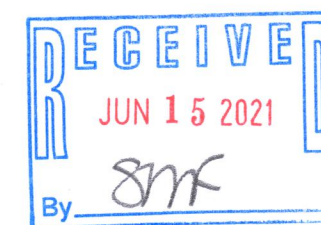

1200 LA SALLE STREET,
LAKE GENEVA, WI 53147
262-757-8776
CARDINALENGINEERINGWI.COM

NO.	REVISION DESCRIPTION	REV DATE
SCALE	1 IN:10 FT	
PROJECT NUMBER	20477	
DATE	03-10-2021	
PROJECT MGR	RWC	
DRAWN BY	EJO	
DESIGNED BY	EJO	
SHEET NUMBER		

SHEET NUMBER

1 OF 1

FOUNDATION ASBUILT COMPLETED 05/11/2021

FILE: Y:\Projects\20477 - (5622-25) Fern Rd (SME); BALSITIS\DWG\BASE\20477SO.dwg

PLOTTED: 5/11/2021 11:46:45 AM

JLCB-1144

217-4800