


PLAT OF SURVEY

OF LOTS 4266 THRU 4268, AND LOTS 4291 THRU 4295,
BLOCK 73 OF LAKE COMO BEACH SUBDIVISION, BEING PART
OF THE SE 1/4 OF THE NE 1/4 OF SECTION 28, T. 2 N., R. 17 E.,
OF THE 4TH P.M., WALWORTH COUNTY, WISCONSIN.

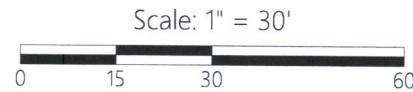

DISTANCE UNITS BASED ON THE UNITED STATES SURVEY FOOT
THE WEST LINE OF ACACIA ROAD ASSUMED TO BEAR S 0°20'58" W

MONUMENT KEY

- Iron Rebar Found
- ⊙ Iron Pipe Found
- Mag Nail Found
- (XXX.XX) Record Information



Kristin J Belongia


Kristin J. Belongia, P.L.S.
Wisconsin Professional Land Surveyor S-2943

State of Wisconsin } ss
County of Rock

I hereby certify that I have supervised the survey of the property described above and to the best of my knowledge and belief, the plat drawn hereon complies with Chapter A-E 7 of the State of Wisconsin Administrative Code, Minimum Standards for Property Surveys and correctly represents said survey and its location.

Given under my hand and seal this 16th day of August, 2021 at Beloit, Wisconsin.
Last day of field work August 10th, 2021

If the surveyor's signature is not red in color,
the plan is a copy that should be assumed to
contain unauthorized alterations.
The certification contained on this document
shall not apply to any copies.

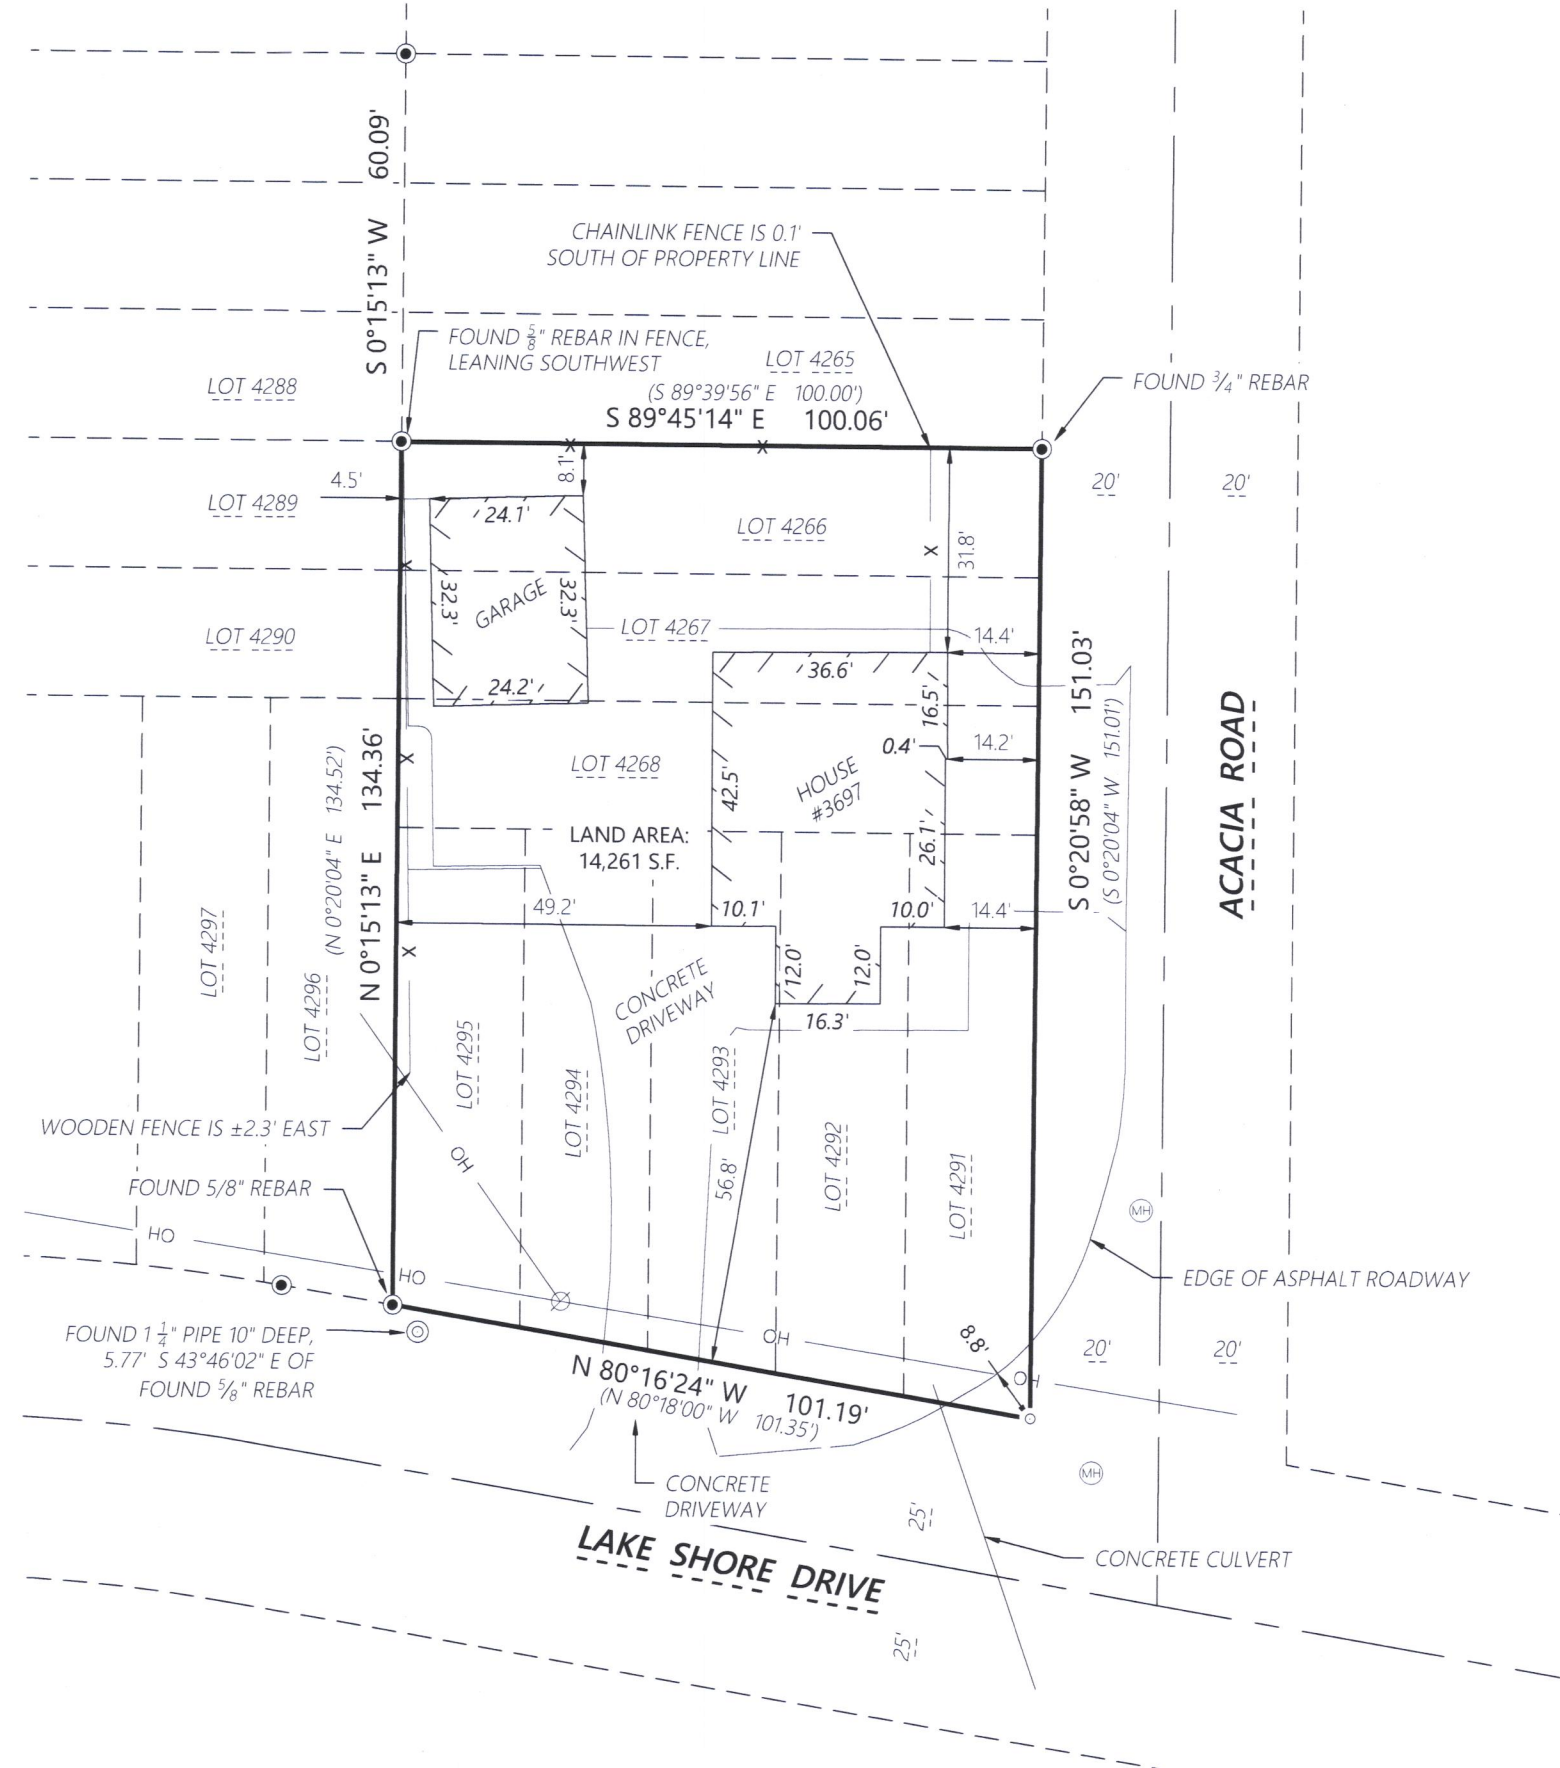

Batterman
engineers surveyors planners
Beloit, Wisconsin 53511
2857 Barrells Drive
608.365.4464
www.batterman.com

PLAT OF SURVEY

FOR THE EXCLUSIVE USE OF:
GEORGE KRAUSE
W3697 LAKE SHORE DRIVE
LAKE GENEVA, WI 53147

ORDER NO: 34002
BOOK: SEE FILE
FIELD CREW: DGM
DRAWN BY: DGM
SHEET 1 OF 1

JLCB-831

217-4843