


A PARCEL OF LAND LOCATED IN THE SOUTHWEST 1/4 OF THE NORTHEAST 1/4 OF SECTION 28 IN TOWNSHIP 2 NORTH, RANGE 17 EAST, IN THE TOWN OF GENEVA, WALWORTH COUNTY, WISCONSIN, MORE PARTICULARLY DESCRIBED AS:
LOTS 5622-5625 OF BLOCK 100 OF THE LAKE COMO BEACH SUBDIVISION AS RECORDED IN DOCUMENT #P255830 AS PER THE WALWORTH COUNTY REGISTER OF DEEDS.



FERN ROAD GRADING AND SITE PLAN
TOWN OF GENEVA, WALWORTH COUNTY, WI

SITE AND GRADING PLAN

PRELIMINARY

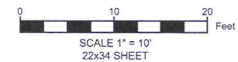

	STONE TRACKING PAD
	PROPOSED ASPHALT DRIVEWAY
	EXISTING MANHOLE
	EXISTING WATER VALVE
	EXISTING HYDRANT
	FOUND .5" IRON PIPE
	FOUND IRON ROD
{ XX }	RECORDED AS

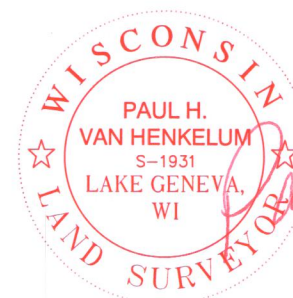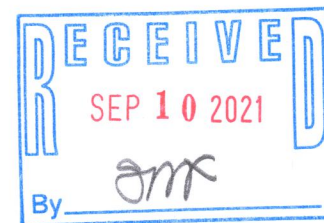

FOUNDATION ASBUILT COMPLETED 05/11/2021

NO.	REVISION DESCRIPTION	REV DATE
SCALE		1 IN=10 FT
PROJECT NUMBER		20477
DATE		03-10-2021
PROJECT MGR		RWC
DRAWN BY		EJO
DESIGNED BY		EJO

SHEET NUMBER

1 OF 1

JLCB-1144

217-4845