 
 



LEGAL DESCRIPTION

**LOCATED IN THE NORTHEAST 1/4 OF THE NORTHWEST 1/4 AND THE
NORTHWEST 1/4 OF THE NORTHEAST 1/4 ALL IN SECTION 34, TOWNSHIP 2 NORTH,
RANGE 17 EAST, IN THE TOWN OF GENEVA, WALWORTH CO., WI.**

LOT 73, WILDWOOD ADDITION NO. 1

GRADING LEGEND

- | | |
|---|--|
|  | EXISTING CONTOUR |
|  | EXISTING SPOT ELEVATION |
|  | PROPOSED CONTOUR |
|  | PROPOSED SPOT ELEVATION |
|  | FLOWLINE (1% MINIMUM IN EARTH) |
|  | SHEET FLOW CONDITION |
|  | HIGH POINT |
|  | FLOWLINE |
|  | EDGE OF PAVEMENT |
|  | FINISHED SURFACE |
|  | INVERT |
|  | INDICATES SILT FENCING PER DNR STD. 1056 TO BE INSTALLED PRIOR TO ANY GRADING OR EXCAVATION OPERATIONS AND MAINTAINED IN PLACE UNTIL GROUND COVER AND OTHER LANDSCAPING IS ESTABLISHED. |
|  | TEMPORARY DITCH CHECK |

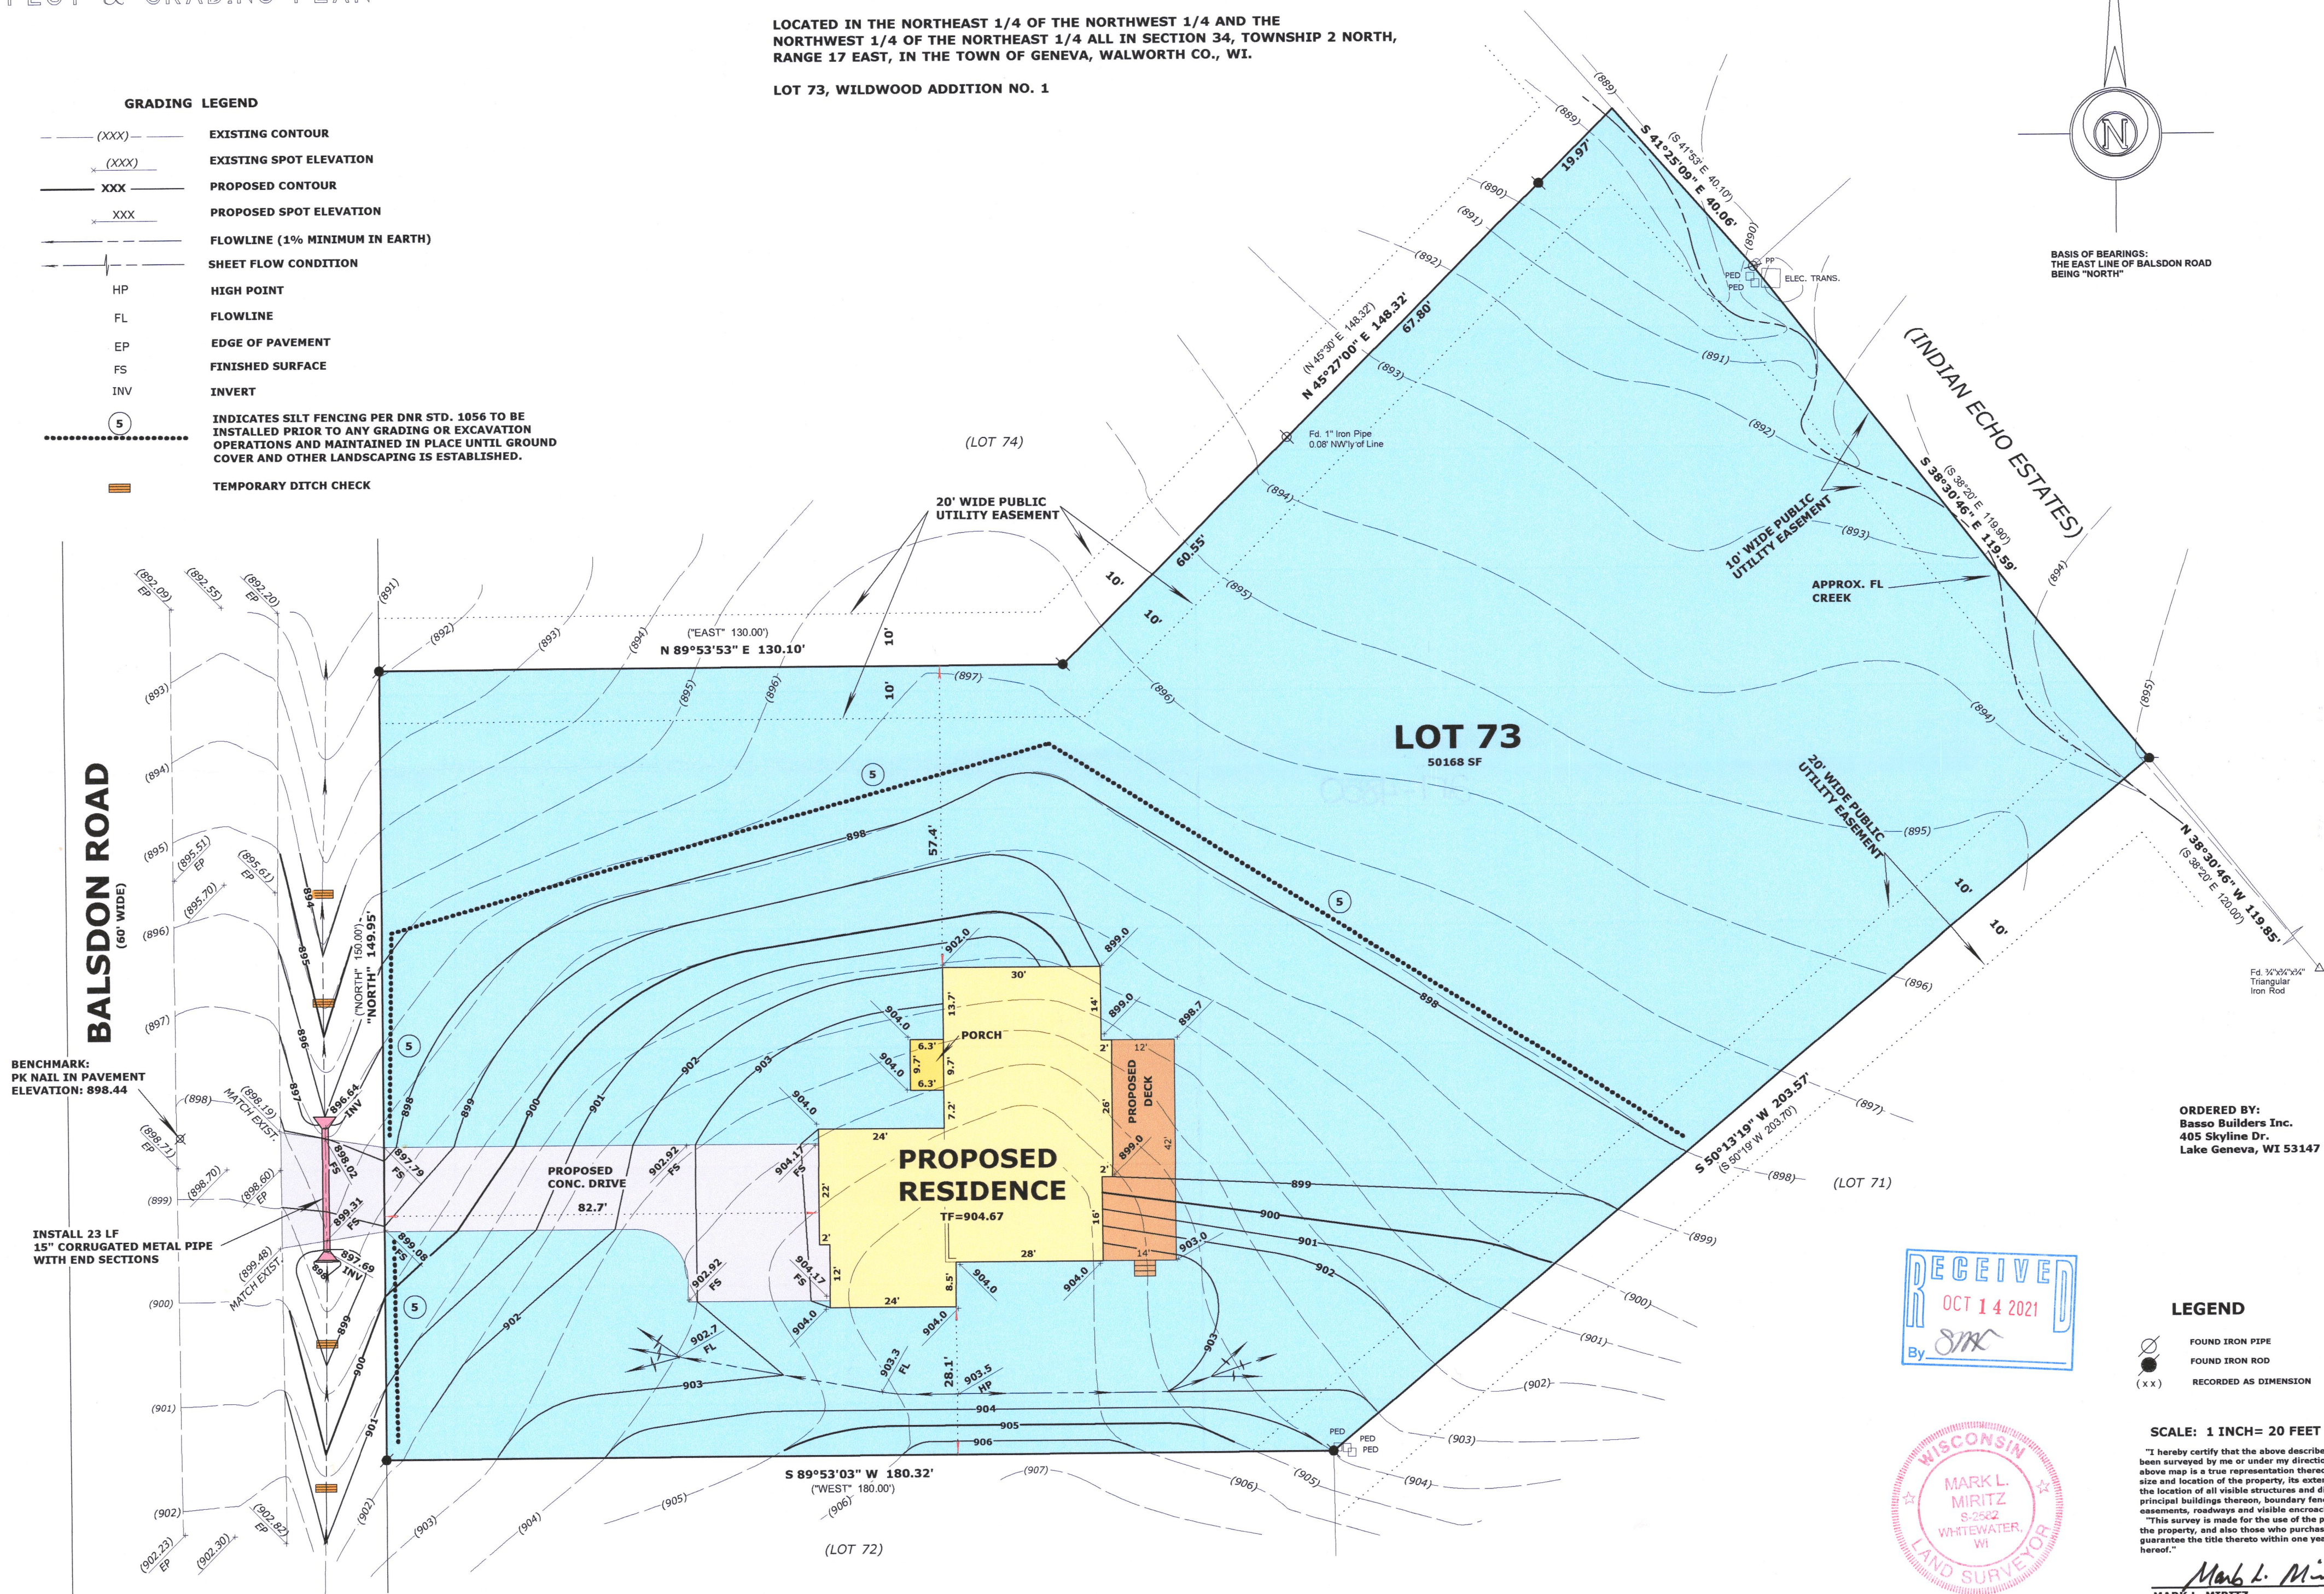

ORDERED BY:
Basso Builders Inc.
405 Skyline Dr.
Lake Geneva, WI 53147

LEGEND

- | | |
|---|-----------------------|
|  | FOUND IRON PIPE |
|  | FOUND IRON ROD |
| (XX) | RECORDED AS DIMENSION |

SCALE: 1 INCH= 20 FEET

"I hereby certify that the above described property has been surveyed by me or under my direction and that the above map is a true representation thereof and shows the size and location of the property, its exterior boundaries, the location of all visible structures and dimensions of all principal buildings thereon, boundary fences, apparent easements, roadways and visible encroachments, if any."

"This survey is made for the use of the present owners of the property, and also those who purchase, mortgage, or guarantee the title thereto within one year from date hereof."

Mark L. Miritz
 MARK L. MIRITZ
 WISCONSIN PROFESSIONAL
 LAND SURVEYOR S-2582

8/20/2021 REVISE LL VIEW AREA

DATE: August 18, 2021 JOB NO. 21.704