


PLAT OF SURVEY
-OF-

LOTS 10037-10044 IN BLOCK 183, EXCEPT THE EAST 20 FEET OF LOT 10037 THEREOF, IN FIFTH MAP OF LAKE COMO BEACH SUBDIVISION, TOWN OF GENEVA, WALWORTH COUNTY, WISCONSIN.

SURVEY FOR: RAYMOND & KATHY CZARNIK
SURVEY ADDRESS: N3070 TAMARACK ROAD, LAKE GENEVA, WI 53147

NOTE: REFER TO A CURRENT TITLE REPORT
FOR EASEMENTS, RESTRICTIONS OR COVENANTS
WHICH MAY AFFECT THIS PROPERTY.

BEARINGS HEREON RELATE TO THE SOUTH
LINE OF LOT 10037 OF THE FIFTH MAP OF
LAKE COMO BEACH, ASSUMED BEARING OF
NORTH 89°39'56" WEST AS PLATTED.

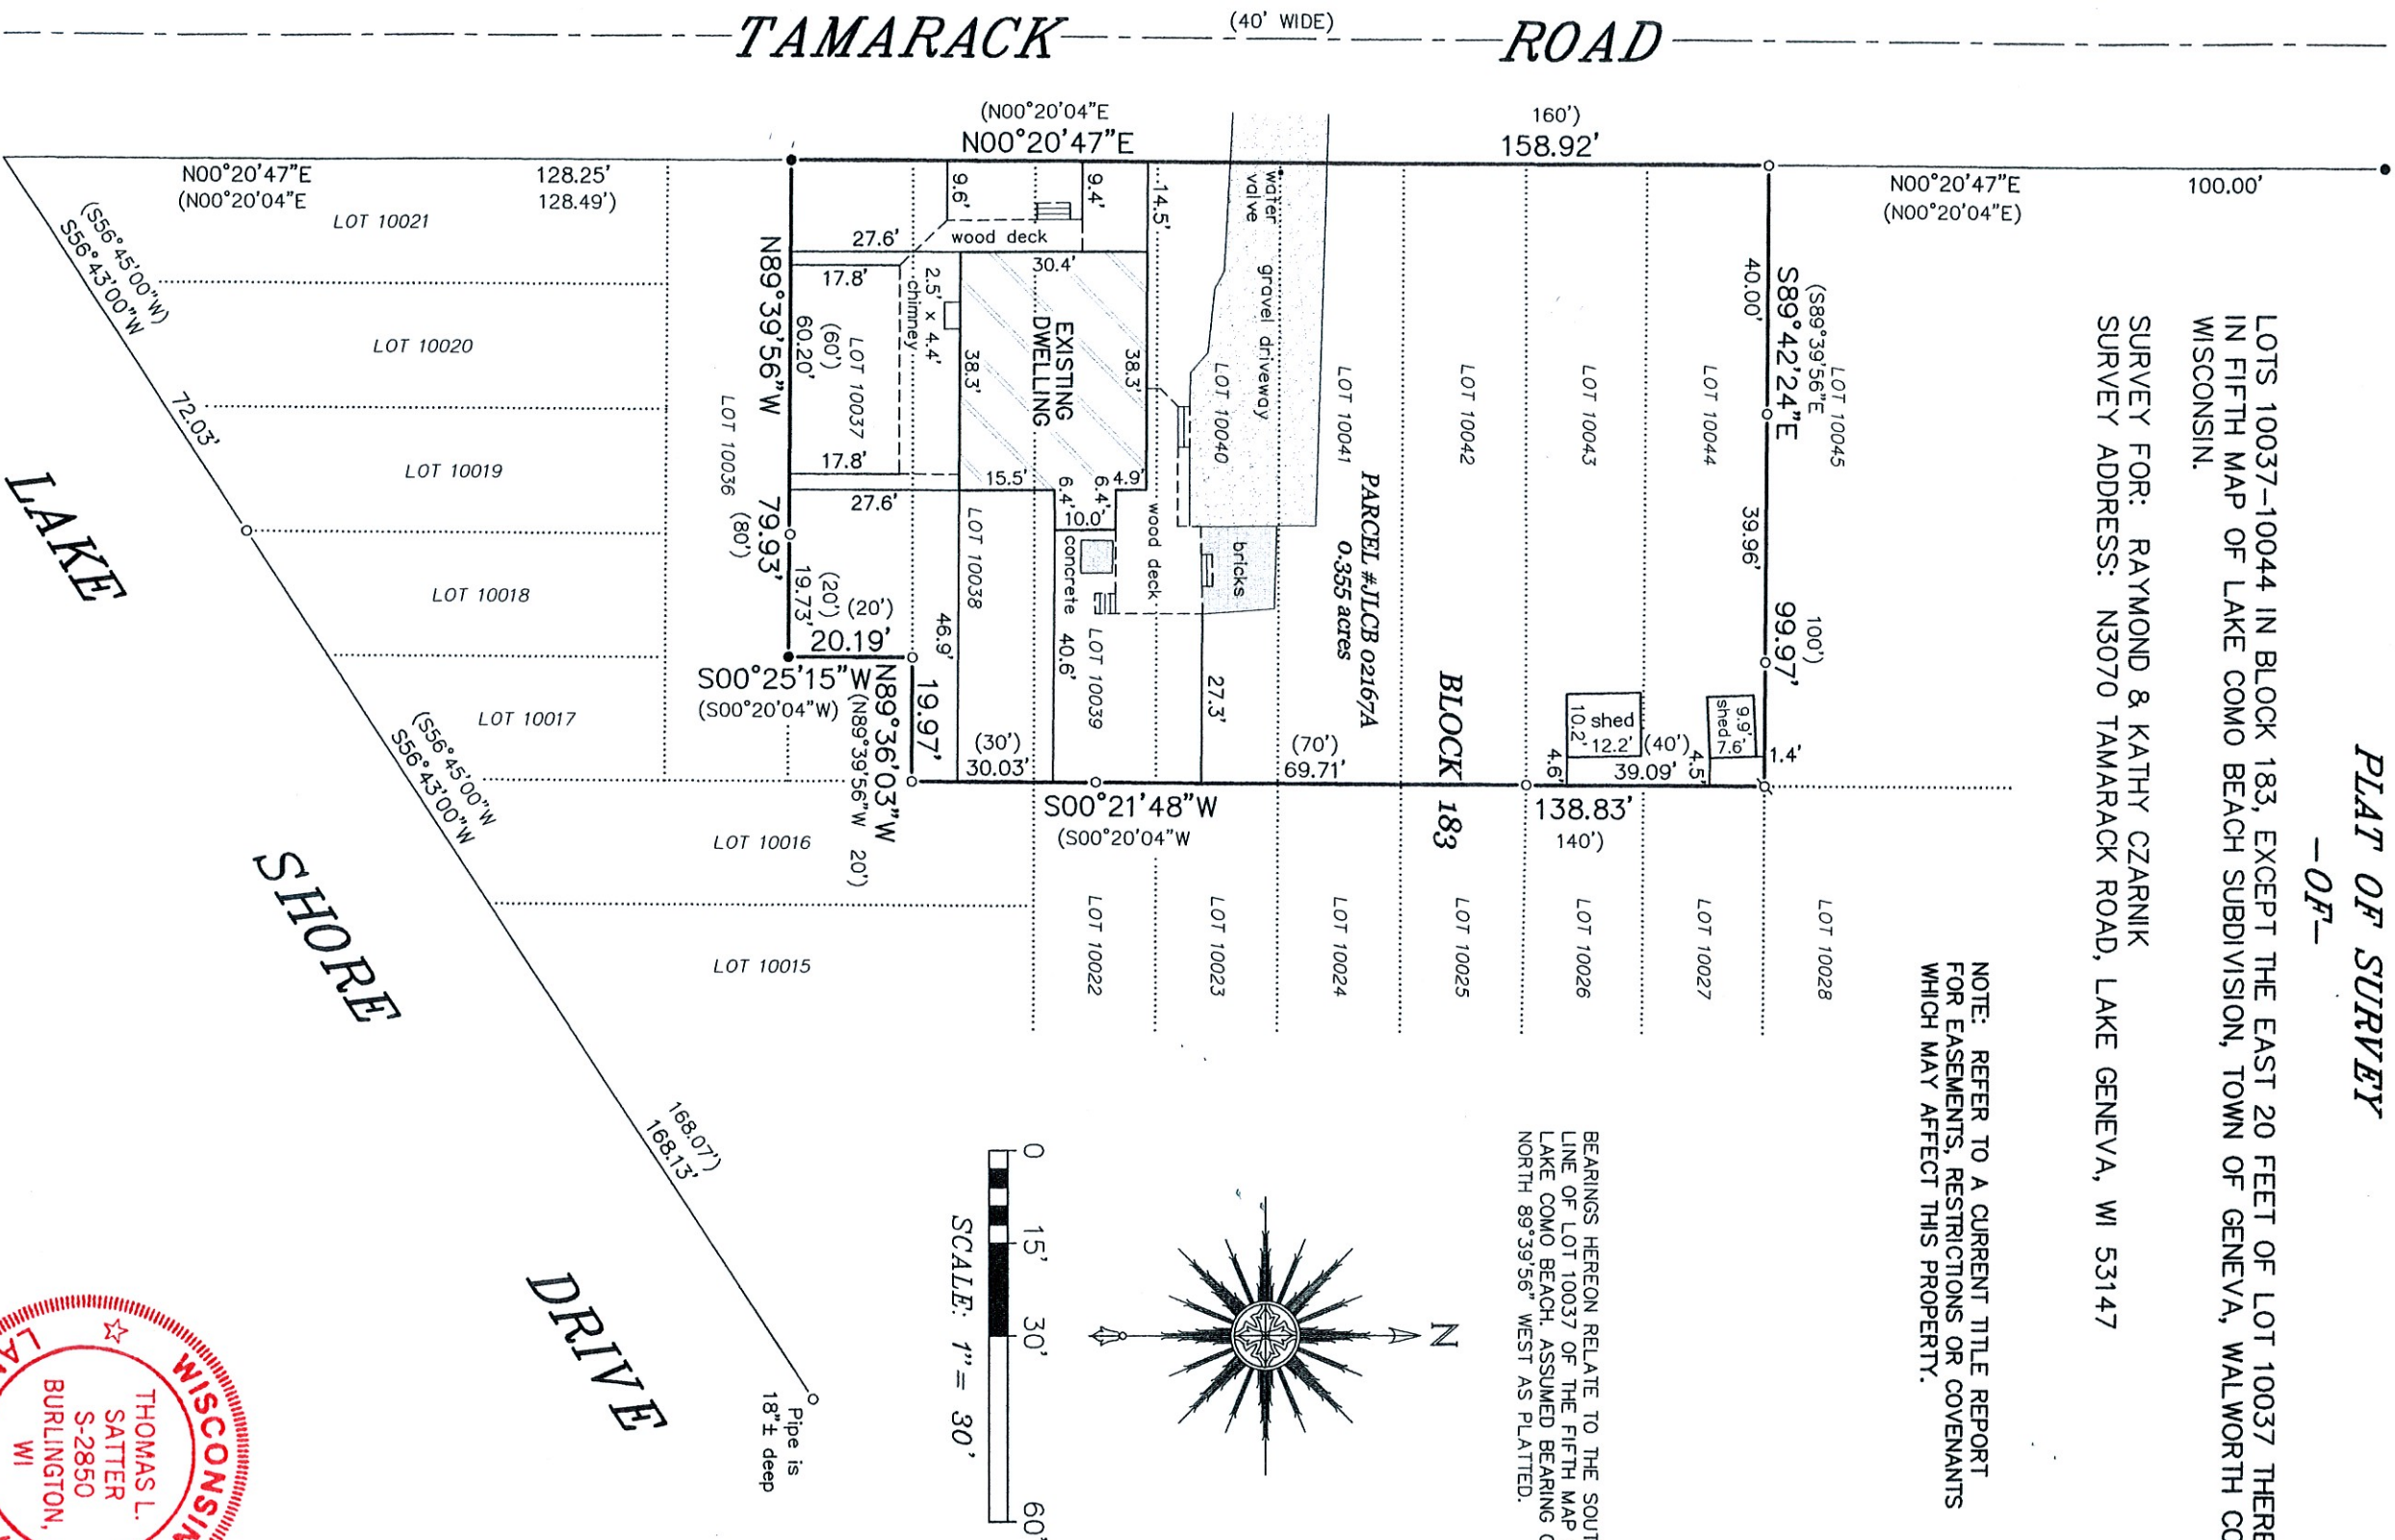

LEGEND

- FOUND IRON PIPE
- FOUND IRON ROD
- ⌘ SET IRON ROD
- () RECORDED AS

THIS IS NOT AN ORIGINAL PRINT
UNLESS THIS SEAL IS RED.



"I HEREBY CERTIFY THAT I HAVE SURVEYED THE ABOVE
DESCRIBED PROPERTY AND THAT THE ABOVE MAP IS A CORRECT
REPRESENTATION THEREOF AND SHOWS THE SIZE AND LOCATION
OF THE PROPERTY, ITS EXTERIOR BOUNDARIES, THE LOCATION
OF ALL VISIBLE STRUCTURES AND DIMENSIONS OF ALL
PRINCIPAL BUILDINGS THEREON, BOUNDARY FENCES, APPARENT
EASEMENTS, ROADWAYS AND ENCROACHMENTS, IF ANY."

Thomas L. Satter

THOMAS L. SATTER S-2850

SATTER SURVEYING, LLC

LAND SURVEYS, MAPPING AND PLANNING

2772 ORIGIN STREET

BURLINGTON, WI 53105

262-661-4239

REVISED: 10/22/21
SEPTEMBER 14, 2020
DATE
JOB NUMBER 082008