

PLAT OF SURVEY

LEGAL DESCRIPTION:

A PARCEL OF LAND LOCATED IN THE NORTHWEST 1/4 AND THE SOUTHWEST 1/4 OF THE SOUTHWEST 1/4 OF SECTION 22 IN TOWNSHIP 2 NORTH, RANGE 17 EAST, IN THE TOWN OF GENEVA, WALWORTH COUNTY, WISCONSIN, MORE PARTICULARLY DESCRIBED AS:




LOT 2 OF CERTIFIED SURVEY NO. 3801 AS RECORDED IN VOL. 23, PAGE 53 AT THE WALWORTH COUNTY REGISTER OF DEEDS.

LEGEND

- EXISTING BUILDING
- EXISTING GRAVEL
- FOUND 2" IRON PIPE
- FOUND 1" IRON PIPE
- FOUND IRON ROD

NOTE:

- BASIS OF BEARING:
THE WISCONSIN STATE PLANE COORDINATE SYSTEM, NAD-83, SOUTH ZONE.
 - FIELD WORK COMPLETED ON:
NOVEMBER 18TH, 2021
 - BUILDING SURVEYED TO:
THE EXTERIOR OF SIDING.
 - FIELD CREW CHIEF:
RAY MCCARDLE
- SURVEY ORDERED BY:
RON AMMAN
- PROPERTY ADDRESS:
N3445 CTY H
LAKE GENEVA, WI 53147
- SURVEYOR:
PAUL H. VAN HENKELUM, PLS
CARDINAL ENGINEERING LLC

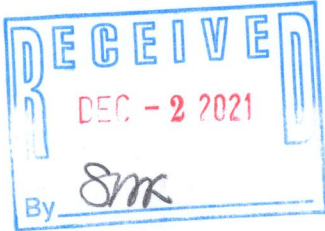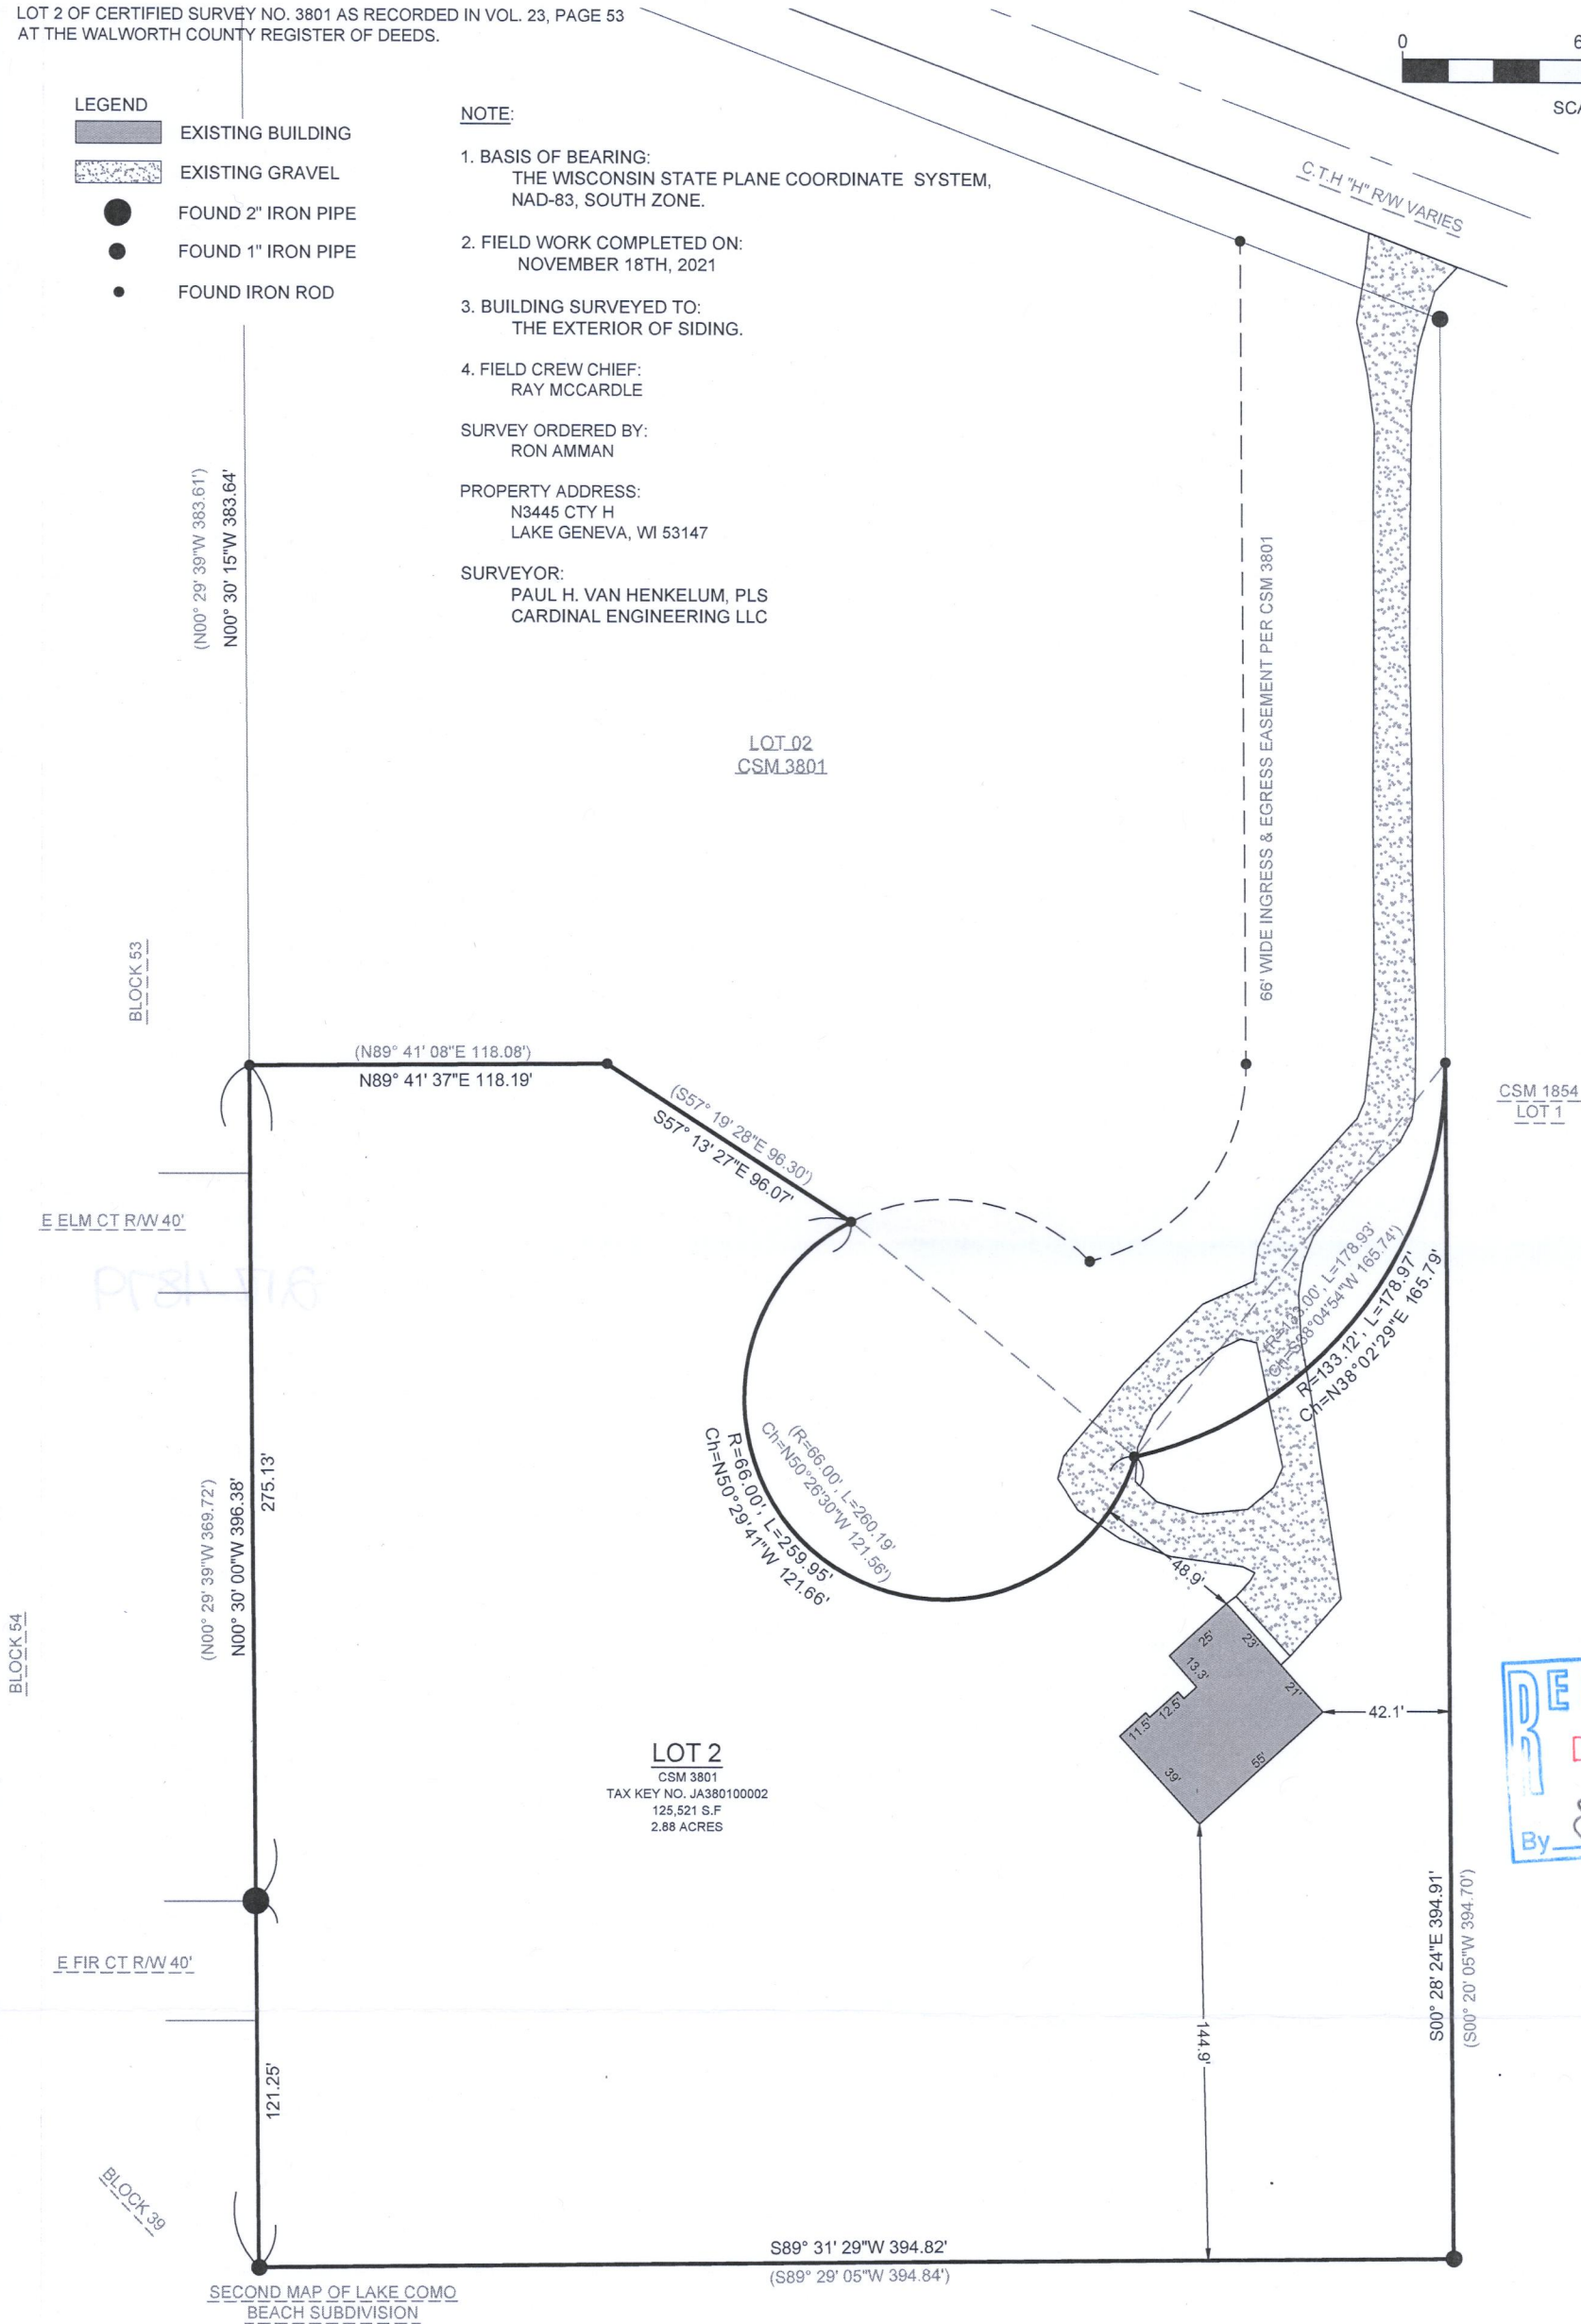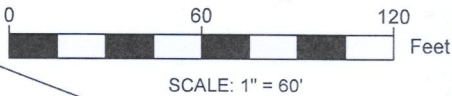

"I HEREBY CERTIFY THAT I HAVE SURVEYED THE ABOVE DESCRIBED PROPERTY AND THE MAP IS A TRUE AND CORRECT REPRESENTATION OF ITS EXTERIOR BOUNDARIES AND SHOWS THE SIZE AND LOCATION OF ALL VISIBLE STRUCTURES, APPARENT EASEMENTS AND ENCROACHMENTS, IF ANY.

Paul H. Van Henkelum
PAUL H VAN HENKELUM, PLS #1931

11/19/2021
DATE



CARDINAL ENGINEERING LLC
DESIGNING IN TRUE DIRECTIONS
PO BOX 281 - 1200 LA SALLE ST.
LAKE GENEVA, WI 53147
262-757-8776
CARDINALENGINEERINGWI.COM

DATE: 11/ 18 / 2021
SHEET 1 OF 1

JOB No.20522
JDB