



Vanderstappen
Land Surveying, Inc.

www.vandersinc.com
1316 N. Madison St.
Woodstock, Illinois 60098
ph. 815-337-8310 fax 815-337-8314
"Always faithful to the property line"


PLAT OF SURVEY

PARCEL 1

Lots 3787 through 3791, inclusive, Block 65, Lake Como Beach 2nd Map, according to the recorded Plat thereof, said land being in the Town of Geneva, County of Walworth, State of Wisconsin.

PARCEL 2


Lots 3781 through 3784, inclusive, Block 65, Lake Como Beach 2nd Map, according to the recorded Plat thereof, said land being in the Town of Geneva, County of Walworth, State of Wisconsin.

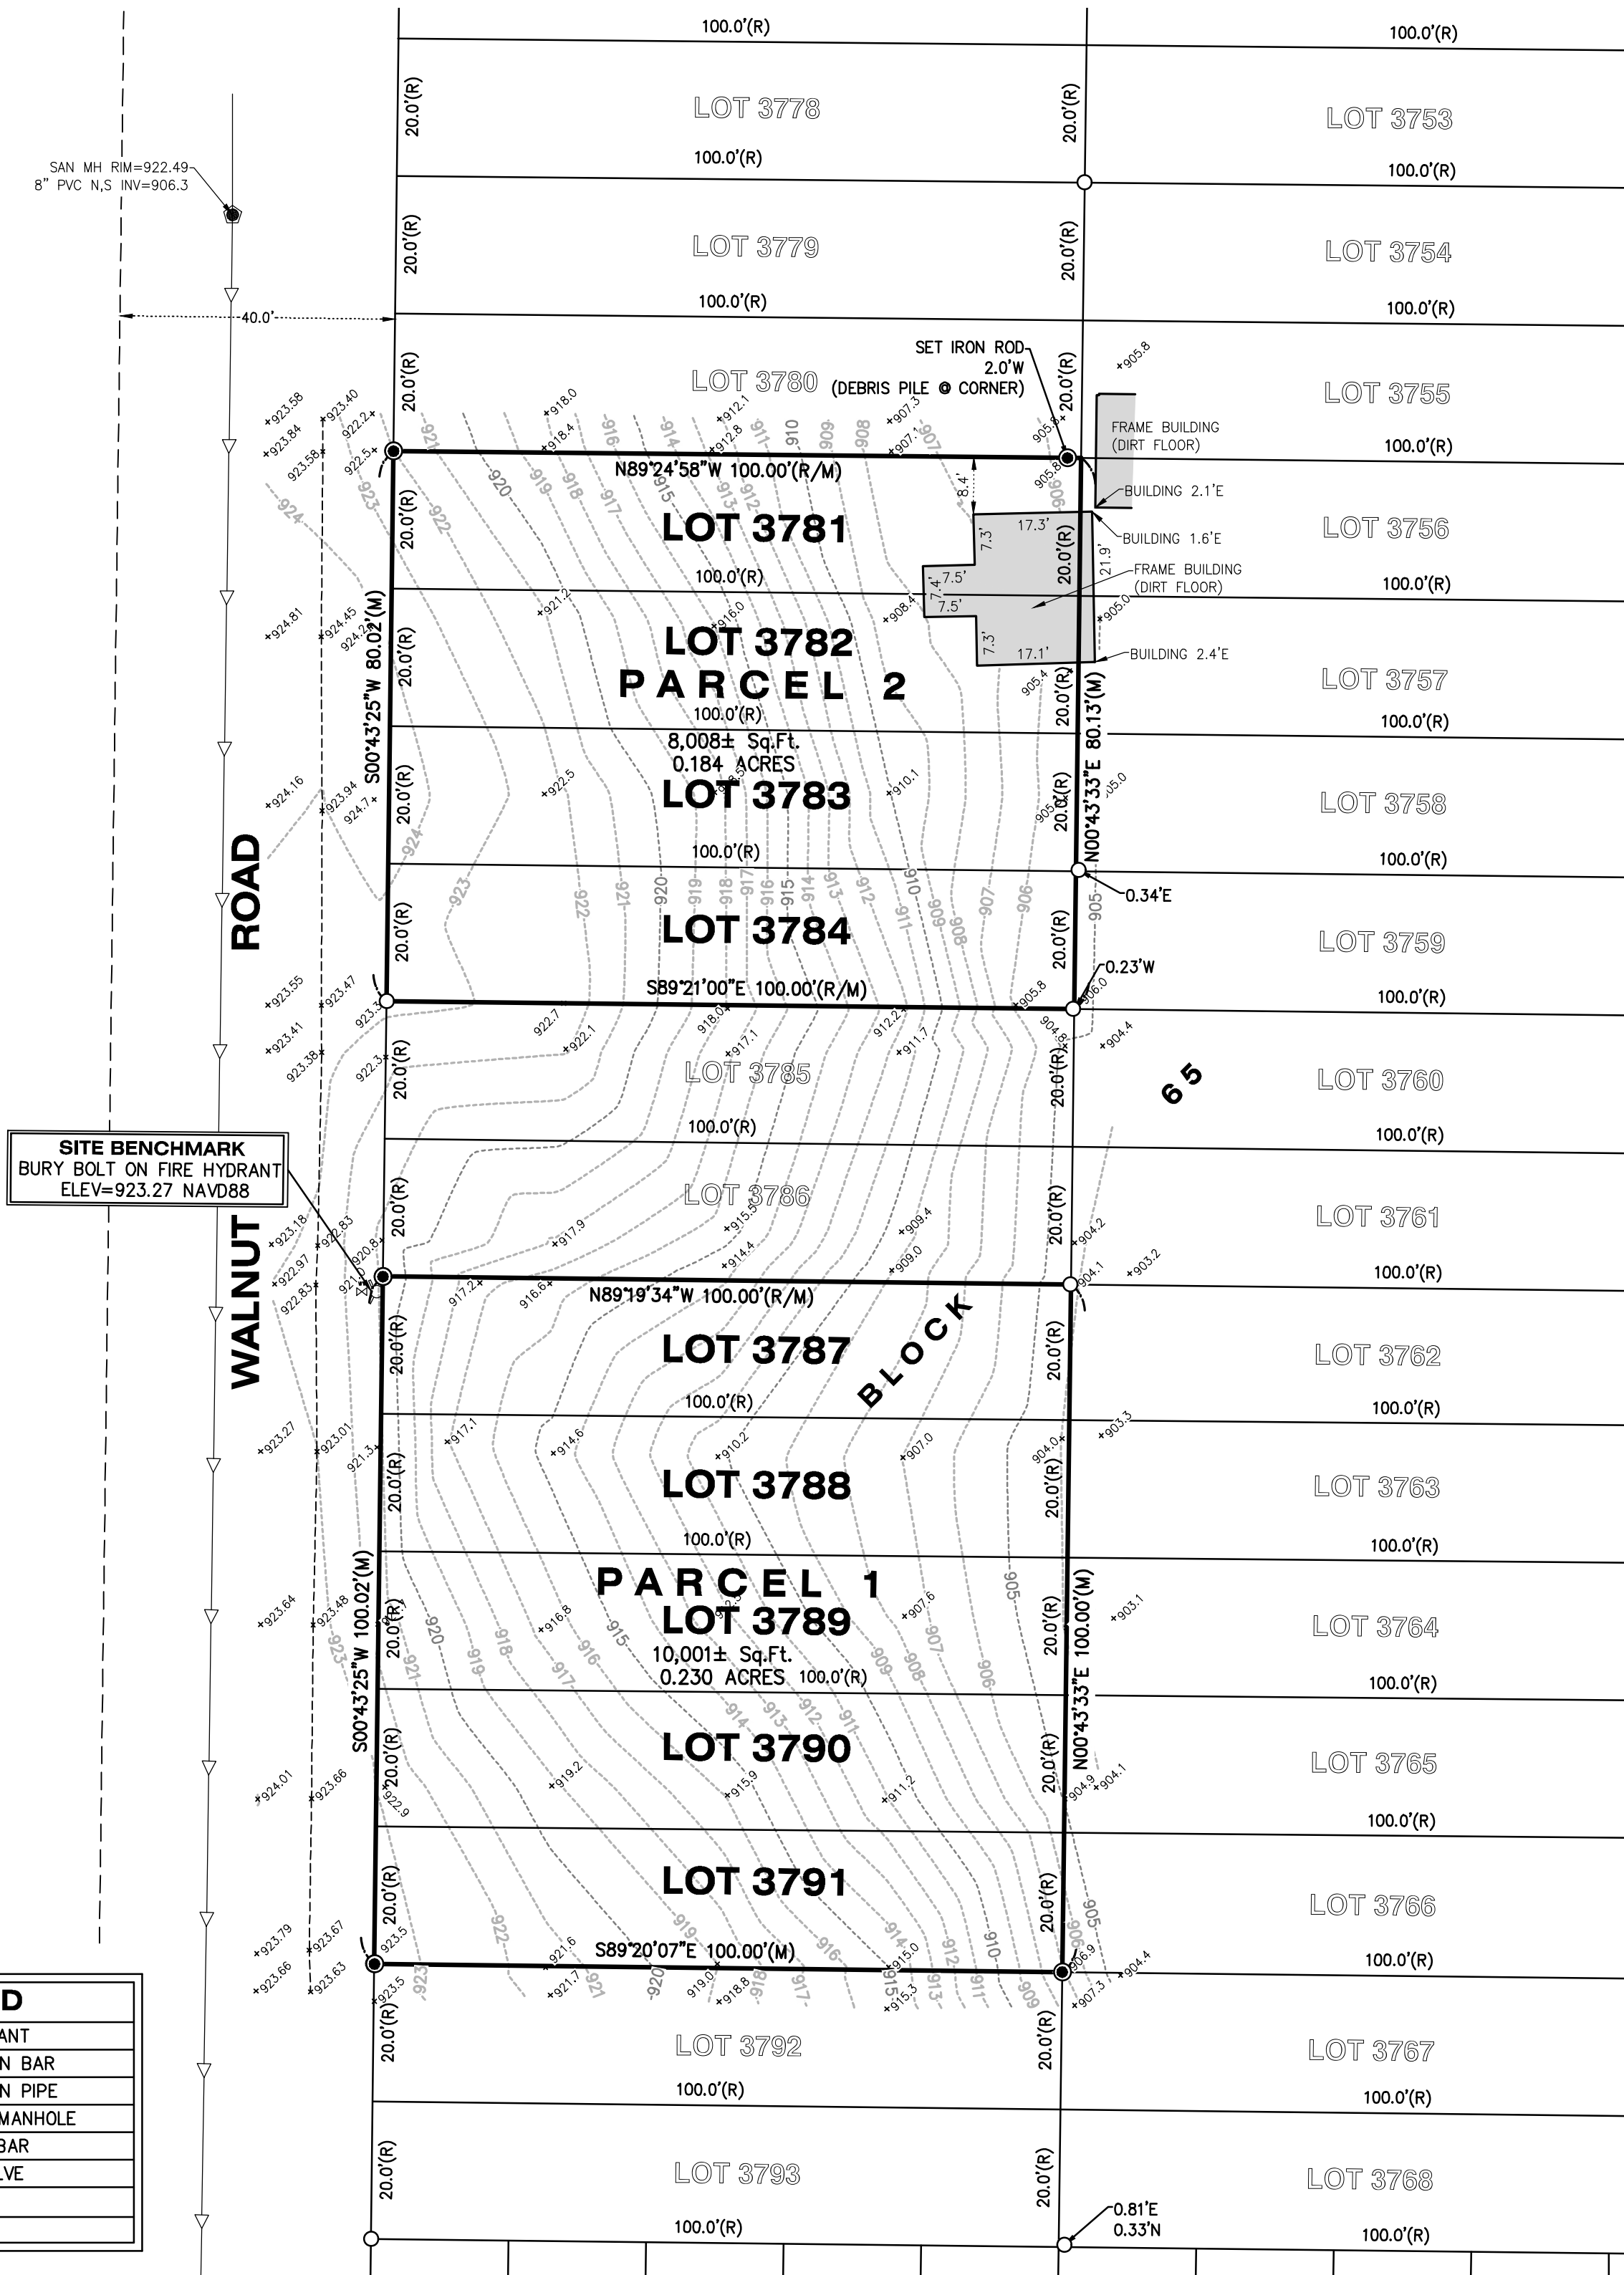

LEGEND

⊕	FIRE HYDRANT
●	FOUND IRON BAR
○	FOUND IRON PIPE
⊙	SANITARY MANHOLE
⊗	SET IRON BAR
⊕	WATER VALVE
(M)	MEASURE
(R)	RECORD

PROJECT BENCHMARK
WALWORTH COUNTY CONCRETE
MONUMENT W/BRASS CAP NW
SECTION CORNER 07-02-17
ELEV=916.05 NAVD88

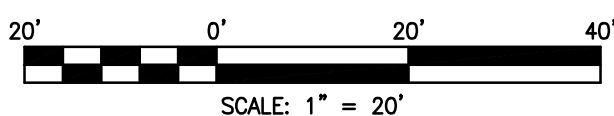

NOTE: Only those Building Line Restrictions or Easements shown on a Recorded Subdivision Plat are shown hereon unless the description ordered to be surveyed contains a proper description of the required building lines or easements.
* No distance should be assumed by scaling.
* No underground improvements have been located unless shown and noted.
* No representation as to ownership, use, or possession should be hereon implied.
* This Survey and Plat of Survey are void without original embossed or colored seal and signature affixed.

Compare your description and site markings with this plat and AT ONCE report any discrepancies which you may find.

STATE OF ILLINOIS)
COUNTY OF McHENRY) S.S.

In my professional opinion, and based on my observations, I hereby certify that the above described property has been surveyed under my direction and that the above map is a true representation thereof and shows the size and location of all visible structures, and dimensions of all principle buildings thereon, boundary fences, apparent easements, roadways, and visible encroachments, if any. This survey is made for the use of the present owners of the property, and also those who purchase, mortgage, or guarantee the title thereto within one year from the date hereof.

Dated at Woodstock, McHenry County, Illinois 11/10 A.D., 20 21.

Vanderstappen Land Surveying, Inc.
Design Firm No. 184-002792

By: *Robert J. Vanderstappen*
Wisconsin Registered Land Surveyor No. S3021

CLIENT: AT PROPERTIES

DRAWN BY: PJD CHECKED BY: APG

SCALE: 1"=20' SEC. 27 T. 02 R. 17 E.

BASIS OF BEARING: ASSUMED

P.I.N.: JLCB 00716, JLCB 00719

JOB NO.: 211209 I.D. TPB

FIELDWORK COMP.: 11/04/21 BK. PG.

ALL DISTANCES SHOWN IN FEET AND DECIMAL REF: PARTS THEREOF CORRECTED TO 68° F.