
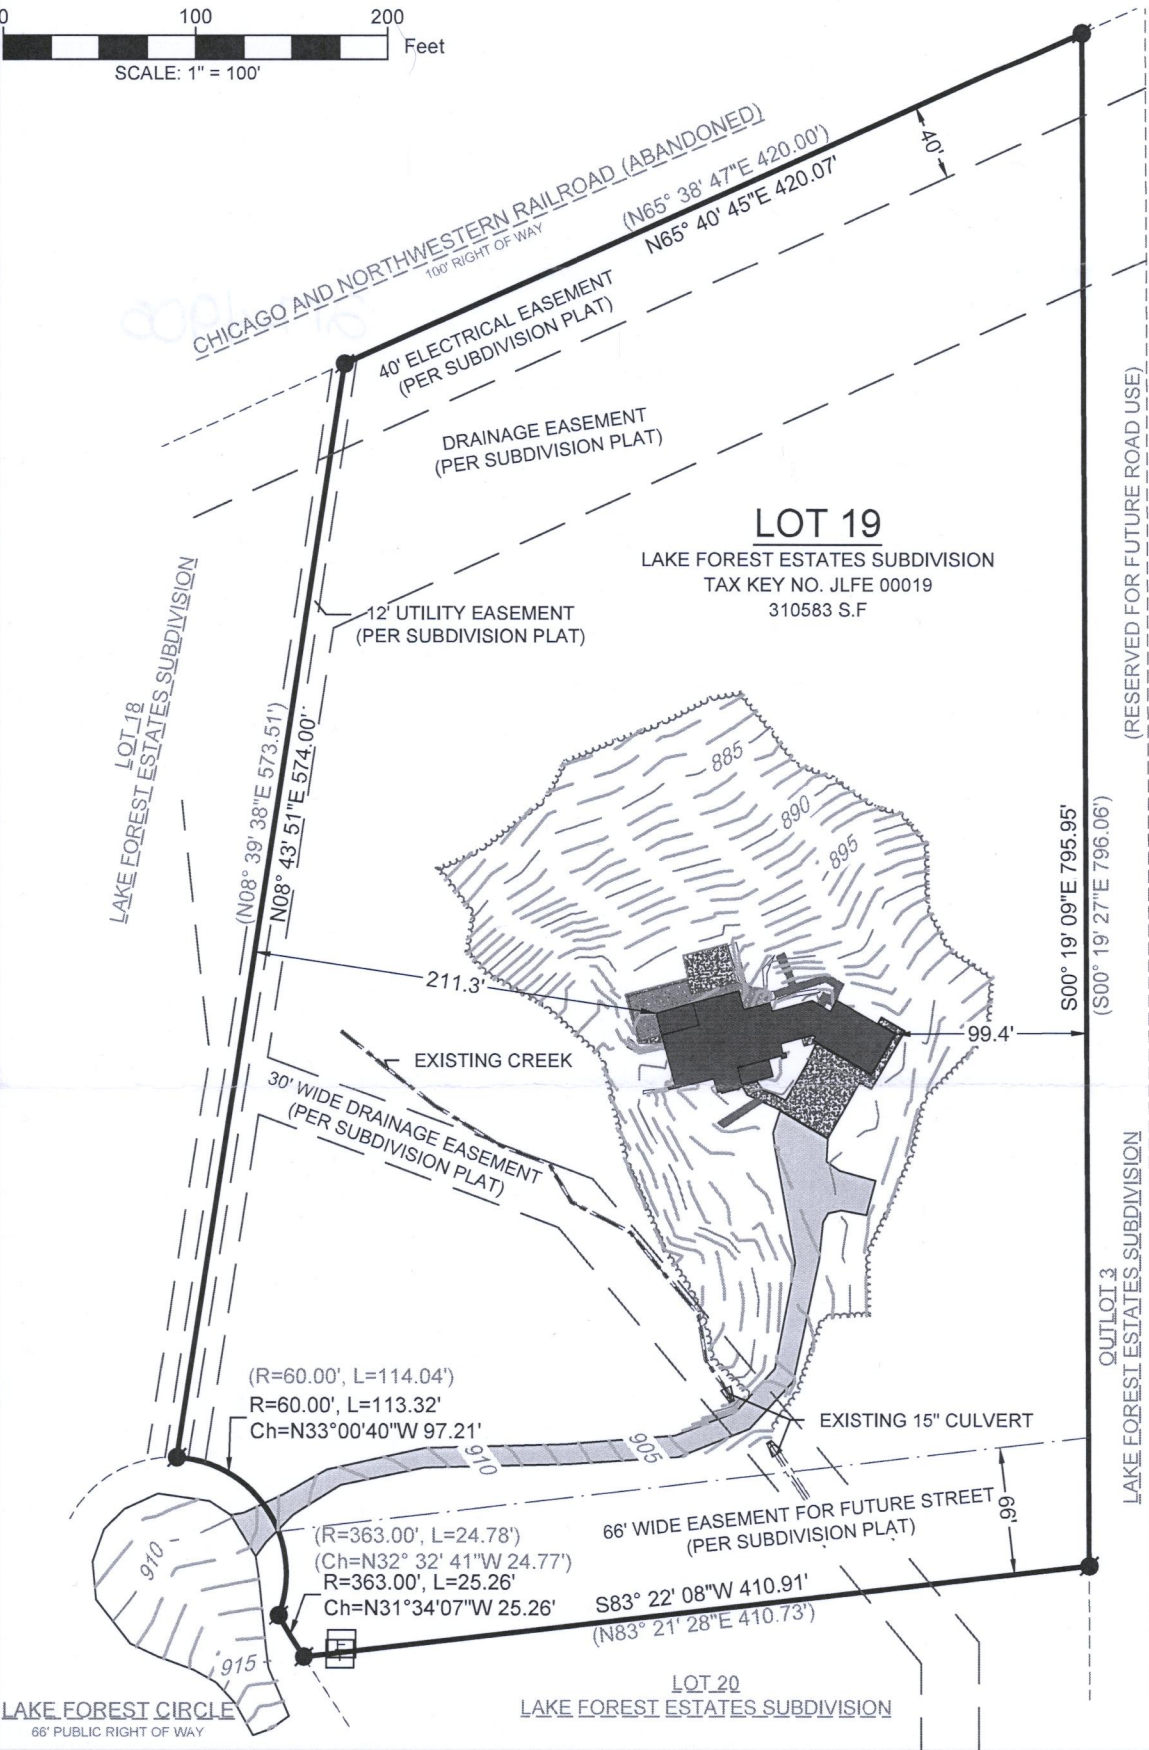
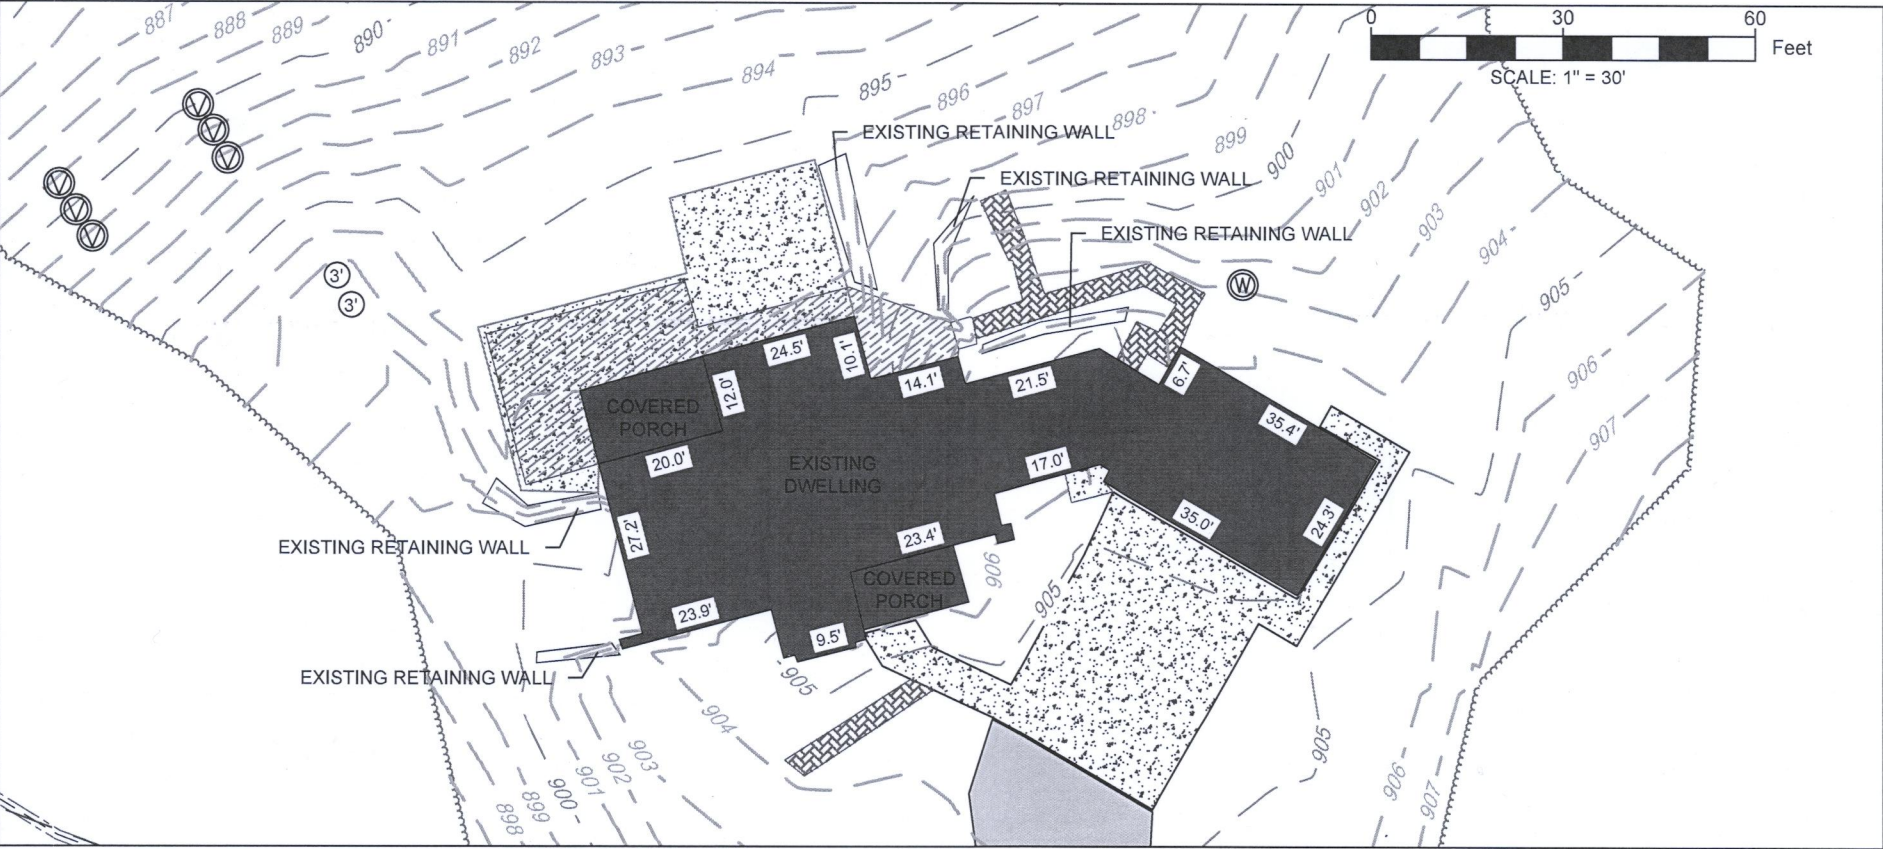


PLAT OF SURVEY

LEGAL DESCRIPTION:
A PARCEL OF LAND LOCATED IN THE SOUTHWEST 1/4 OF THE NORTHWEST AND THE NORTHWEST 1/4 OF THE SOUTHWEST 1/4 OF SECTION 26 IN TOWNSHIP 2 NORTH, RANGE 17 EAST, IN THE TOWN OF GENEVA, WALWORTH COUNTY, WISCONSIN.

MORE PARTICULARLY DESCRIBED AS:

LOT 19 OF THE LAKE FOREST ESTATES SUBDIVISION AS RECORDED IN DOCUMENT NO. 303062 PER THE WALWORTH COUNTY REGISTER OF DEEDS.

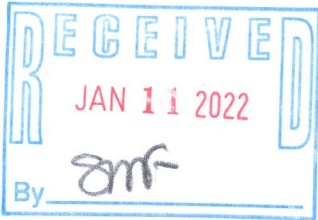

- LEGEND
- EXISTING BUILDING
 - EXISTING ASPHALT
 - EXISTING CONCRETE
 - EXISTING PAVERS
 - EXISTING DECK
 - (xx) RECORDED AS
 - FOUND IRON ROD
 - FOUND WELL
 - FOUND SEPTIC VENT
 - FOUND 3' CONCRETE LID
 - FOUND TELE. PEDESTAL
 - FOUND ELECTRIC PEDESTAL
 - EXISTING TREELINE
 - EXISTING MAJOR CONTOURS
 - EXISTING MINOR CONTOURS

NOTE:

1. BASIS OF BEARING:
THE WISCONSIN STATE PLANE COORDINATE SYSTEM, NAD-83, SOUTH ZONE.
2. FIELD WORK COMPLETED ON:
NOVEMBER 29, 2021
3. BUILDING SURVEYED TO:
THE EXTERIOR OF SIDING.
4. FIELD CREW CHIEF:
RAYMOND MCARDLE


SURVEY ORDERED BY:
ADAM ST. MARIE

PROPERTY ADDRESS:
N3048 LAKE FOREST CIRCLE
LAKE GENEVA, WI 53147

SURVEYOR:
PAUL H. VAN HENKELUM, PLS
CARDINAL ENGINEERING LLC

"I HEREBY CERTIFY THAT I HAVE SURVEYED THE ABOVE DESCRIBED PROPERTY AND THE MAP IS A TRUE AND CORRECT REPRESENTATION OF ITS EXTERIOR BOUNDARIES AND SHOWS THE SIZE AND LOCATION OF ALL VISIBLE STRUCTURES, APPARENT EASEMENTS AND ENCROACHMENTS, IF ANY."

PAUL H. VAN HENKELUM, PLS #1931 DATE 12/17/2021

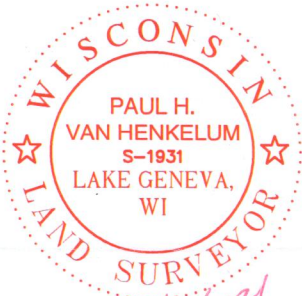

CARDINAL ENGINEERING LLC
DESIGNING IN TRUE DIRECTIONS
PO BOX 281 - 1200 LA SALLE ST.
LAKE GENEVA, WI 53147
262-757-8776
CARDINALENGINEERINGWI.COM

DATE: 12 / 17 / 2021 JOB No. 21559
SHEET 1 OF 1 EJO