
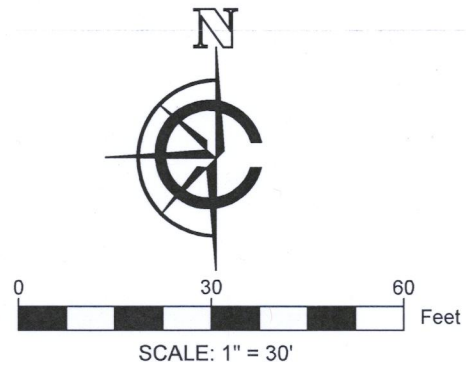


PLAT OF SURVEY

LEGAL DESCRIPTION:
A PARCEL OF LAND LOCATED IN THE NORTHEAST 1/4 OF THE NORTHWEST 1/4 OF SECTION 29 IN TOWNSHIP 2 NORTH, RANGE 17 EAST, IN THE TOWN OF GENEVA, WALWORTH COUNTY, WISCONSIN.


MORE PARTICULARLY DESCRIBED AS
UNIT 19-11 OF GENEVA NATIONAL CONDOMINIUM AS RECORDED IN DOCUMENT NO. 194853 PER THE WALWORTH COUNTY REGISTER OF DEEDS

LOT 19-10

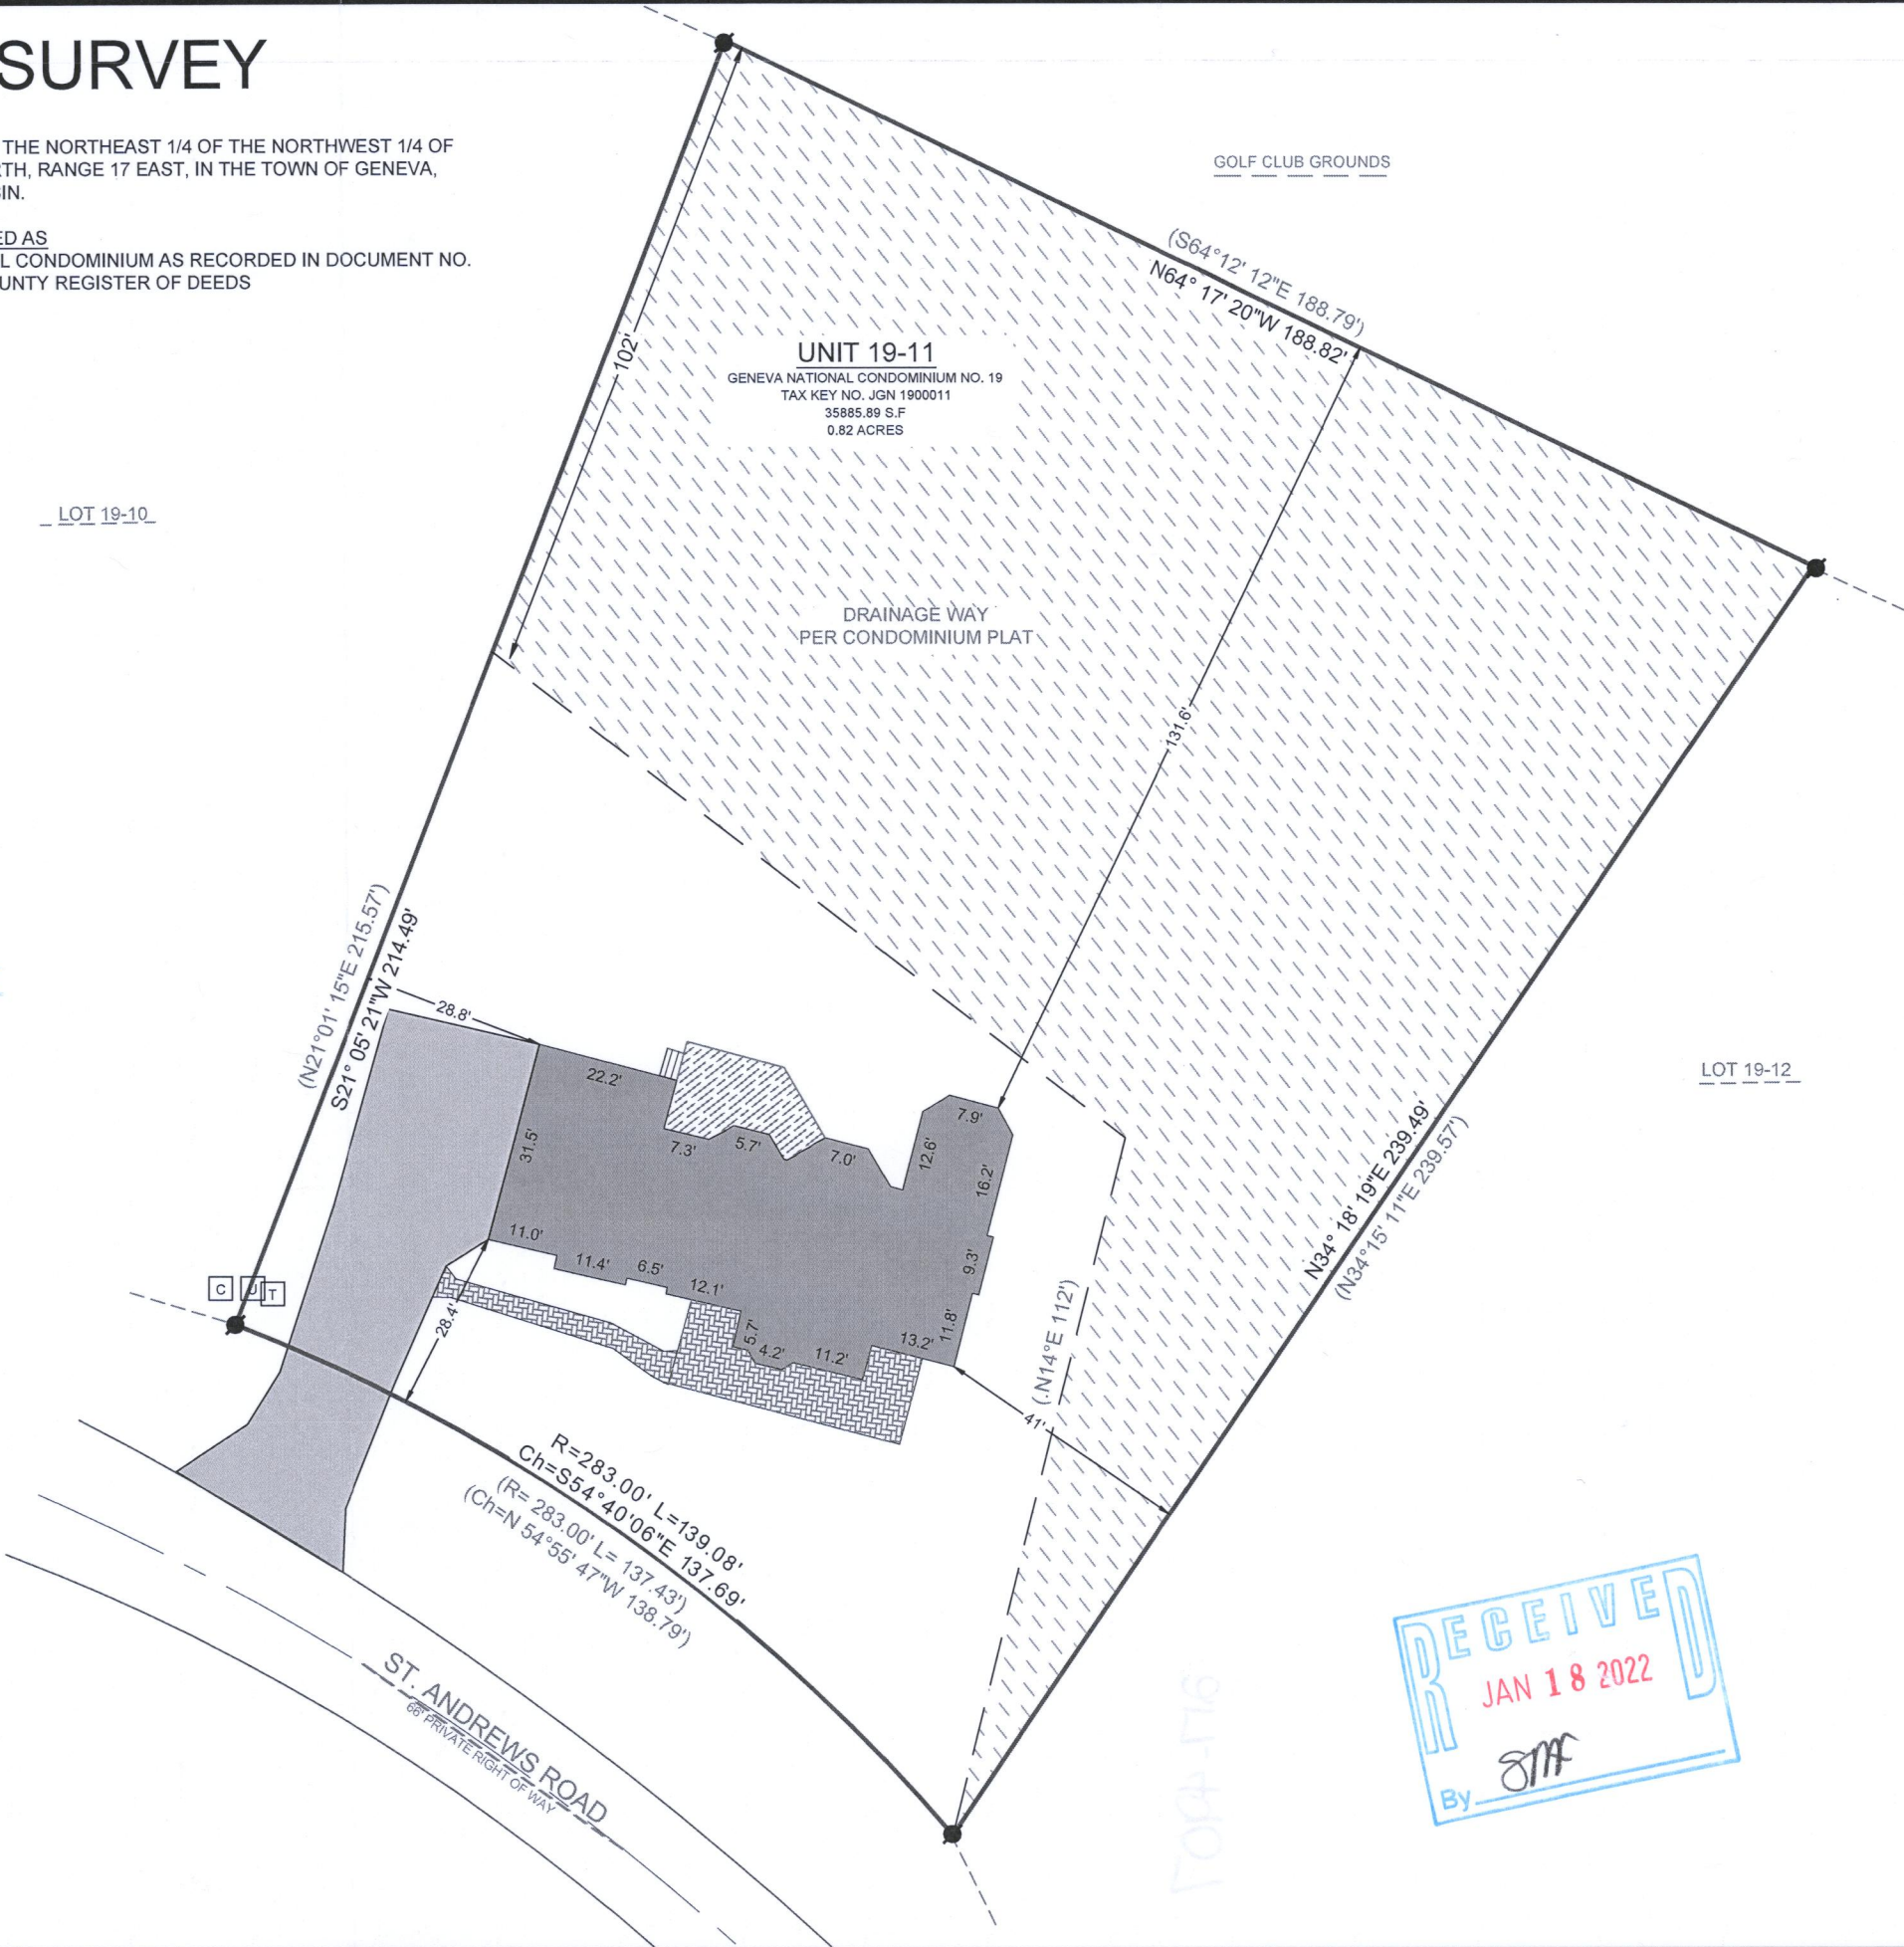

- LEGEND
- | | | | |
|--------------------|-------------------|-------------|------------------------|
| [Solid Grey] | EXISTING BUILDING | [Black Dot] | FOUND IRON ROD |
| [Diagonal Lines] | EXISTING ASPHALT | [U in Box] | FOUND UTILITY PEDESTAL |
| [Cross-hatch] | EXISTING BRICK | [C in Box] | FOUND COMM. PEDESTAL |
| [Horizontal Lines] | EXISTING DECK | [T in Box] | FOUND TELE. PEDESTAL |
| [Wavy Lines] | DRAINAGE WAY | | |
- (xx) RECORDED AS


- NOTE:
1. BASIS OF BEARING:
THE WISCONSIN STATE PLANE COORDINATE SYSTEM,
NAD-83, SOUTH ZONE.
 2. FIELD WORK COMPLETED ON:
JANUARY 6, 2021
 3. BUILDING SURVEYED TO:
THE EXTERIOR OF SIDING.
 4. FIELD CREW CHIEF:
RAYMOND MCARDLE
- SURVEY ORDERED BY:
DEBBIE SCHROEDER
- PROPERTY ADDRESS:
1300 ST. ANDREWS ROAD
LAKE GENEVA, WI 53147
- SURVEYOR:
PAUL H. VAN HENKELUM, PLS
CARDINAL ENGINEERING LLC

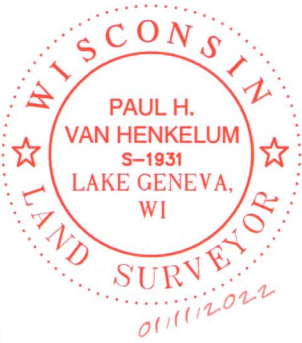

"I HEREBY CERTIFY THAT I HAVE SURVEYED THE ABOVE DESCRIBED PROPERTY AND THE MAP IS A TRUE AND CORRECT REPRESENTATION OF ITS EXTERIOR BOUNDARIES AND SHOWS THE SIZE AND LOCATION OF ALL VISIBLE STRUCTURES, APPARENT EASEMENTS AND ENCROACHMENTS, IF ANY.

Paul H. Van Henkelum
PAUL H VAN HENKELUM, PLS #1931

DATE
01/11/2022

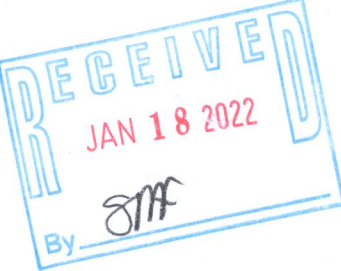



CARDINAL ENGINEERING LLC
DESIGNING IN TRUE DIRECTIONS

PO BOX 281 - 1200 LA SALLE ST.
LAKE GENEVA, WI 53147
262-757-8776
CARDINALENGINEERINGWI.COM

DATE: 01 / 10 / 2022 JOB No. 21578
SHEET 1 OF 1 RM

217-4907