




NOTE:
 Straight Line From A to B
 Straight Line From C to D
 Straight Line From E to F

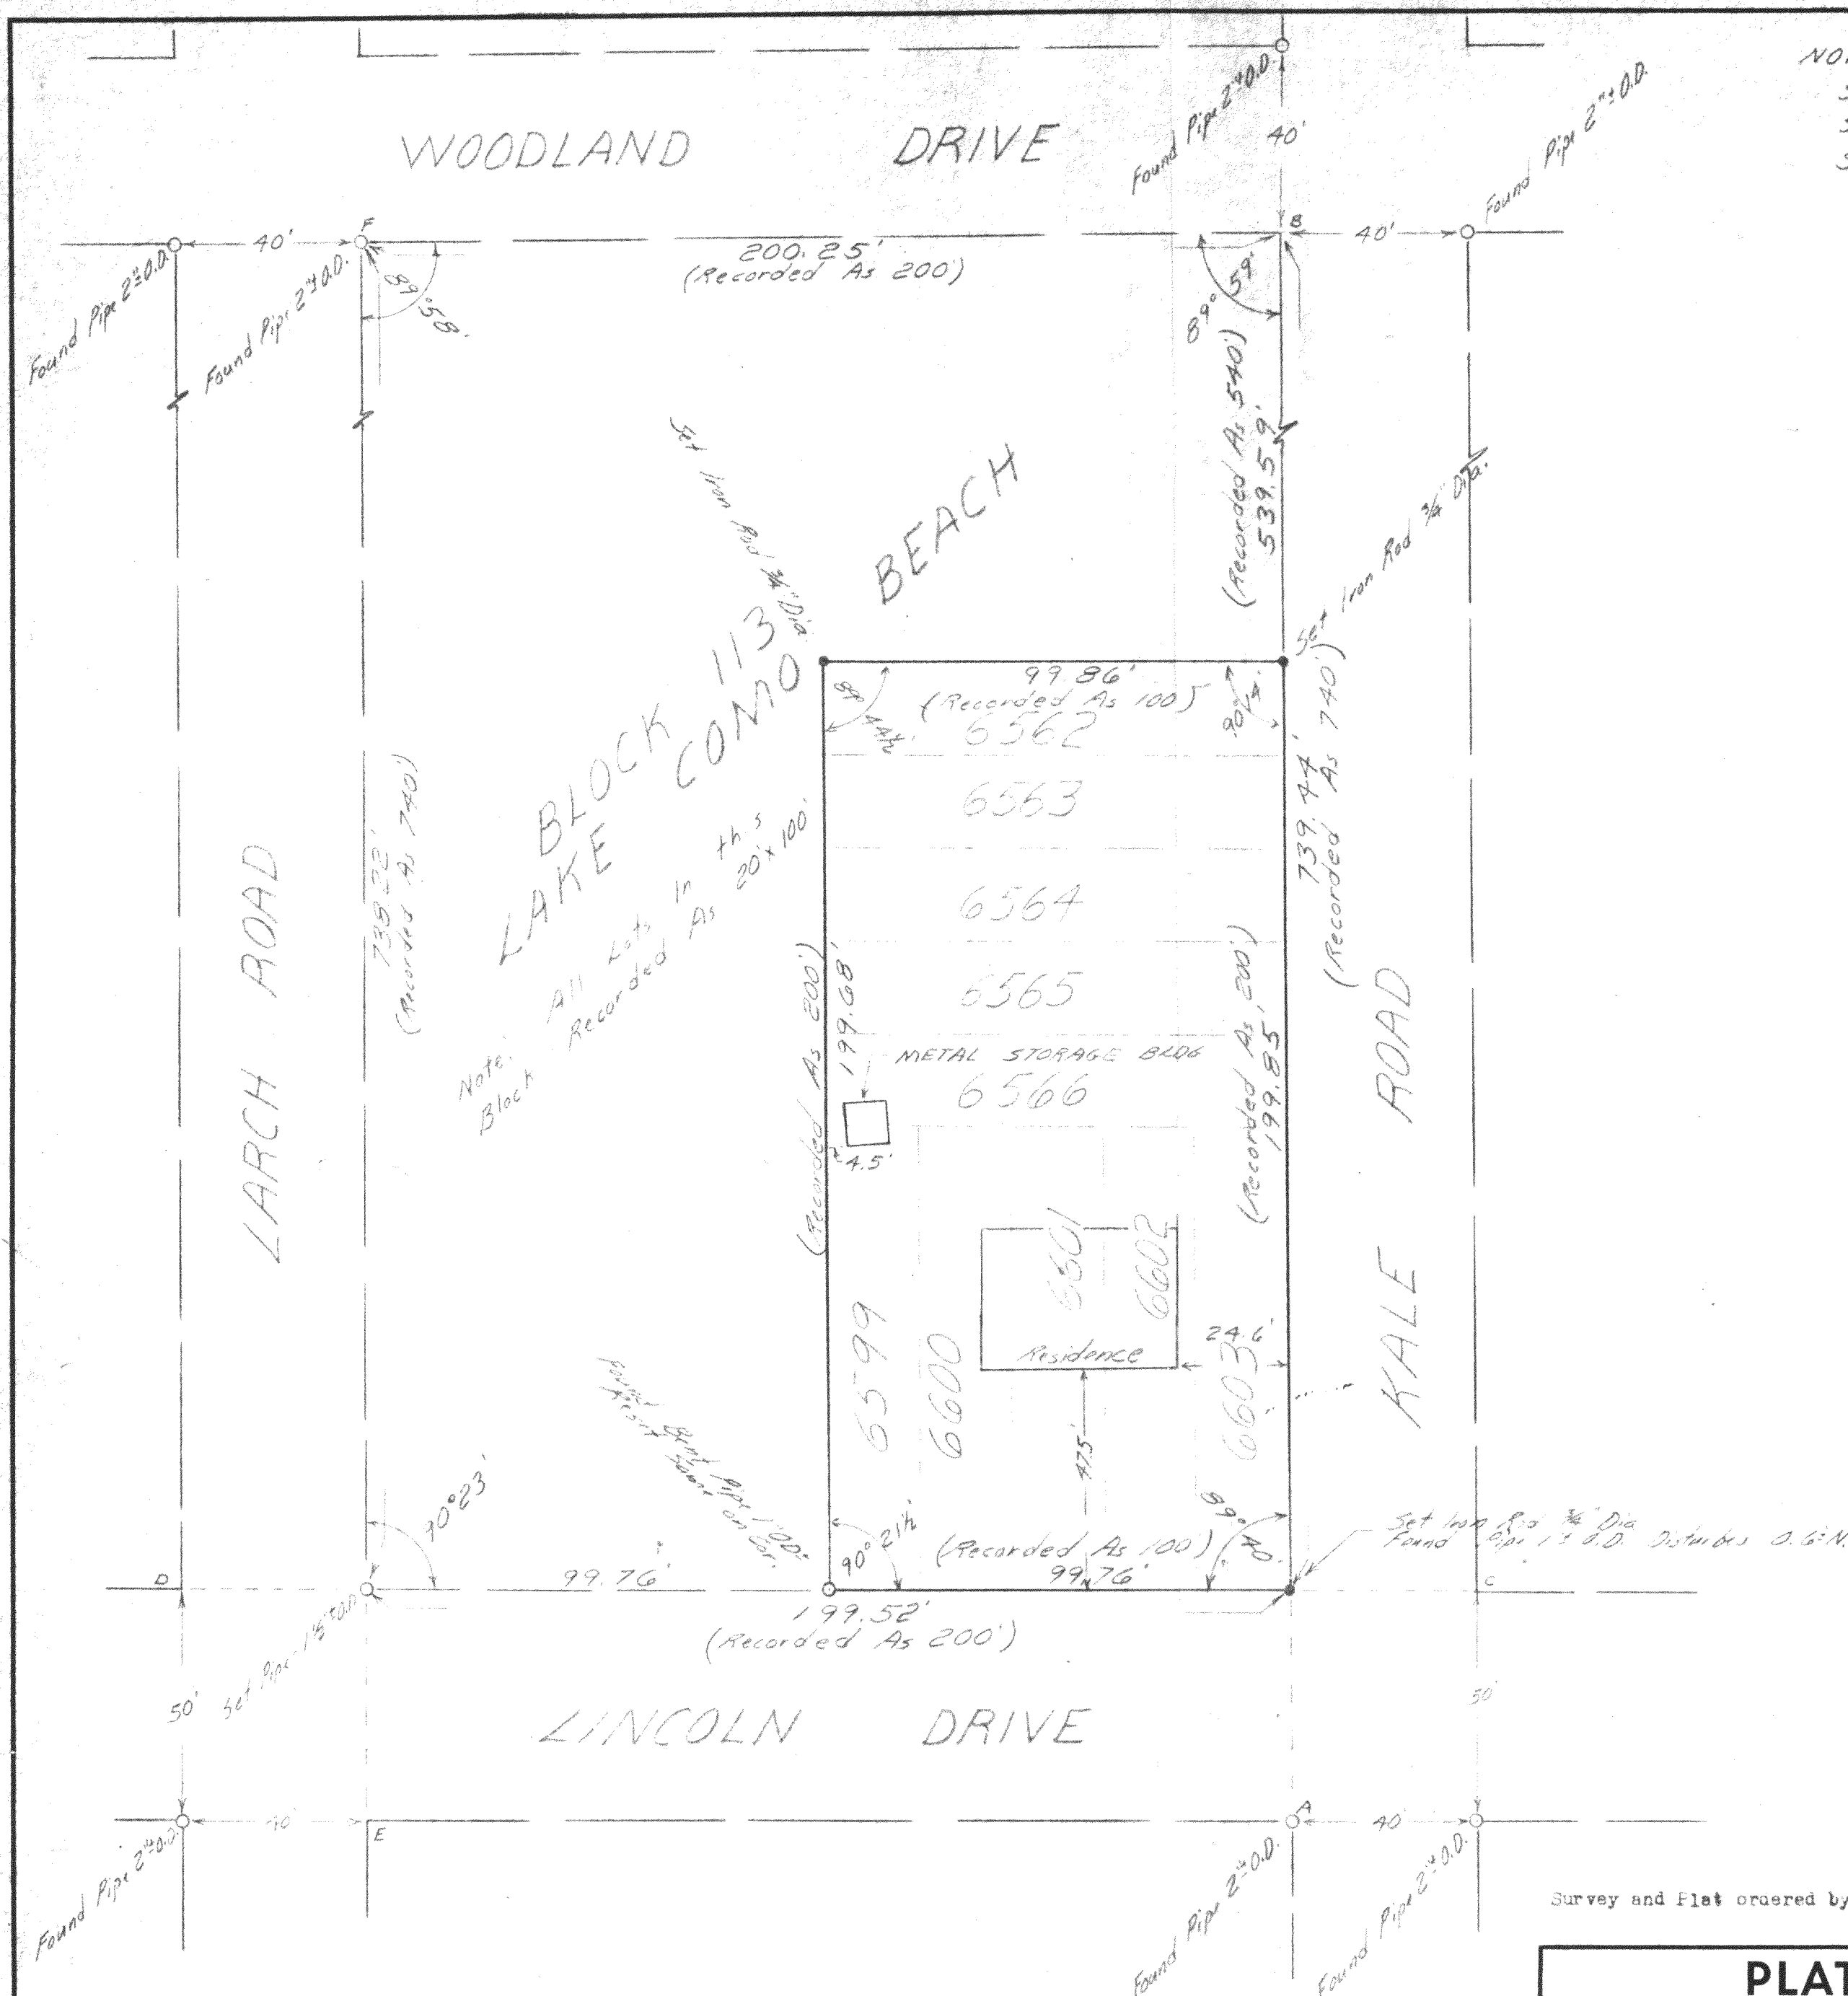

Survey and Plat ordered by Antioch Savings and Loan, Antioch Ill.

PLAT OF SURVEY
OF

Lots 6562, 6563, 6564, 6565, 6566, 6599, 6600, 6601, 6602, and 6603 of Lake Como Beach Subdivision, Located in the Northwest 1/4 of Section 28, Town 2 North, Range 17 East, Walworth County, Wisconsin

SCALE 1" = 30' DATE 20 Aug 1976

I, Lloyd L. Jensen, surveyor, do hereby certify that under my direction the lands shown hereon have been surveyed and mapped, and that this Plat of Survey is a true representation of the lot lines to the best of my knowledge and belief.

Dated this 20th day of Aug. 1976 Lloyd L. Jensen
 Lloyd L. Jensen S-211
 Elkhorn, Wisconsin

