
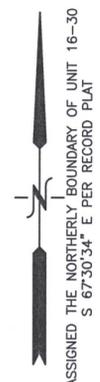


PLAT OF SURVEY

UNIT 16-30 OF GENEVA NATIONAL CONDOMINIUM NO. 16

LOCATED IN PART OF THE NW 1/4 OF THE NE 1/4 OF SECTION 29, TOWN 2 NORTH, RANGE 17 EAST,
WALWORTH COUNTY, WISCONSIN

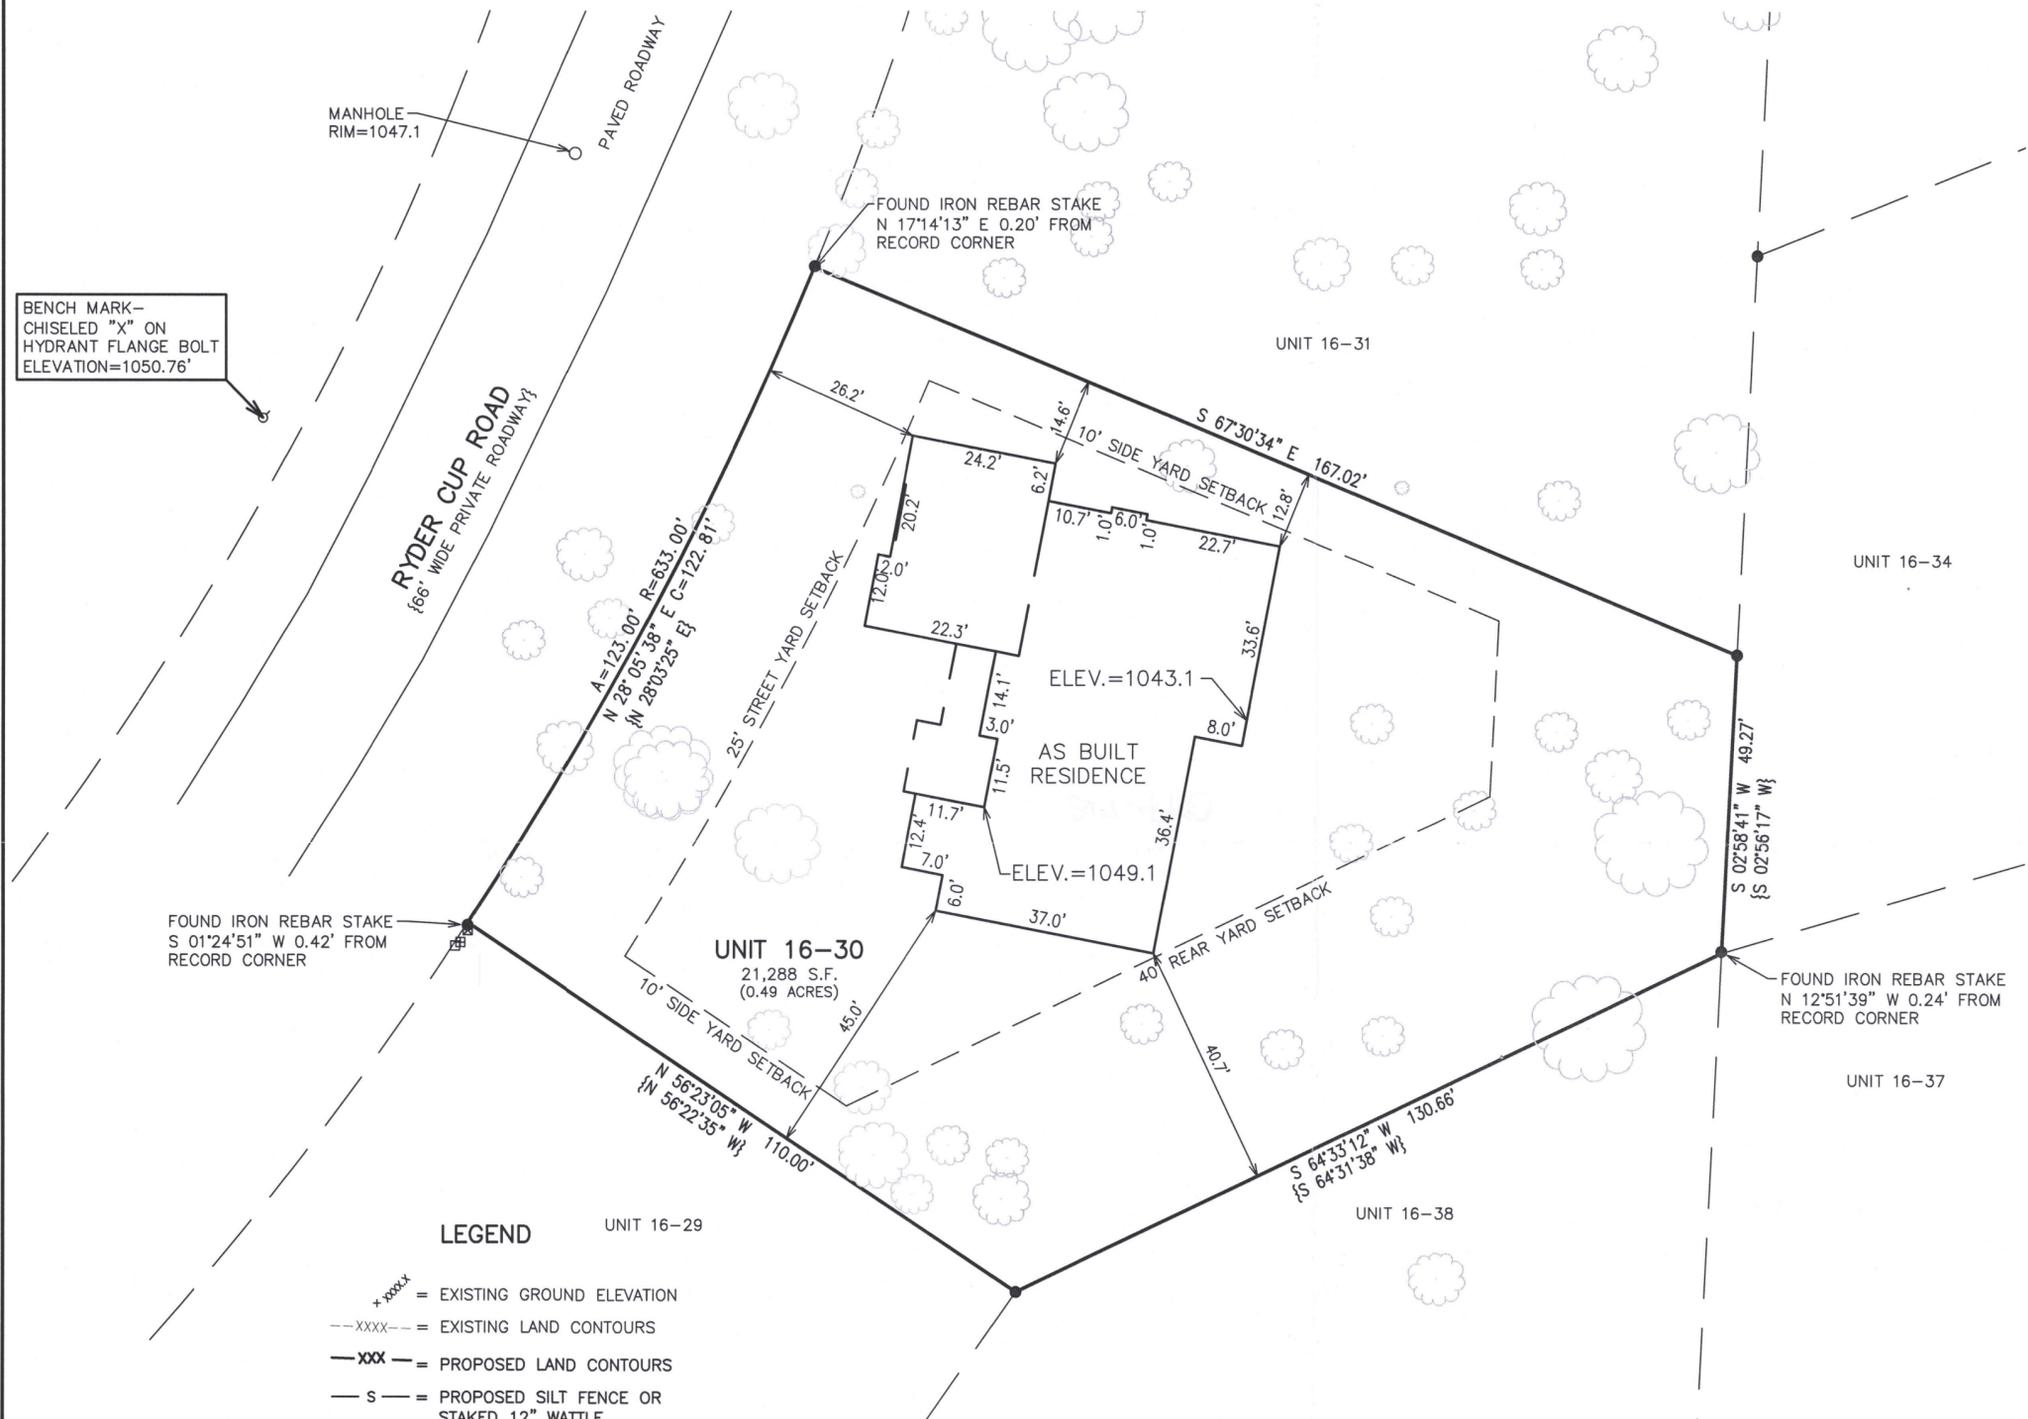

AS-BUILT
GENEVA NATIONAL UNIT 16-30
LAKE GENEVA, WISCONSIN

— WORK ORDERED BY —
OMEGA HOMES, INC.
210 E. O'CONNOR DRIVE, SUITE 101
ELKHORN, WI 53121

FARRIS, HANSEN & ASSOCIATES, INC.
ENGINEERING — ARCHITECTURE — SURVEYING
7 RIDGWAY COURT P.O. BOX 437
ELKHORN, WISCONSIN 53121
OFFICE: (262) 723-2098 FAX: (262) 723-5886

REVISIONS
01/31/2022 - ADD SETBACK DIMENSIONS
02/21/2022 - TS REVISE BUILDING DIMENSIONS
5/24/22 - DHC AS BUILT DRAWING
5/31/22 - DHC REVISED AS-BUILT



NOTE: COPIES OF THIS MAP TO WHICH THE FOLLOWING CERTIFICATE WILL APPLY SHOW THE SURVEYOR'S ORIGINAL SEAL AND SIGNATURE IN RED INK. COPIES BY ANY OTHER MEANS MAY HAVE ALTERATIONS WHICH DO NOT REPRESENT THE SURVEYOR'S WORK PRODUCT.

I HEREBY CERTIFY THAT THE ABOVE DESCRIBED PROPERTY HAS BEEN SURVEYED UNDER MY DIRECTION AND THAT THE ABOVE MAP IS A TRUE REPRESENTATION THEREOF AND SHOWS THE SIZE AND LOCATION OF THE PROPERTY AND ITS EXTERIOR BOUNDARIES. THIS SURVEY IS MADE FOR THE USE OF THE PRESENT OWNERS OF THE PROPERTY, AND ALSO THOSE WHO PURCHASE, MORTGAGE, OR GUARANTEE THE TITLE THERETO WITHIN ONE YEAR FROM THE DATE HEREOF.



DATED: 10/25/2021

Christopher A. Hodges
CHRISTOPHER A. HODGES P.L.S. 2760



X:\PROJECTS\3269\CONDO_16\UNIT_30\CAD\3269-16-30.dwg

JGN 16-30

017-4980