


PLAT OF SURVEY – ASBUILT GENEVA NATIONAL CONDOMINIUM NO.3 UNIT 3-04

ST. MORITZ COURT

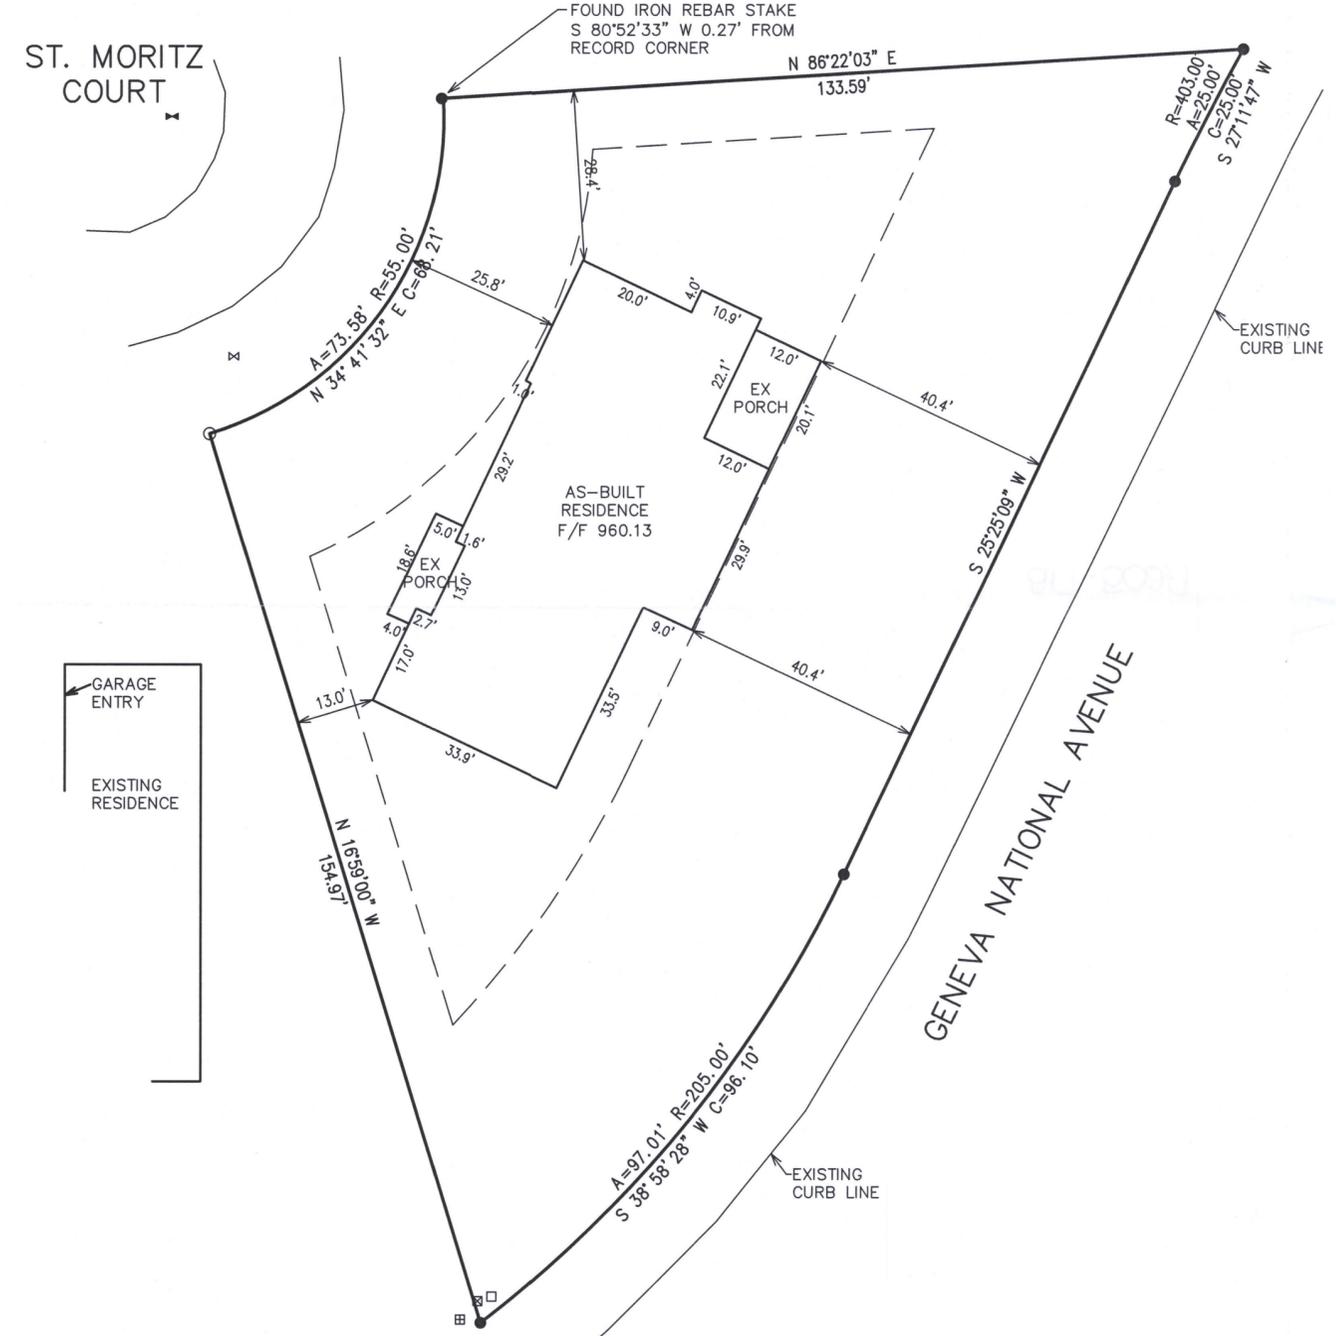

ASSIGNED THE EAST PROPERTY LINE FROM
 KROTT SURVEY, INC DATED 7/3/12 S 01°07'12" W

GENEVA NATIONAL AVENUE

RECEIVED
 NOV 14 2022
 By *smk*

NOTE: COPIES OF THIS MAP TO WHICH THE FOLLOWING CERTIFICATE WILL APPLY SHOW THE SURVEYOR'S ORIGINAL SEAL AND SIGNATURE IN RED INK. COPIES BY ANY OTHER MEANS MAY HAVE ALTERATIONS WHICH DO NOT REPRESENT THE SURVEYOR'S WORK PRODUCT.

I HEREBY CERTIFY THAT THE ABOVE DESCRIBED PROPERTY HAS BEEN SURVEYED UNDER MY DIRECTION AND THAT THE ABOVE MAP IS A TRUE REPRESENTATION THEREOF AND SHOWS THE SIZE AND LOCATION OF THE PROPERTY AND ITS EXTERIOR BOUNDARIES. THIS SURVEY IS MADE FOR THE USE OF THE PRESENT OWNERS OF THE PROPERTY, AND ALSO THOSE WHO PURCHASE, MORTGAGE, OR GUARANTEE THE TITLE THERETO WITHIN ONE YEAR FROM THE DATE HEREOF.

DATED: Oct 31, 2022

Christopher A. Hodges
 CHRISTOPHER A. HODGES P.L.S. 2760



X:\Acad_Std\Carlson\TITLE BLOCKS\FHA 18x24.dwg

JEN 3-04

217_5039



ASBUILT
 GENEVA NATIONAL CONDO 3 UNIT 3-04

— WORK ORDERED BY —
 OMEGA HOMES, LLC
 210 EST O'CONNOR DRIVE, SUITE 101
 ELKHORN, WI 53121

FARRIS, HANSEN & ASSOCIATES, INC.
 ENGINEERING — ARCHITECTURE — SURVEYING
 7 RIDGWAY COURT P.O. BOX 437
 ELKHORN, WISCONSIN 53121
 OFFICE: (262) 723-2098 FAX: (262) 723-5886

REVISIONS

PROJECT NO. 3269-03-04.21	DATE: 07/15/2021
SHEET NO. 1 OF 1	