


HAROLD H. KOLB

REGISTERED PROFESSIONAL LAND SURVEYOR
LAKE GENEVA, WISCONSIN

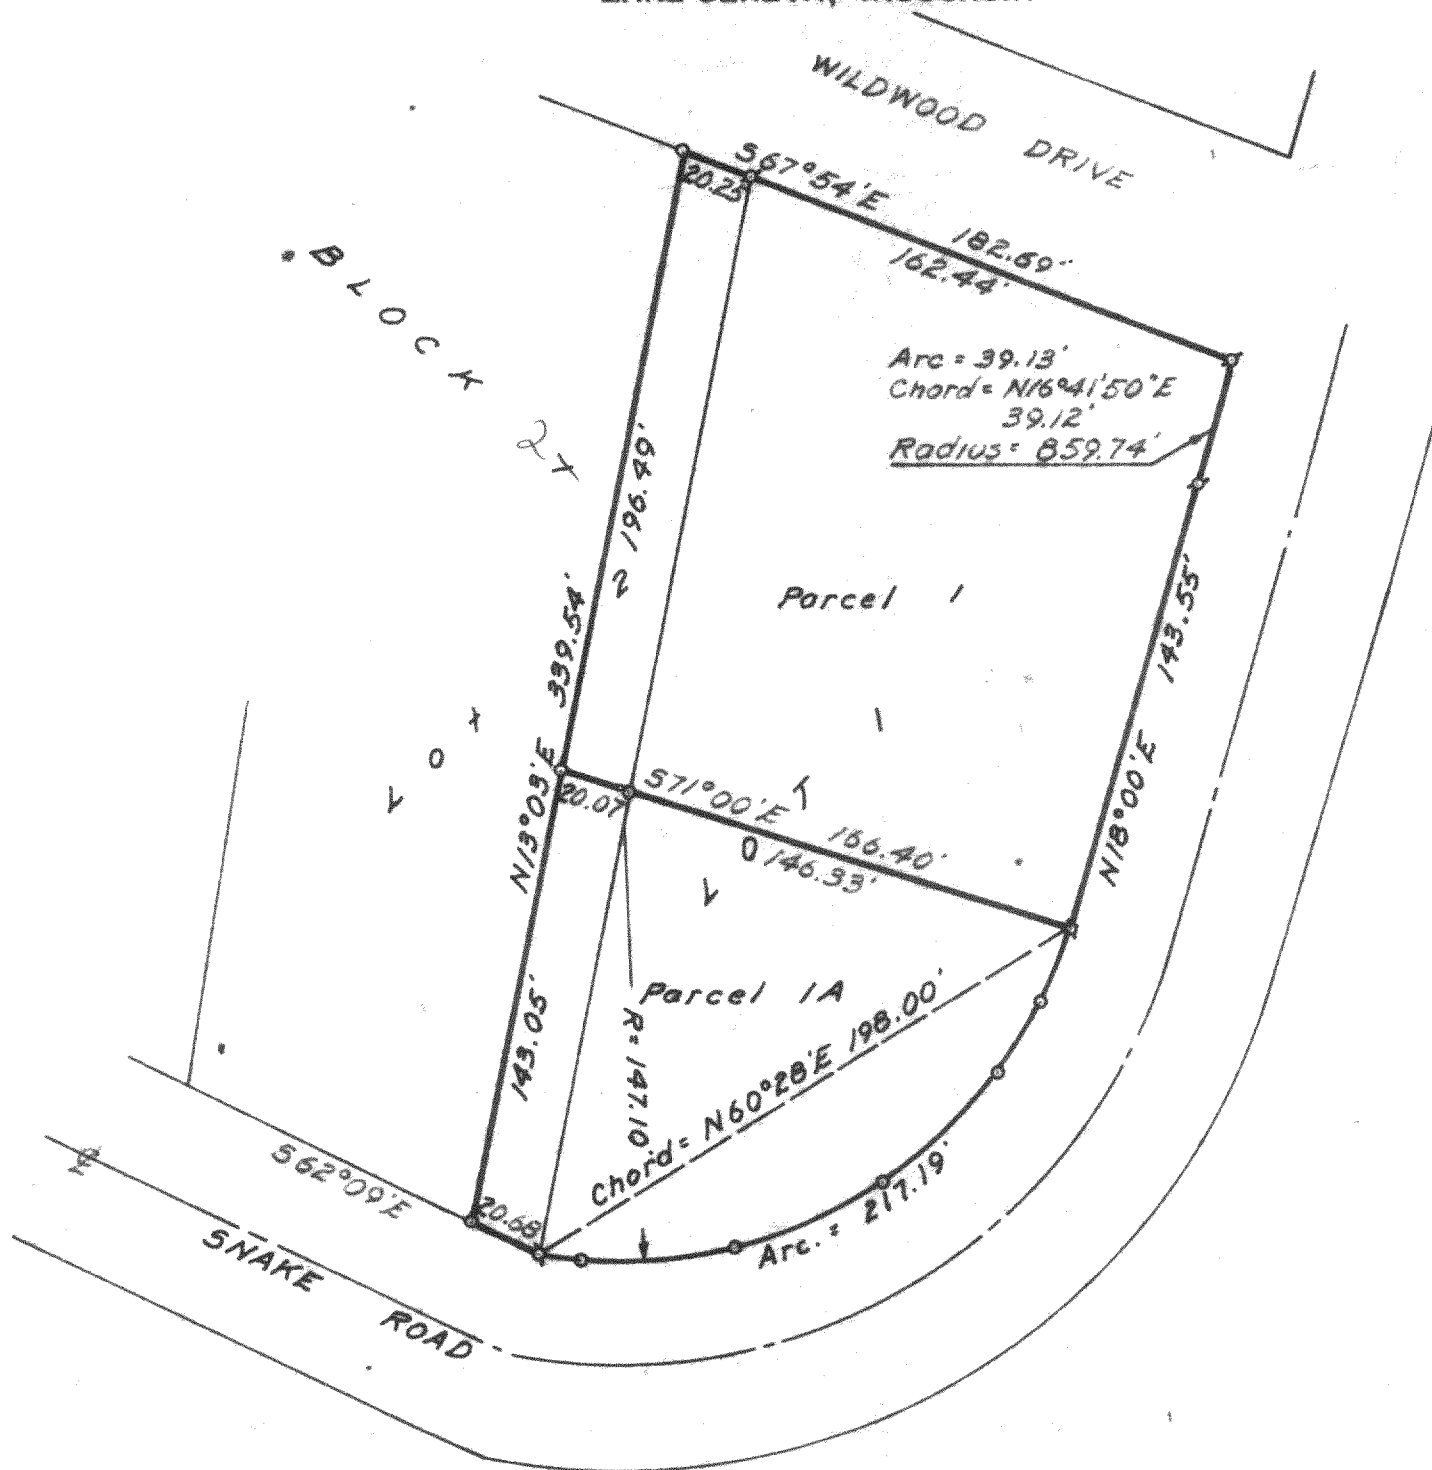

PLAT OF

Two parcels of land, each being part of Lots 1 and 2, Block 1, Geneva Jay Estate, located in the Southwest 1/4 of Section 35, T 2 N, R 17 E, Walworth County, Wisconsin and described as follows; to-wit:

PARCEL 1

Beginning at the Northeast corner of said Lot 1; thence N 67° 54' W 182.69 feet; thence S 13° 03' W 196.40 feet; thence S 71° 00' E 166.40 feet; thence N 18° 00' E 143.55 feet; thence along the arc of a curve to the left 39.13 feet, the radius of which is 859.74 feet and the chord is N 16° 41' 50" E 39.12 feet, to the place of beginning.


Containing 33,000 sq. ft. more or less

PARCEL 1A


Commencing at the Northeast corner of said Lot 1; thence S 16° 41' 50" W 39.12 feet; thence S 18° 00' W 143.55 feet to the place of beginning; thence along the arc of a curve to the right 217.19 feet, the radius of which is 147.10 feet and the chord is S 60° 28' W 198.00 feet; thence N 62° 09' W 20.68 feet; thence S 13° 03' E 143.05 feet; thence S 71° 00' E 166.40 feet to the place of beginning. Containing 19,000 sq. ft. more or less.

Iron pipe relocated and replaced.

Date: September 17, 1976.

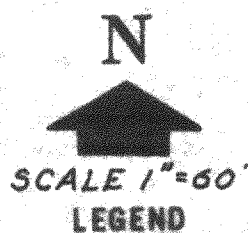

- LEGEND**
- - IRON PIPE FOUND
 - - IRON PIPE PLACED
 - - CONCRETE MONUMENT
 - x - SPIKE

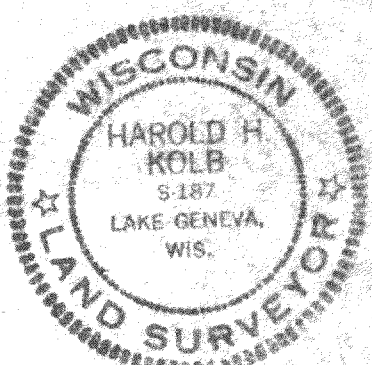

I, HAROLD H. KOLB, DO HEREBY CERTIFY THAT I HAVE SURVEYED THE PROPERTY HEREON DESCRIBED ACCORDING TO THE OFFICIAL RECORDS, AND THAT THE PLAT HEREON IS A CORRECT REPRESENTATION OF THE LOT LINES.

Harold H. Kolb
HAROLD H. KOLB
WISCONSIN REGISTERED LAND SURVEYOR, S-187
DATE October 21, 1965
Revised: September 17, 1976

JGBE-29 (RVD)

217-516

B-26-44