

May 31, 2024

PLAT OF SURVEY

Survey No. 24.6001.02

LOCATION: 1314 Gullane Ct, Lake Geneva, WI 53147



PREPARED FOR: Kevin & Lisa Rudy

PROPERTY DESCRIPTION: Per Document No. 1066495

Unit 15-15, Geneva National Condominium No. 15, created by a "Declaration of Condominium" recorded on May 25, 1990, in Volume 487 of Records, pages 447, as Document No. 194634, together with any amendments and/or corrections thereto, and by its Condominium Plat and any amendments and/or corrections thereto. Said condominium being located in the town of Geneva, County of Walworth, and State of Wisconsin.

CURRENT OWNER: Kenlin Family Trust

TAX ID: JGN 1500015

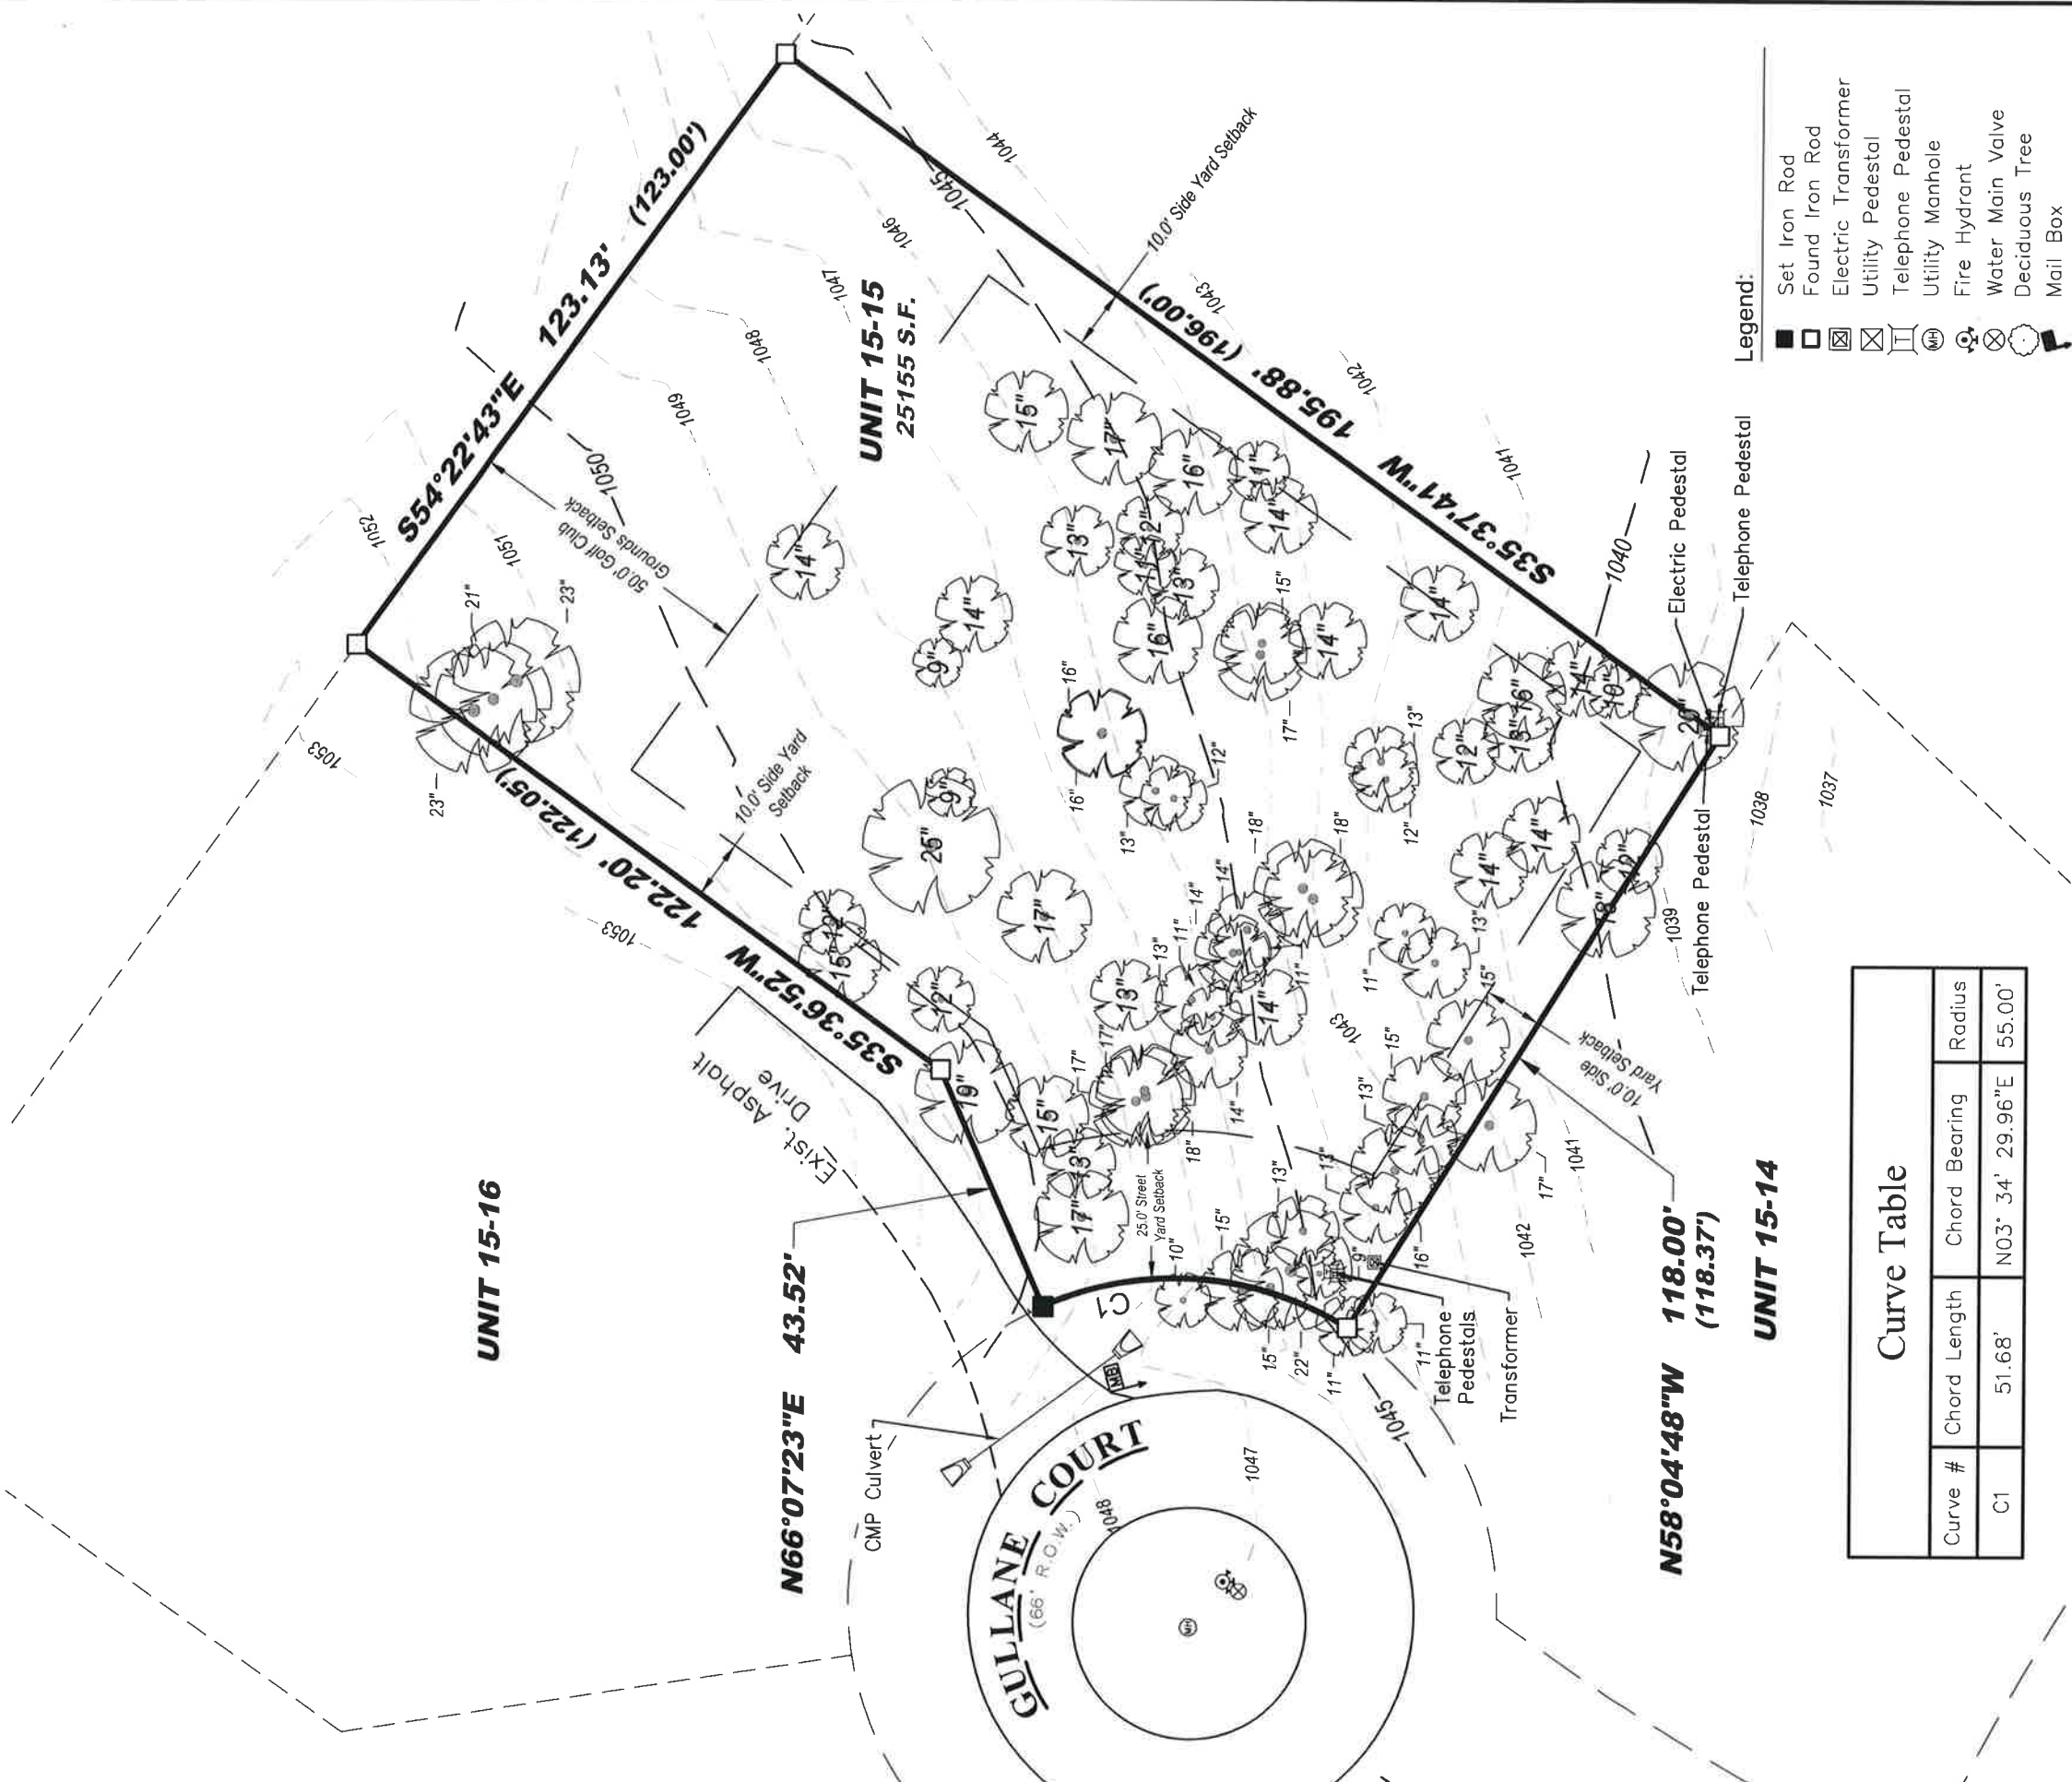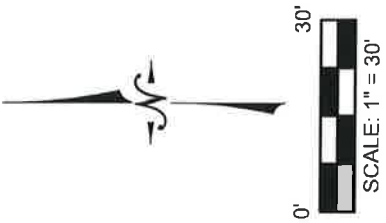

Curve Table			
Curve #	Chord Length	Chord Bearing	Radius
C1	51.68'	N03° 34' 29.96"E	55.00'



I certify that I have surveyed the above-described property and in my professional opinion this map is a true representation thereof and is made in accordance with the records of the register of deeds as nearly as practical and that this survey complies with Wisconsin Administrative code AE-7 except for those items waived, if any, and is bound by Wisconsin State Statute 893.37 that defines statute of limitations in regard to surveys. This survey was prepared for the exclusive use of the client and present owners of the property.

LYNCH & ASSOCIATES
ENGINEERING CONSULTANTS, LLC
5482 S. WESTRIDGE DRIVE
NEW BERLIN, WI 53151
440 MILWAUKEE AVENUE
BURLINGTON, WI 53105
(262) 402-5040

No title policy has been provided to the surveyor regarding the property identified on this map. Therefore this plat of survey does not guarantee the existence, size and location of any easements, encumbrances, restrictions or other facts that could otherwise be disclosed in an ALTA/NSPS survey.

Christopher A. Hodges, Professional Land Surveyor, S-2760

DRAWING BY: JMM
FIELD WORK BY: LMG
FIELD WORK DATE: 05/23/2024