


HAROLD H. KOLB


REGISTERED PROFESSIONAL LAND SURVEYOR
LAKE GENEVA, WISCONSIN

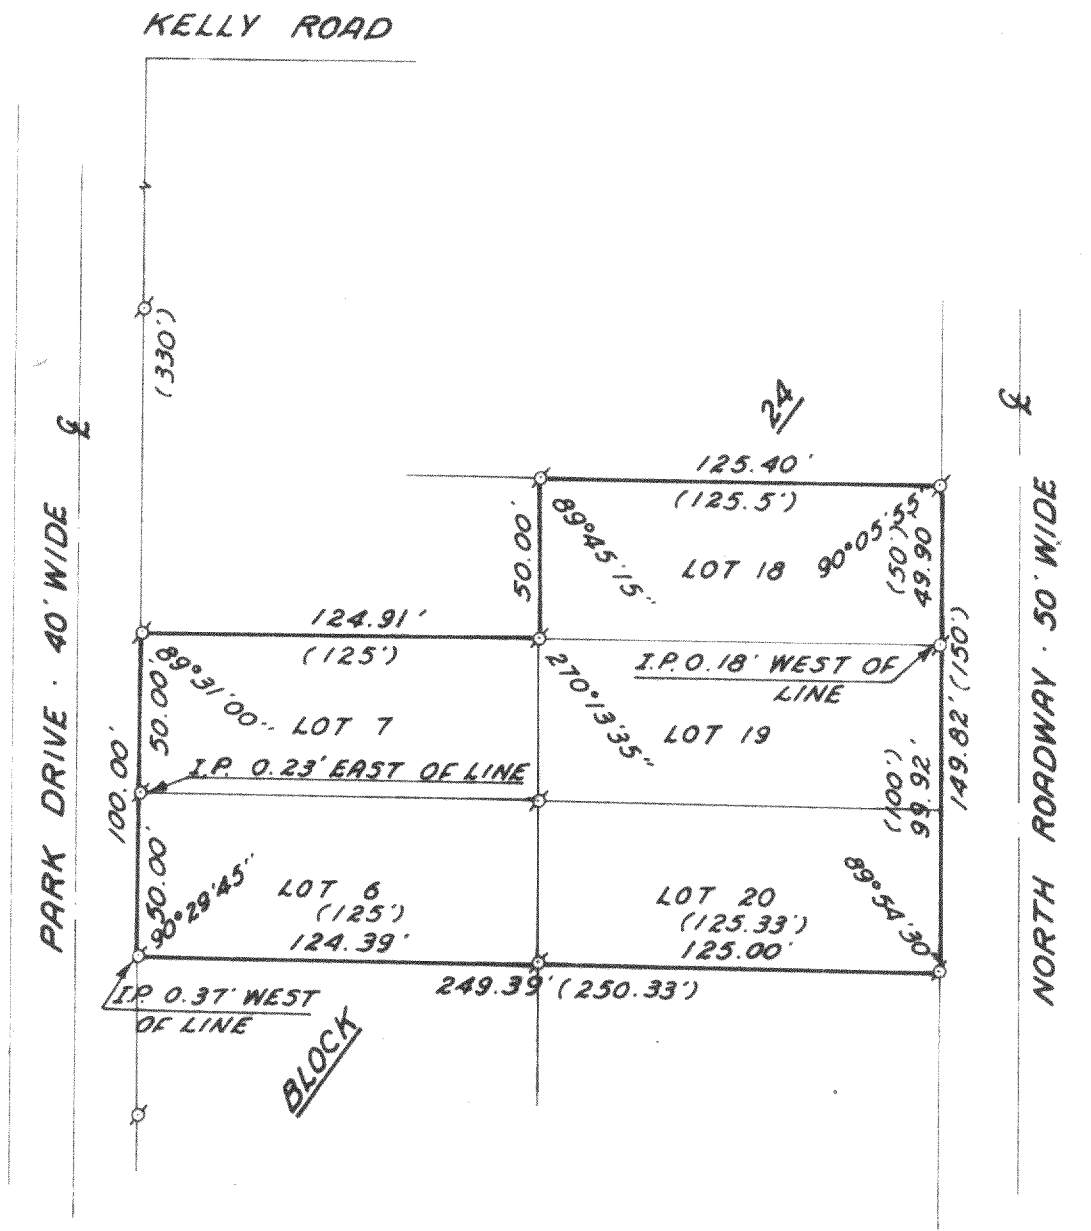

PLAT OF SURVEY OF

LOTS 6-7 AND 18-20, BLOCK 24,
SUNSET HILLS SUBDIVISION, T2N,
R17E, WALWORTH COUNTY, WISCONSIN.

OWNER: FRANK MAY

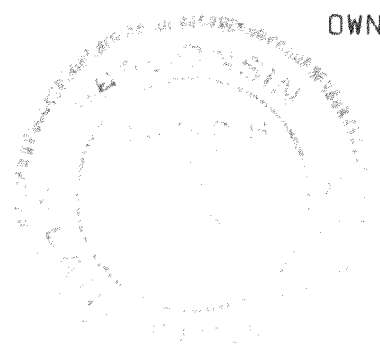

ACCURACY: DISTANCES ± 0.01
ANGLES $\pm 05''$

ERROR OF CLOSURE--LESS THAN
ONE PART IN 3000



SCALE: 1"=60'

LEGEND

- O — IRON PIPE PLACED, 1" x 24" 1.13 LB./LIN. FT.
- — CONCRETE MONUMENT, 5" DIA. x 30"
- () — PLATTED AS

Harold H. Kolb
HAROLD H. KOLB
WISCONSIN REGISTERED LAND SURVEYOR, S-187
DATE March 28, 1977

217-519