


HAROLD H. KOLB

REGISTERED PROFESSIONAL LAND SURVEYOR
LAKE GENEVA, WISCONSIN

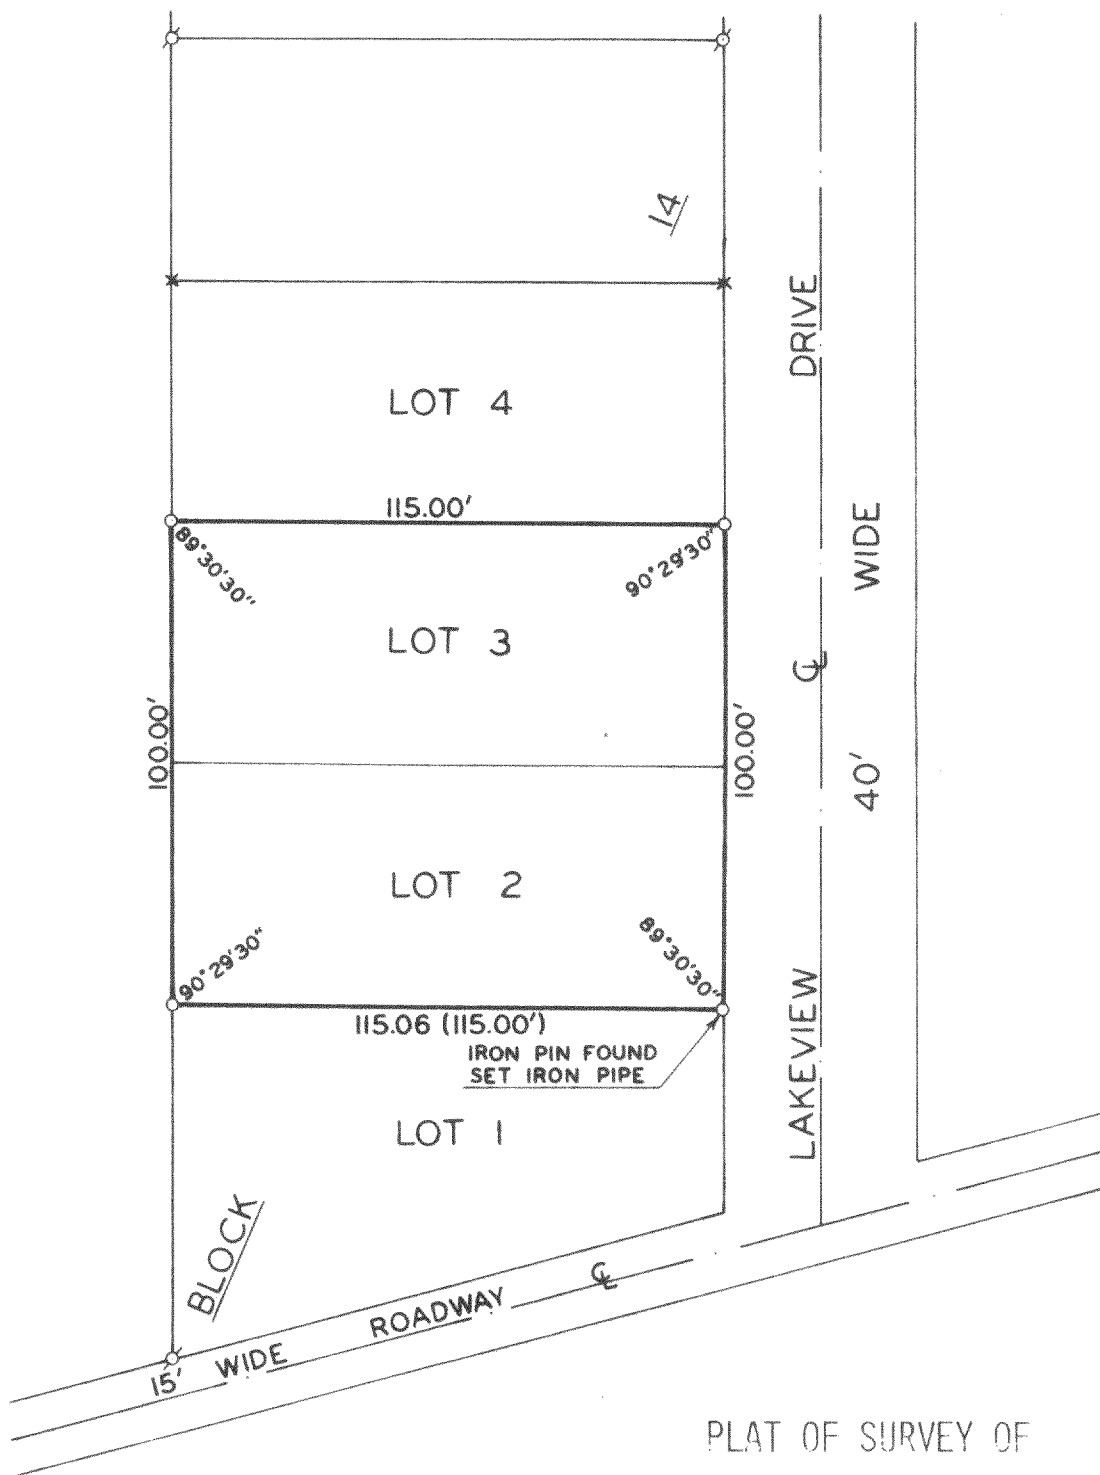


PLAT OF SURVEY OF

LOTS 2 AND 3, BLOCK 14, SUNSET HILLS
SUBDIVISION, UNIT B, T 2 N, R 17 E,
WALWORTH COUNTY, WISCONSIN.

ORDERED BY:
CHARLES MIZE

ACCURACY: DISTANCES $\pm$ 0.01'
ANGLES $\pm$ 05"

ERROR OF CLOSURE--LESS THAN
ONE PART IN 3000

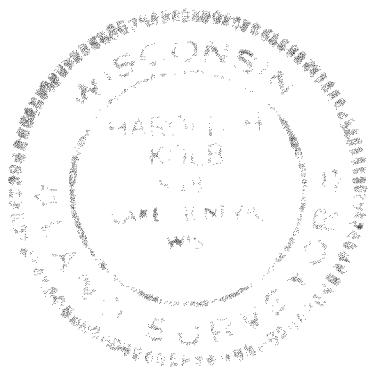

N



SCALE: 1" = 30'

LEGEND

- O - IRON PIPE PLACED
- x - IRON PIPE FOUND
- () - AS PLATTED

Harold H. Kolb

HAROLD H. KOLB
WISCONSIN REGISTERED LAND SURVEYOR, S-187

DATE March 25, 1977

217-520