
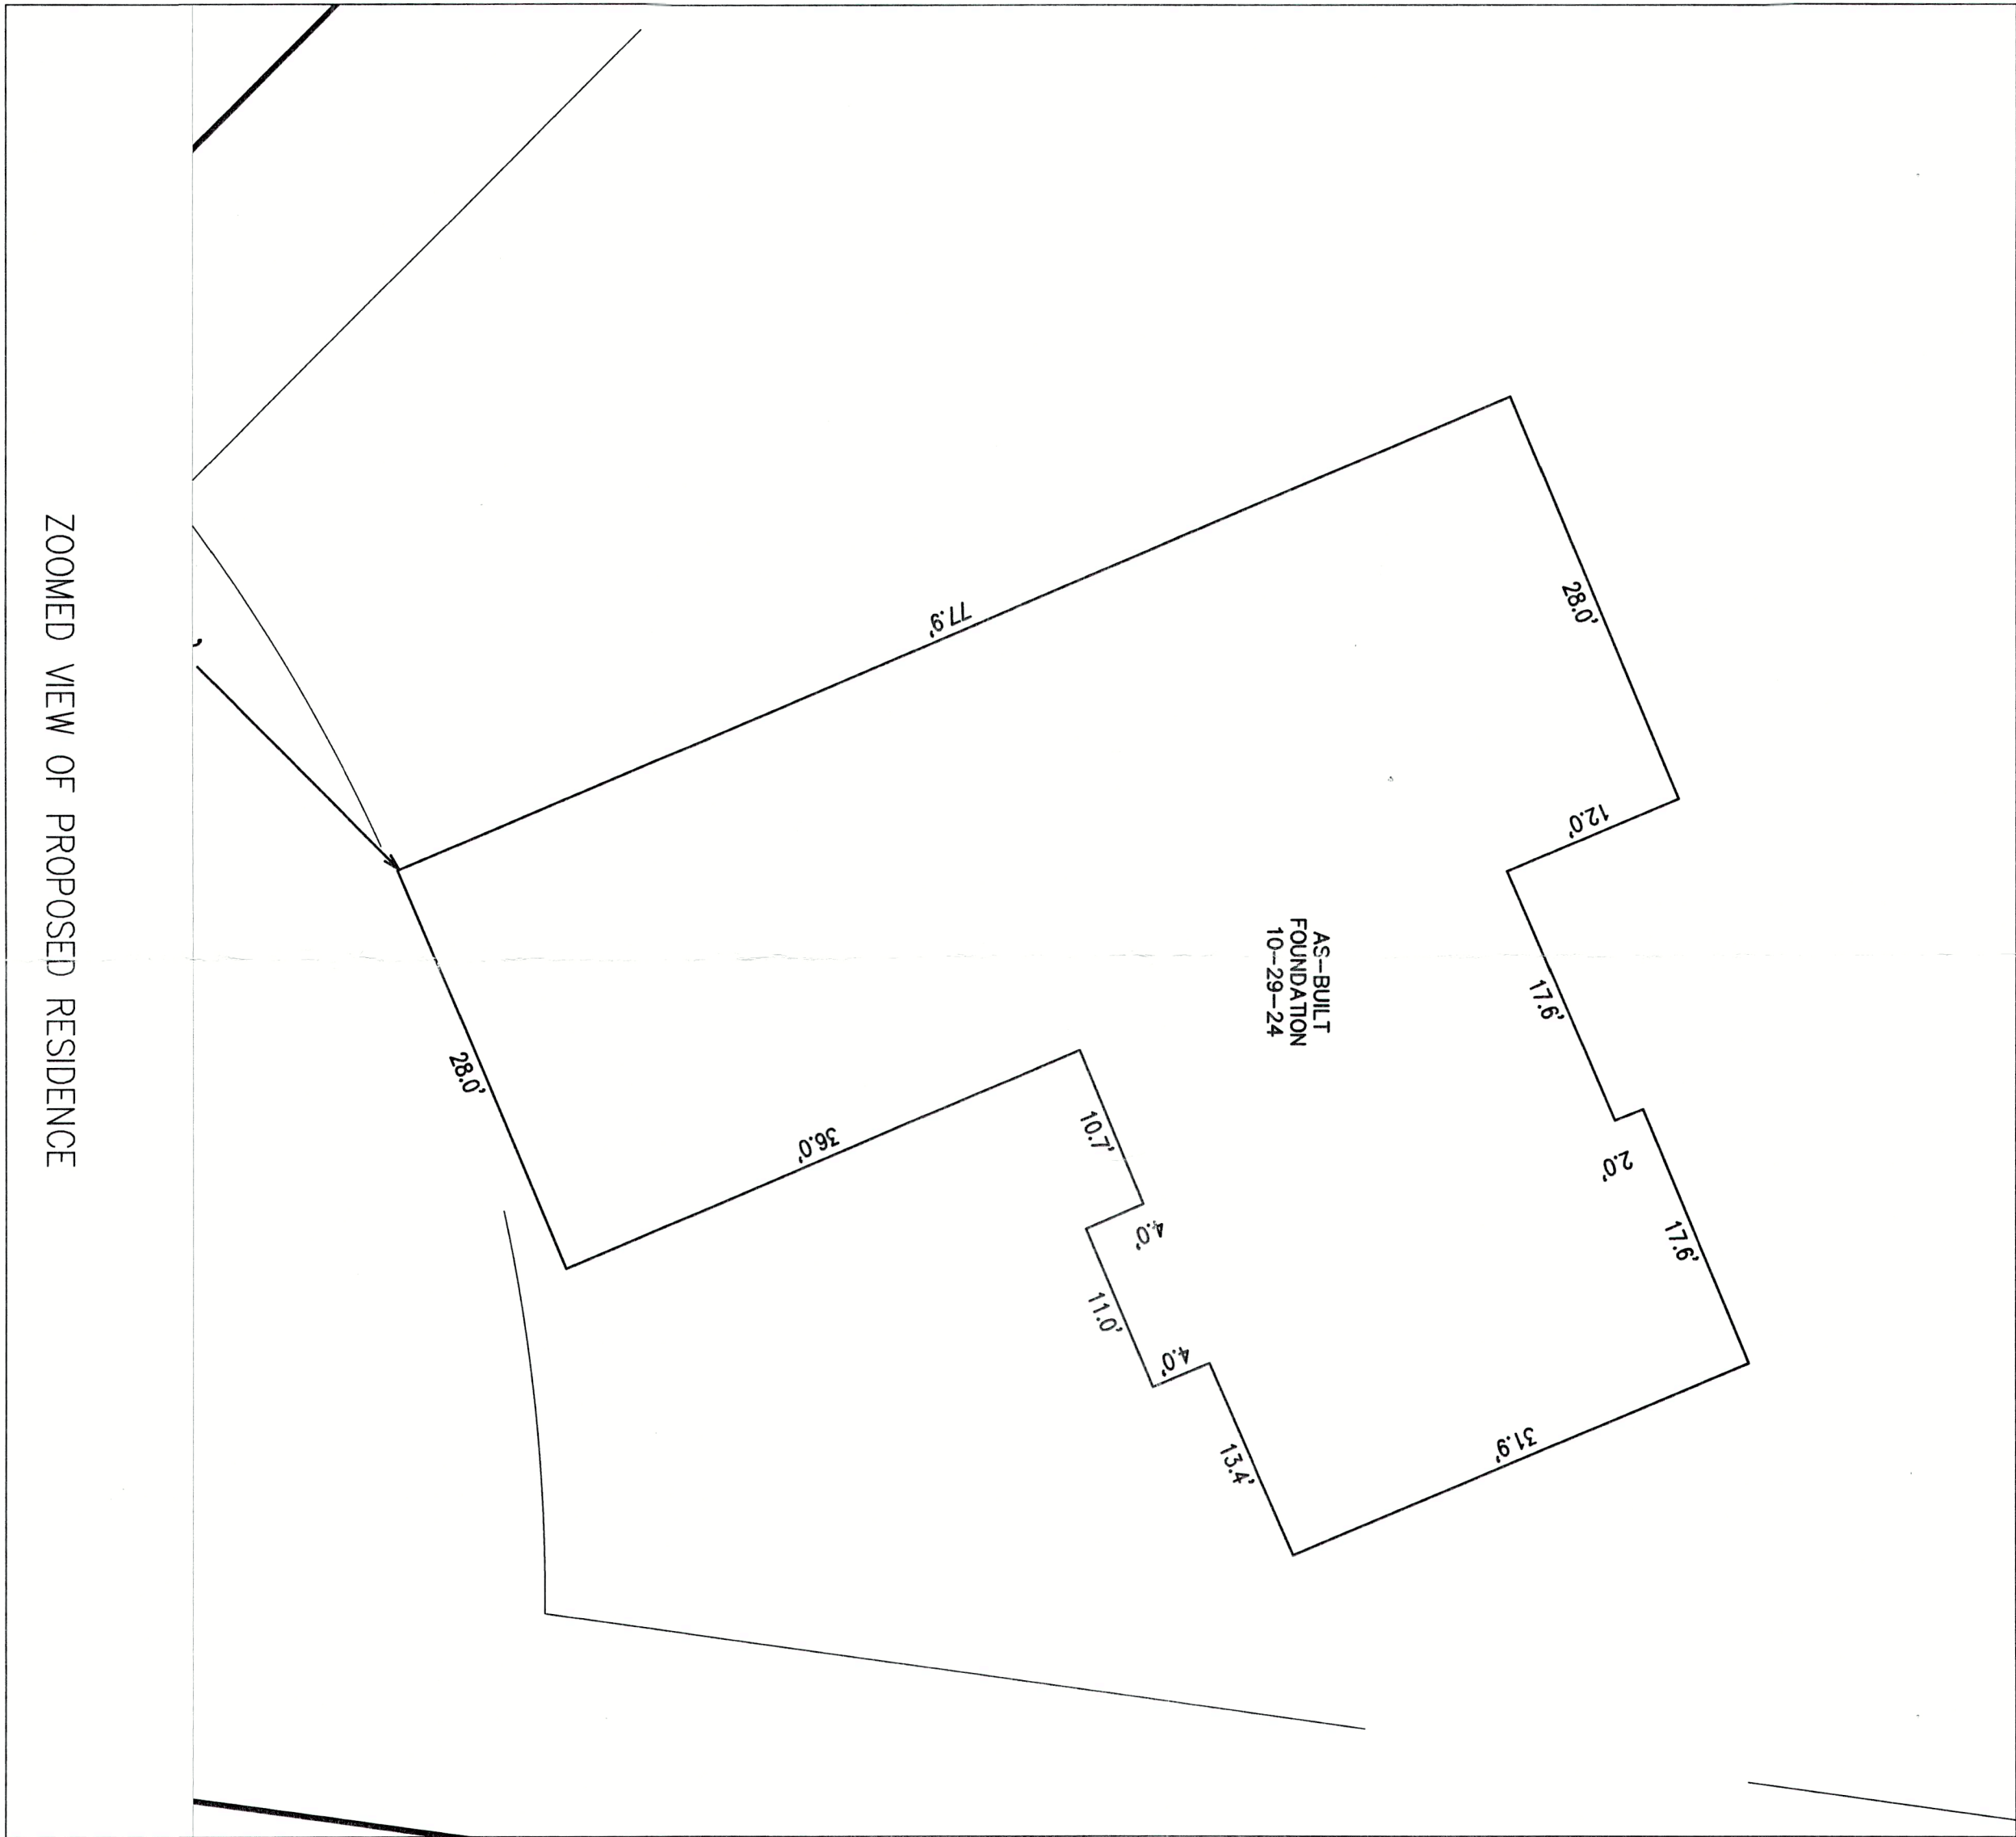


PLAT OF SURVEY – AS-BUILT
LOT 9 OF THE PRESERVE AT LAKEVIEW GLE, A SUBDIVISION
LOCATED IN PART OF THE SE 1/4 OF THE SW 1/4 OF SECTION 32, TOWN 2 NORTH, RANGE 17 EAST
TOWN OF GENEVA, WALWORTH COUNTY, WISCONSIN

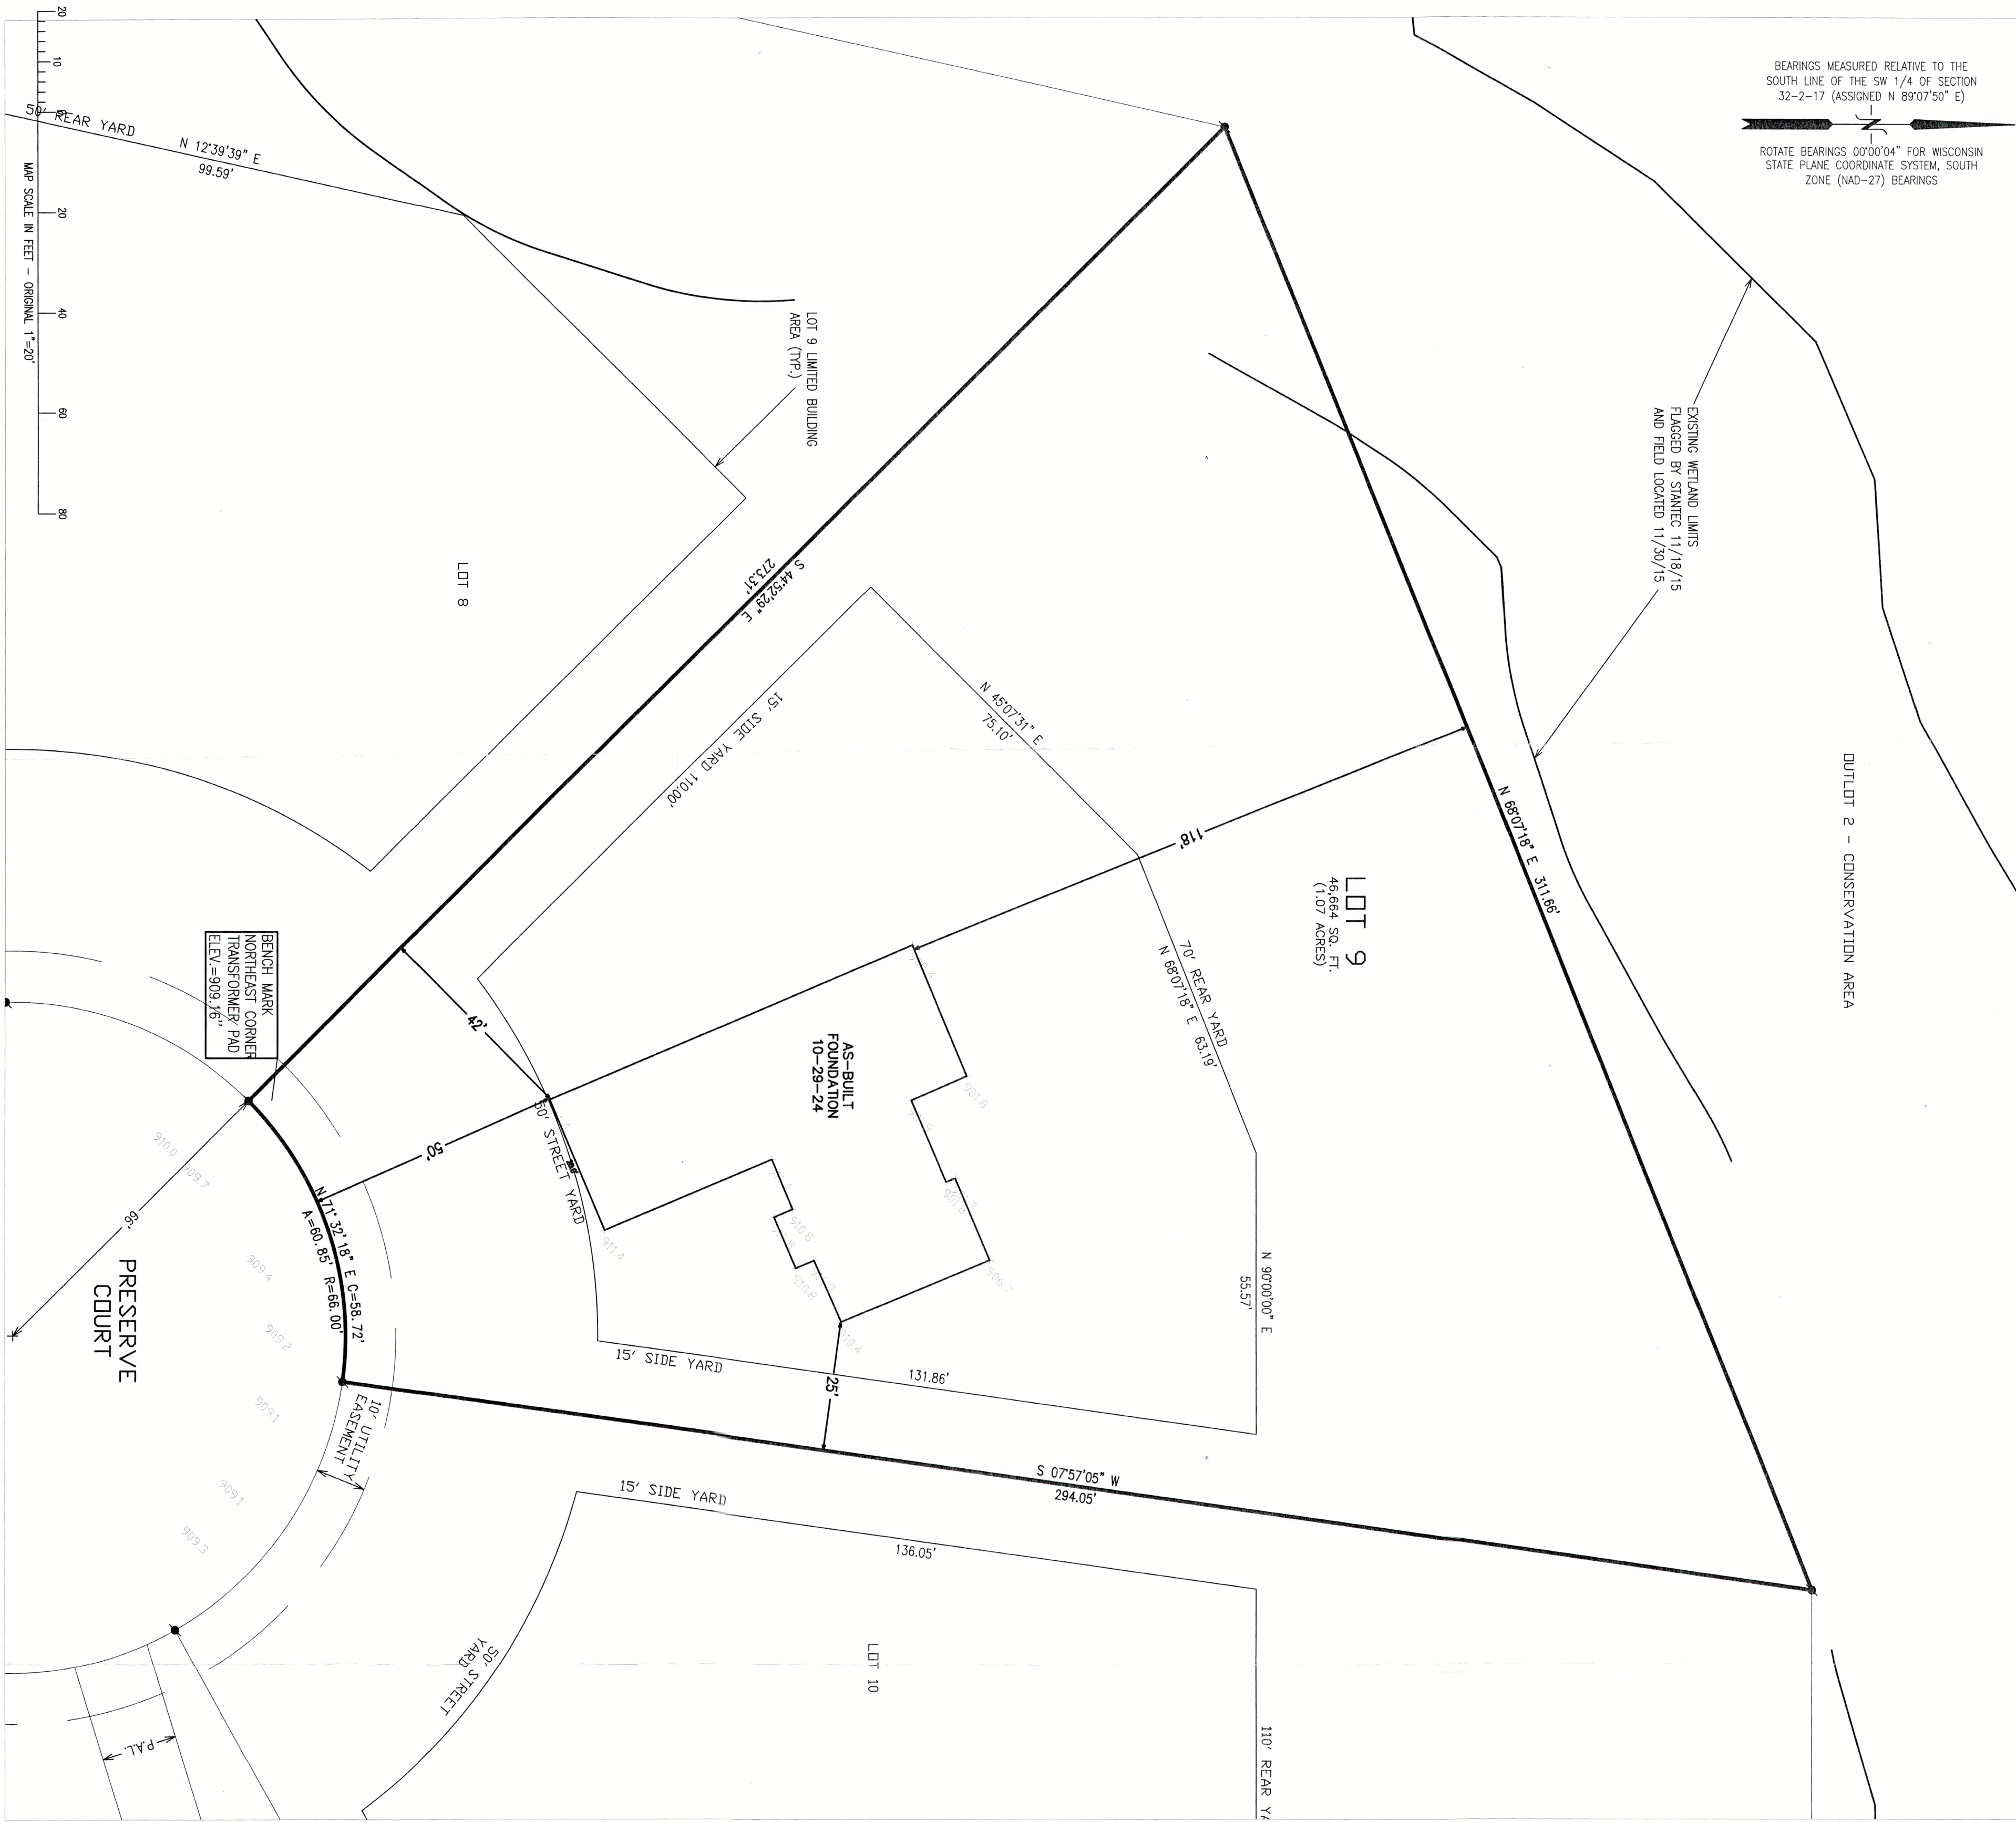

LEGEND

- = IRON REBAR FOUND 3/4" O.D.
- = IRON REBAR SET
- 3/4" x 18" x 1.13 lbs/ft
- = ELECTRICAL TRANSFORMER
- = CABLE BOX
- XXXX = PROPOSED FINISHED GRADE
- T/F = TOP OF FOUNDATION ELEVATION
- F/F = FIRST FLOOR ELEVATION
- G/E = GARAGE ELEVATION
- W/O = LOWER LEVEL WALKOUT

NOTE: COPIES OF THIS MAP TO WHICH THE FOLLOWING CERTIFICATE WILL APPLY SHOW THE SURVEYOR'S ORIGINAL SEAL AND SIGNATURE IN RED INK. COPIES BY ANY OTHER MEANS MAY HAVE ALTERATIONS WHICH DO NOT REPRESENT THE SURVEYOR'S WORK PRODUCT.

I HEREBY CERTIFY THAT THE ABOVE DESCRIBED PROPERTY HAS BEEN SURVEYED UNDER MY DIRECTION AND THAT THE ABOVE MAP IS A TRUE REPRESENTATION THEREOF AND SHOWS THE SIZE AND LOCATION OF THE PROPERTY AND ITS EXTERIOR BOUNDARIES. THIS SURVEY IS MADE FOR THE USE OF THE PRESENT OWNERS OF THE PROPERTY, AND ALSO THOSE WHO PURCHASE, MORTGAGE, OR GUARANTEE THE TITLE THEREIN WITHIN ONE YEAR FROM THE DATE HEREOF.


DATED JUNE 14, 2024

CHRISTOPHER A. HODGES P.L.S. 2760

FARRIS, HANSEN & ASSOCIATES, INC.
ENGINEERING – ARCHITECTURE – SURVEYING
7 RIDGEWAY COURT P.O. BOX 437
ELKHORN, WISCONSIN 53121
PHONE: (262) 723-2098 e-mail: office@farrishansen.com

– WORK ORDERED BY –
EVERGREEN DESIGNS, INC
4113 N COUNTY F
JANESVILLE WI 53545

CONROY RESIDENCE
RESIDENTIAL PERMIT PLAT
LOT 9 ON SANCTUARY GLEN DRIVE
TOWN OF GENEVA, WISCONSIN

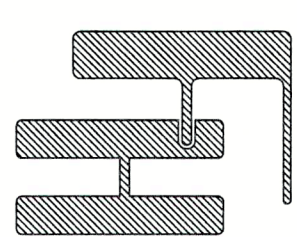

REVISIONS
7-23-24
Respond to Town Review
10-30-24
As-Built Foundation

PROJECT NO.
9297.09
DATE
6/14/2024
SHEET NO.
1 OF 1