


—OF—

OF
THE
COUNTY

LEGEND

- FOUND 1-5/16" O.D. IRON PIPE
- ◎ FOUND 2" O.D. IRON PIPE
- ♂ FOUND 1" O.D. IRON PIPE
- ♂ FOUND 5/8" DIA. IRON ROD
- SET 1-5/16" O.D. IRON PIPE
- () RECORDED AS
- ☞ UTILITY POLE

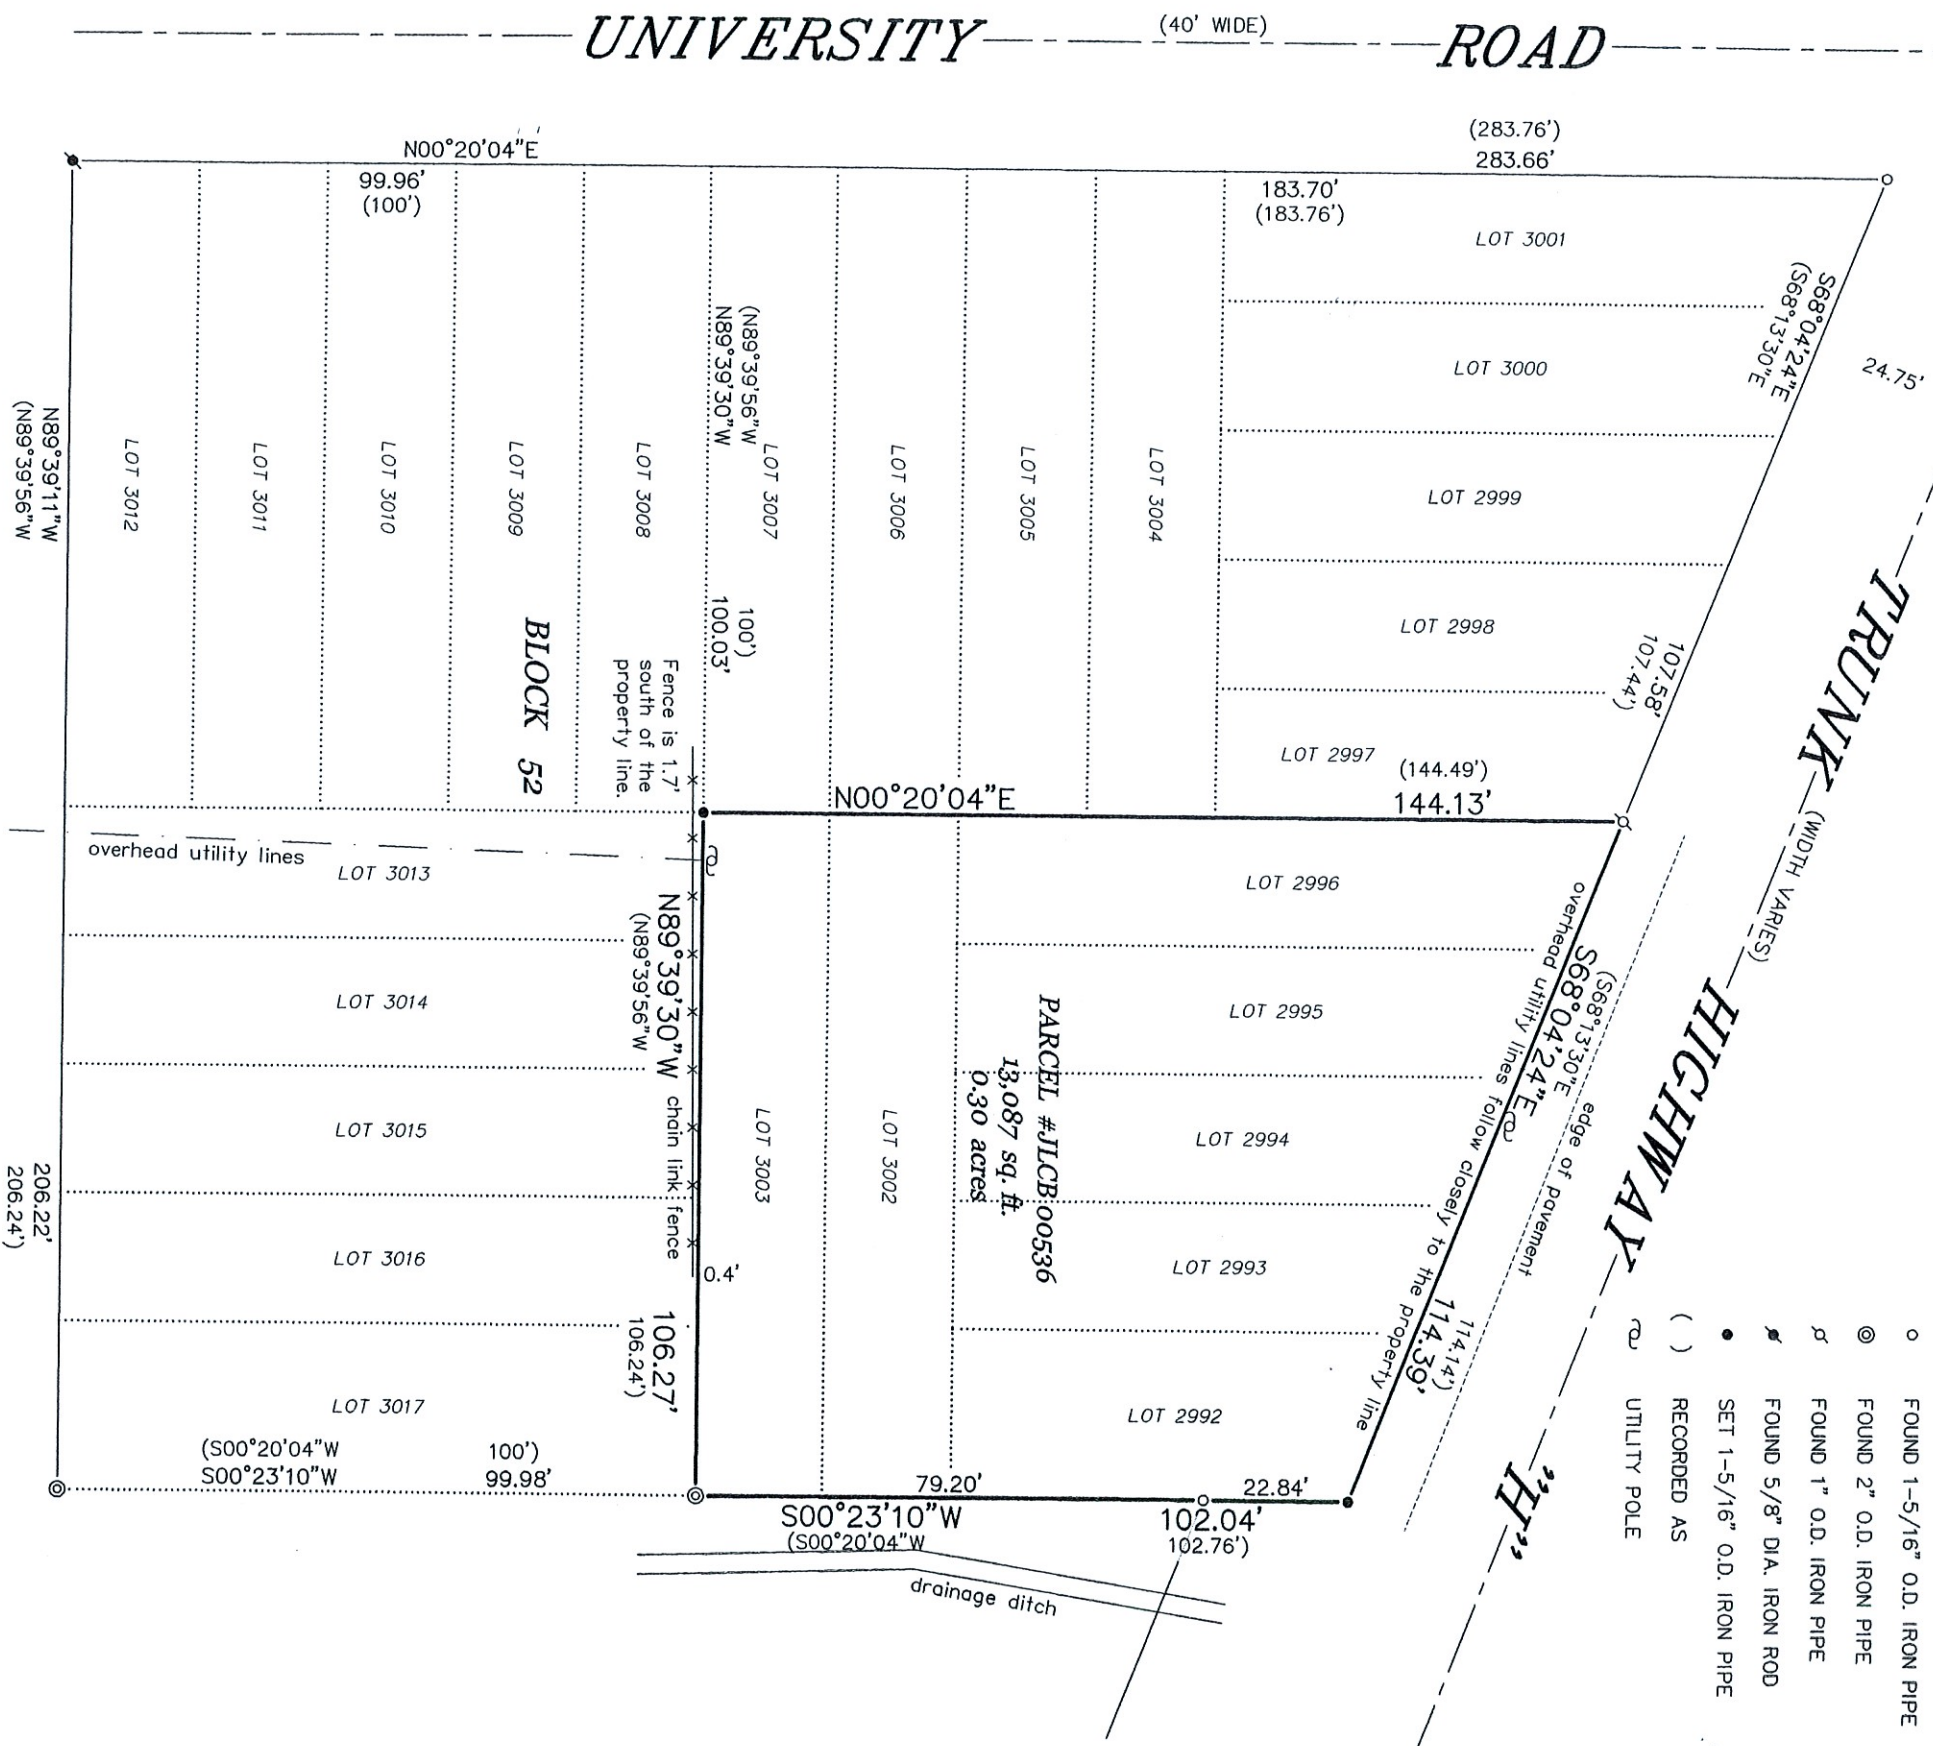

BEARINGS HEREON RELATE TO THE WEST LINE OF BLOCK 52 OF THE SECOND MAP OF LAKE COMO BEACH SUBDIVISION. ASSUMED BEARING OF NORTH 00°20'04" EAST AS PLATTED.

THIS IS NOT AN ORIGINAL PRINT
UNLESS THIS SEAL IS RED.

UNLESS THIS SEAL IS RED.

THOMAS L. SATTER

ER S-2850

MAY 24, 2024	042405
DATE	JOB NUMBER

JOB NUMBER