


Date February 12, 1977

PLAT OF SURVEY


Job No. Z-18518

Lots 5323 to 5332 inclusive as designated and delineated on the Map entitled "Map of Lake Como Beach, Walworth County, Wisconsin" Situated in the Northeast 1/4 of Section 28, Town 2 North, Range 17 East, in the Town of Geneva, Walworth County, Wisconsin.

Located on Evergreen Road

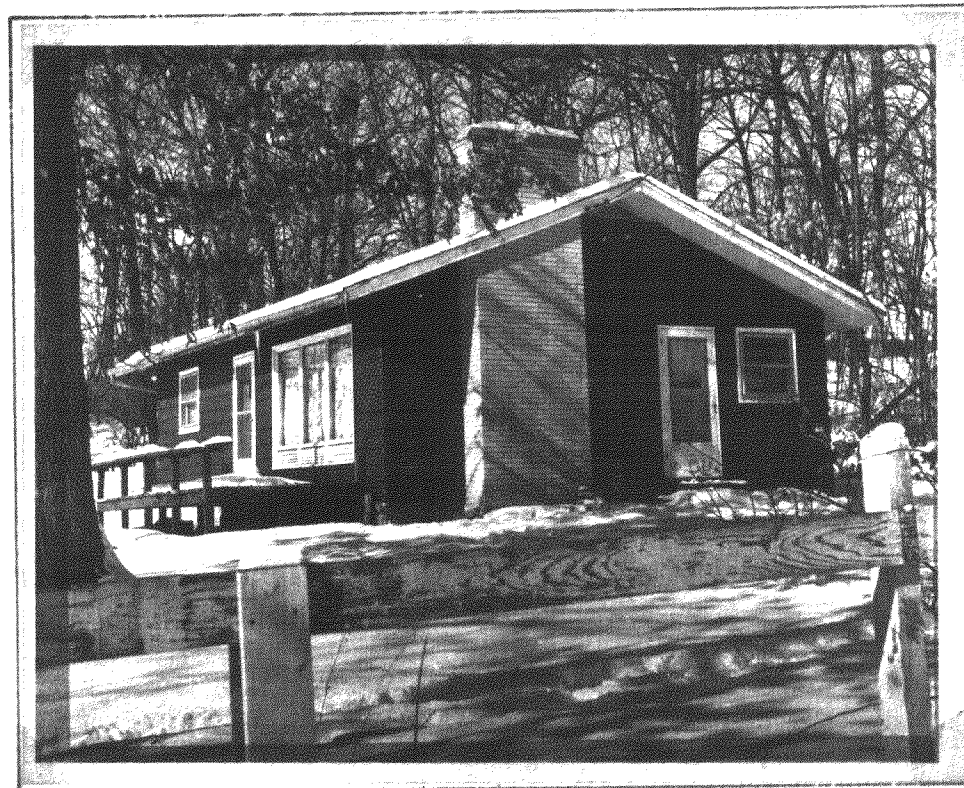

EVERGREEN ROAD (40)
15 GRAVEL ROADWAY

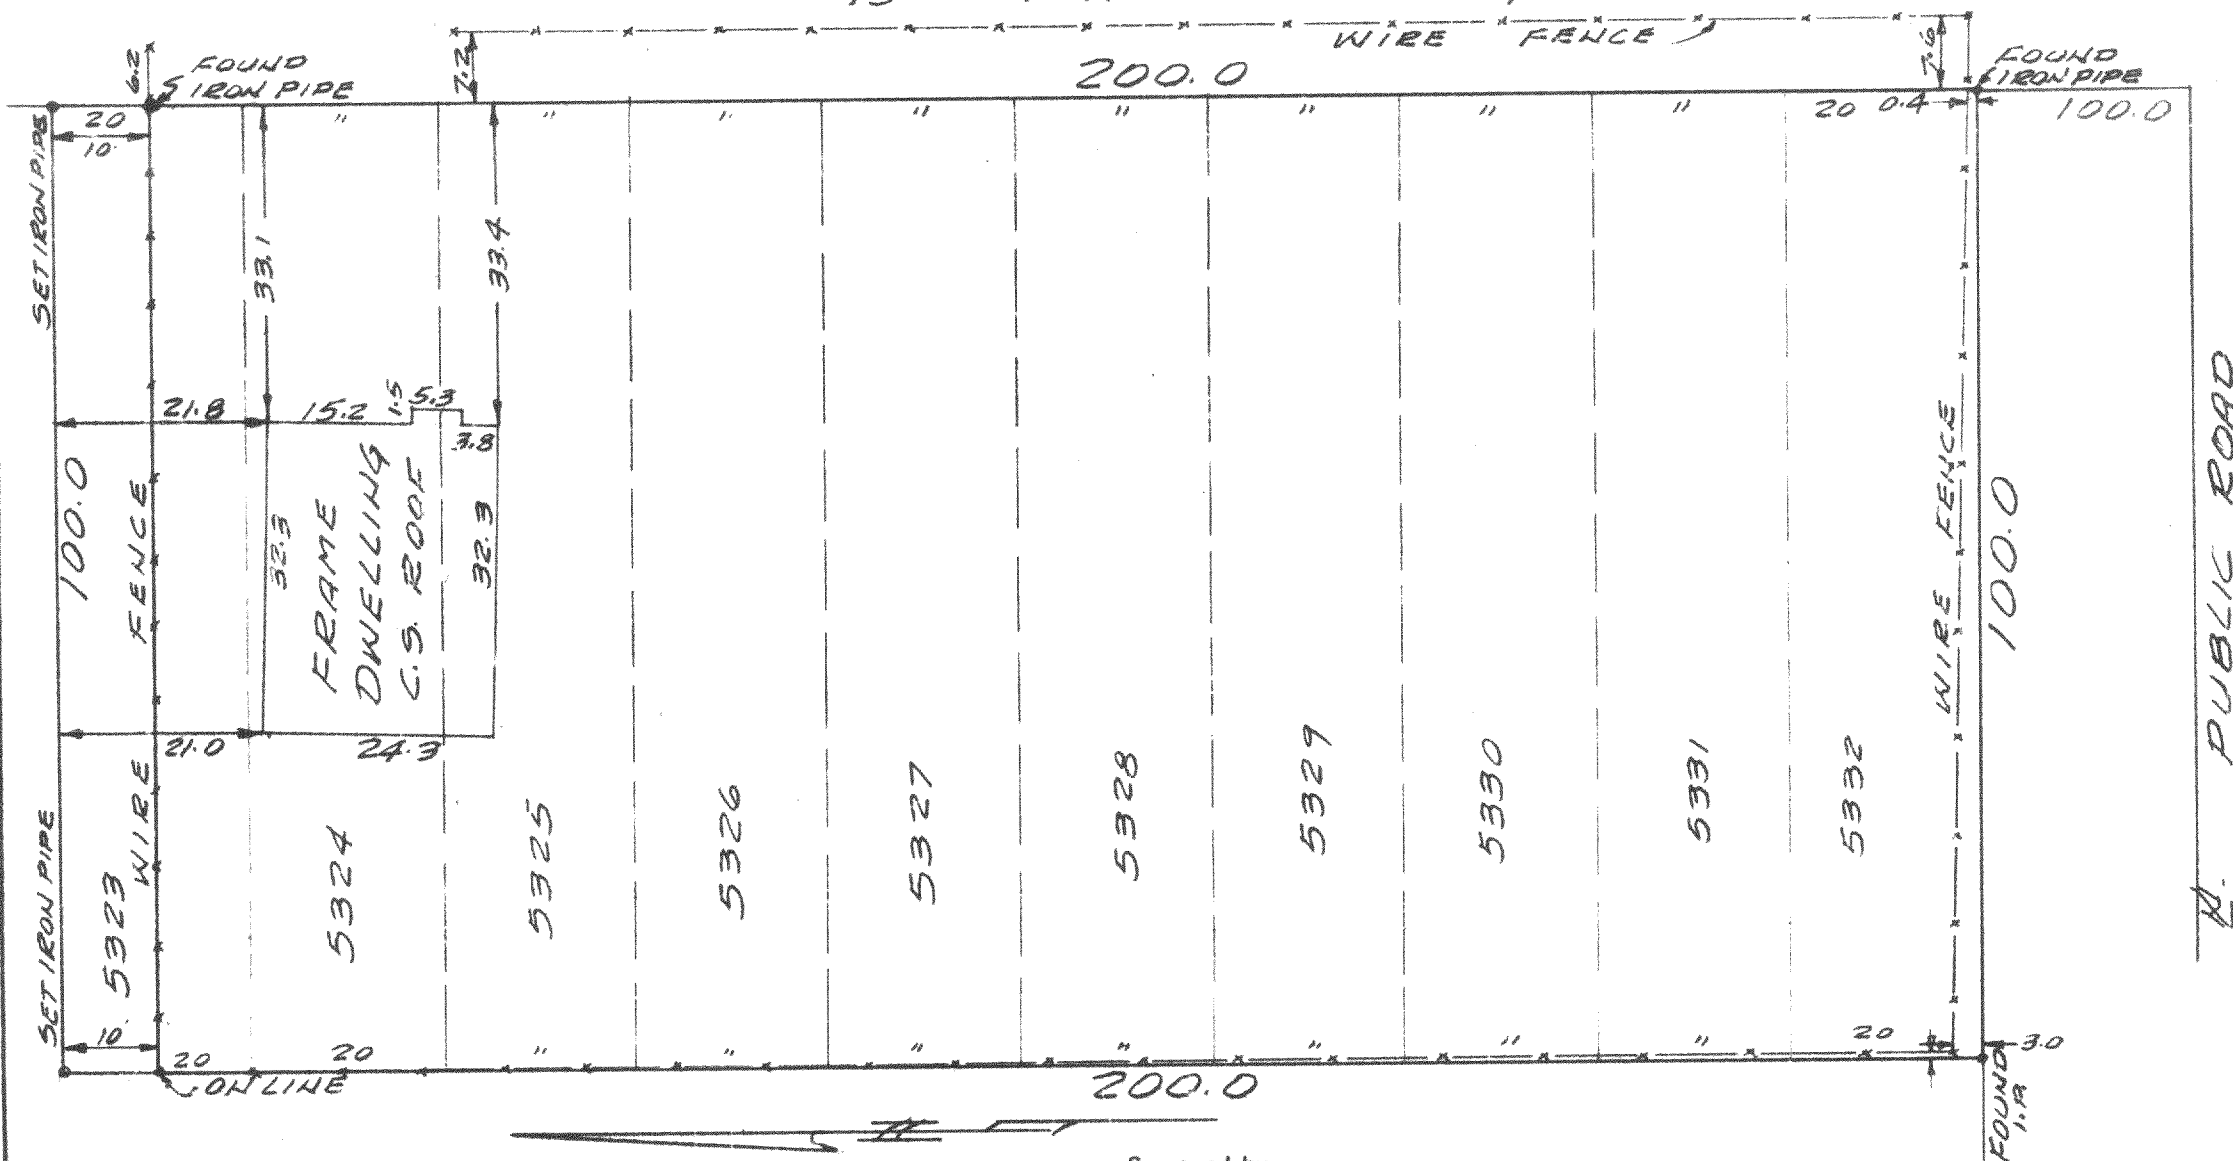

Esda Bldg.
5626 N. 91st. St.
Milwaukee, Wisconsin 53225

SURVEYED FOR

Waukesha Savings & Loan Assn.
704 North Grand Avenue
Waukesha, Wisconsin 53186

Surveyed by
RICHARD J. LAMMI


Owner: Walter Asmus

PHONE
461-3730

I have surveyed the above described property, and the above map is a true representation thereof and shows the size and location of the property, its exterior boundaries, the location and dimensions of all visible structures thereon, fences, apparent easements, roadways and visible encroachments.

This survey is made for the exclusive use of the present owners of the property; also those who purchase, mortgage or guarantee the title thereto, within one year from date hereof.

Richard J. Lammi
REGISTERED LAND SURVEYOR NO. 5-777 - STATE OF WISCONSIN

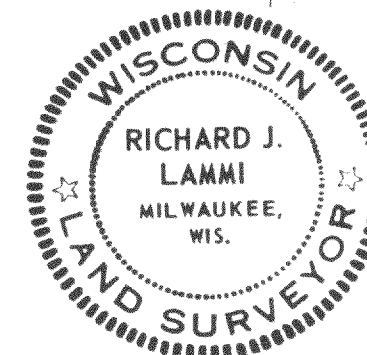

JLCB-1072

217-522