


AS-BUILT
BUILDING 8 OF GENEVA NATIONAL CONDOMINIUM NO. 57

LOCATED IN PART OF THE SW 1/4 OF THE SE 1/4 OF SECTION 20, TOWN 2 NORTH, RANGE 17 EAST
 TOWN OF GENEVA, WALWORTH COUNTY, WISCONSIN

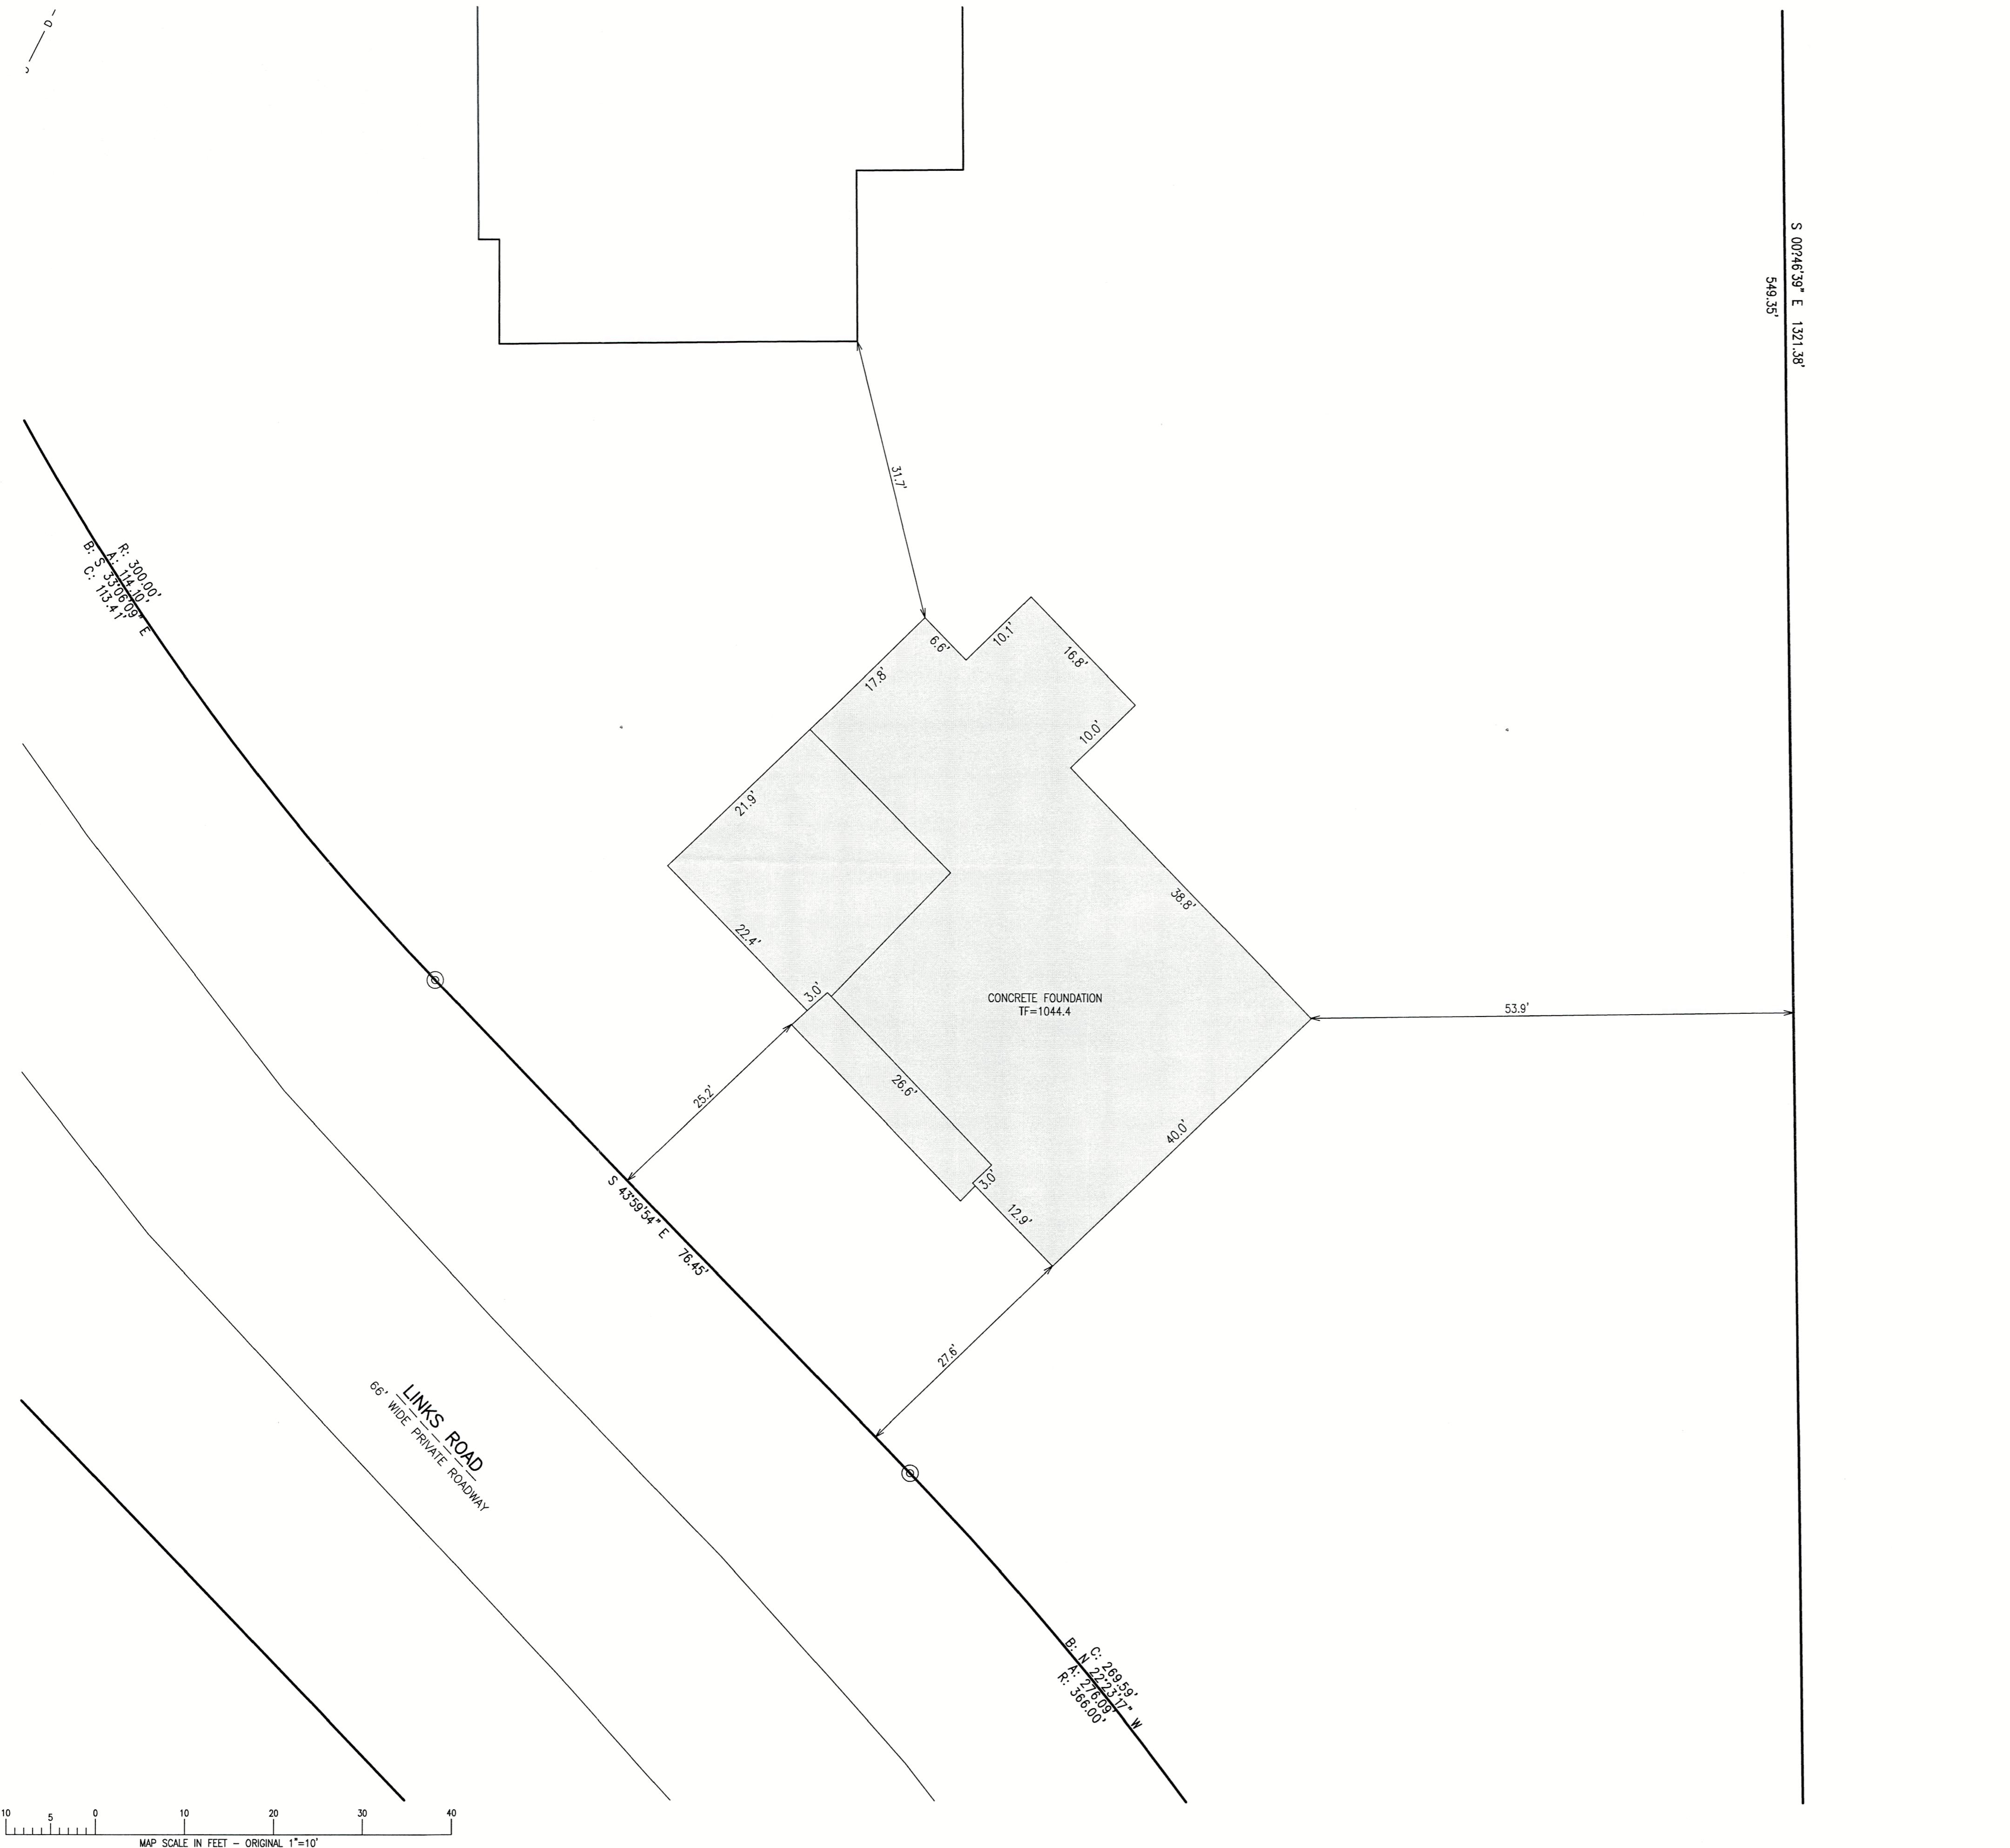

CONSTRUCTION SEQUENCE

- 1) SILT FENCING INSTALLED
- 2) INSTALL ANTI-TRACKING MAT
- 3) VEGETATION TO BE CLEARED
- 4) TOPSOIL STRIPPED
- 5) FOUNDATIONS DUG & Poured
- 6) WALLS BACKFILLED
- 7) FRAMING AND HOME CONSTRUCTION COMPLETED
- 8) DRIVE & LANDSCAPING COMPLETED

AREA WITHIN SILT FENCING TO BE CLEARED OF UNDERBRUSH WITH ONLY NECESSARY LARGE TREES REMOVED (MARKED WITH "X").

ALL SILT FENCING SHALL BE MAINTAINED IN A STABLE CONDITION FULLY BRACED AND STAKED TO PREVENT MOVEMENT BY RUNOFF UNTIL A DENSE TURF IS ESTABLISHED OVER ALL DISTURBED GROUND SURFACES. DURING OR AFTER EVERY STORM THEY SHALL BE CHECKED. ACCUMULATIONS OF SILT TOPSOIL ANY ANY OTHER CONSTRUCTION DEBRIS SHALL BE ROUTINELY REMOVED.

ALL SURPLUS EXCAVATED MATERIALS TO BE LOADED AND HAULED OFF SITE AT TIME OF EXCAVATION.

AREA TO BE RESTORED WITH TOP SOIL WITH SURFACE SUPPLEMENTED WITH IMPORTED SCREENED AND SHREDDED TOPSOIL (MINIMUM 6" DEPTH) AFTER FOUNDATION AND FRAMING AS SOON AS POSSIBLE FOLLOWED WITH GRASS SEEDING AND MULCH.

TOTAL LAND DISTURBANCE AREA = 14,850 S.F.

FARRIS, HANSEN & ASSOCIATES, INC.
 ENGINEERING - ARCHITECTURE - SURVEYING
 7 RIDGWAY COURT P.O. BOX 437
 ELKHORN, WISCONSIN 53121
 OFFICE: (262) 723-2098 FAX: (262) 723-5886




REVISIONS
 6-20-24 Disturbance & Bldg Area
 Dim Bldg, Spot Grades
 9-30-24 Remove Deck
 2-24-25 RS
 As-Built

NOTE: COPIES OF THIS MAP TO WHICH THE FOLLOWING CERTIFICATE WILL APPLY SHOW THE SURVEYOR'S ORIGINAL SEAL AND SIGNATURE IN RED INK. COPIES BY ANY OTHER MEANS MAY HAVE ALTERATIONS WHICH DO NOT REPRESENT THE SURVEYOR'S WORK PRODUCT.

I HEREBY CERTIFY THAT THE ABOVE DESCRIBED PROPERTY HAS BEEN SURVEYED UNDER MY DIRECTION AND THAT THE ABOVE MAP IS A TRUE REPRESENTATION THEREOF AND SHOWS THE SIZE AND LOCATIONS THAT WERE AS-BUILT ON 01/17/2025.

DATED: FEBRUARY 24, 2025

CHRISTOPHER A. HODGES P.L.S. 2760

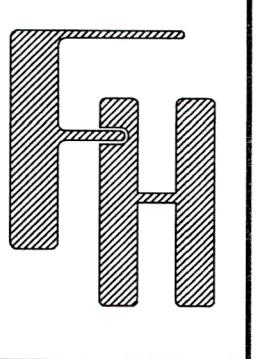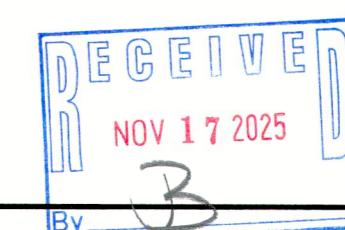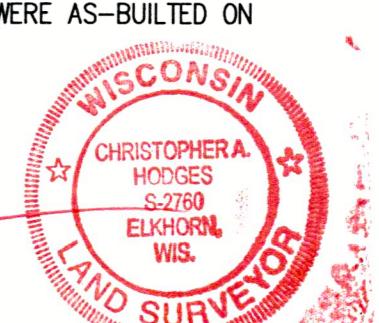

AS-BUILT

BEARING BASIS PER RECORD PLAT OF
 GENEVA NATIONAL CONDOMINIUM NO. 57

1703 LINKS ROAD
 LAKE GENEVA, WI 53147

WORK ORDERED BY -
 THE CHOICE GROUP, INC.
 PO BOX 1014
 LAKE GENEVA, WI 53147

PROJECT NO.
 3269-57-08
 DATE
 9/03/2024
 SHEET NO.
 1 OF 1