

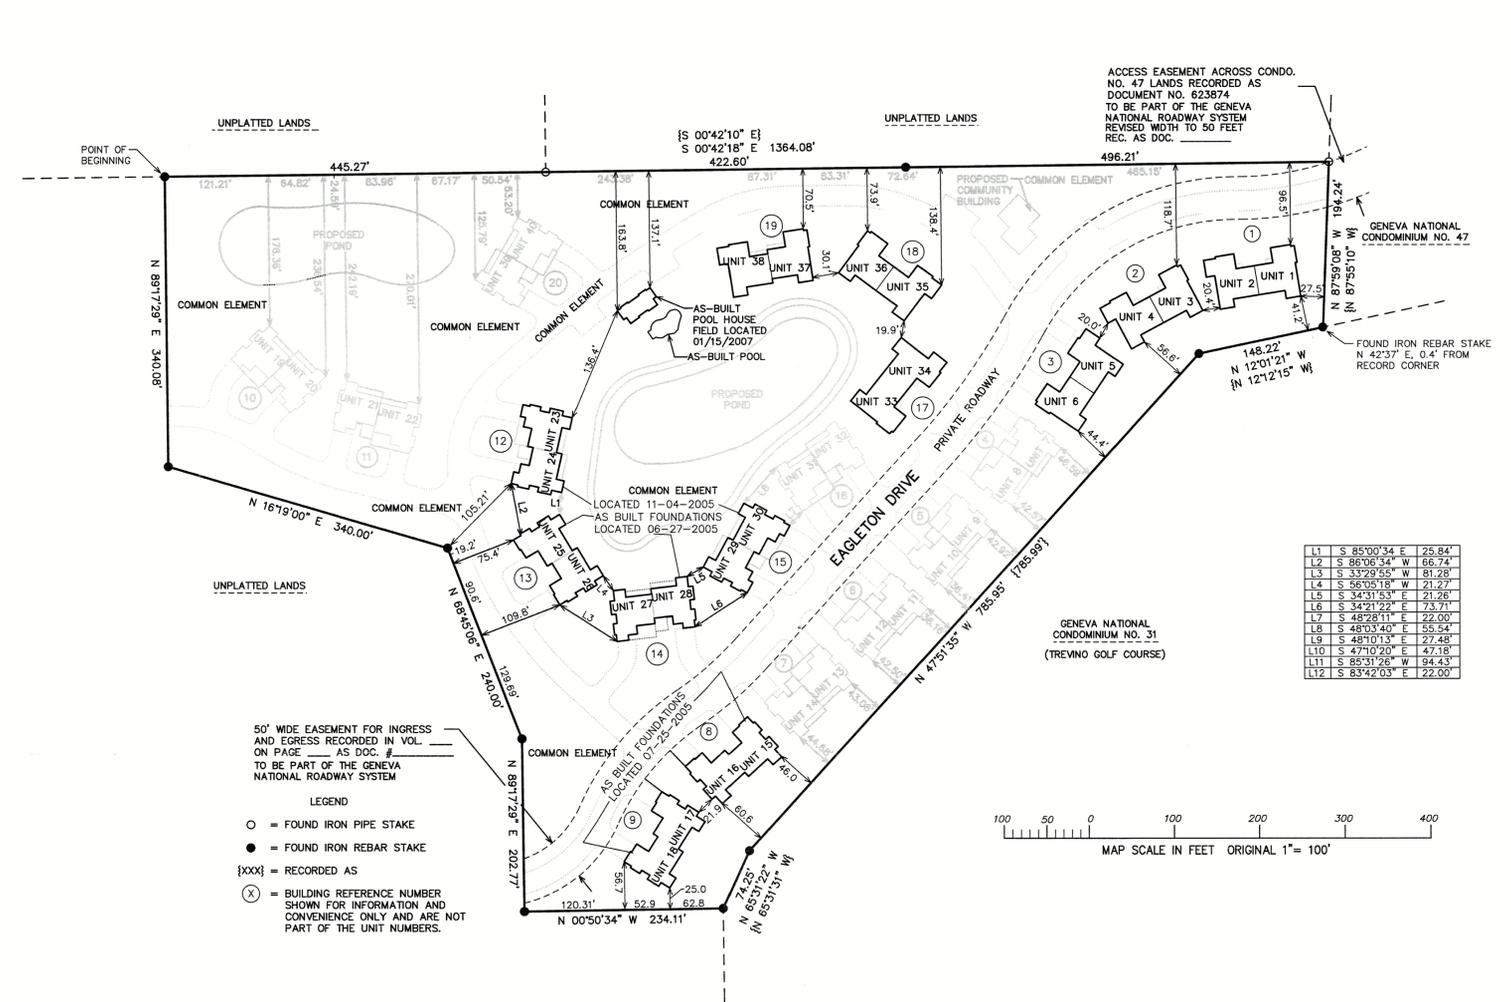
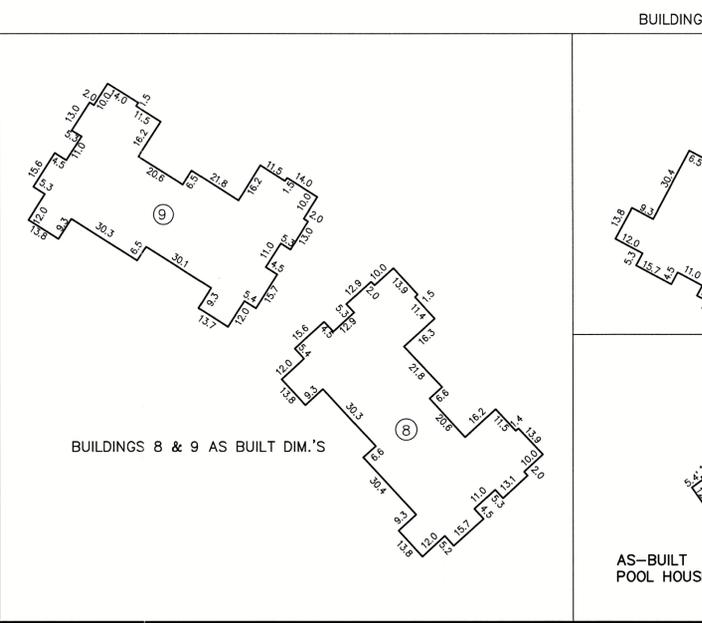


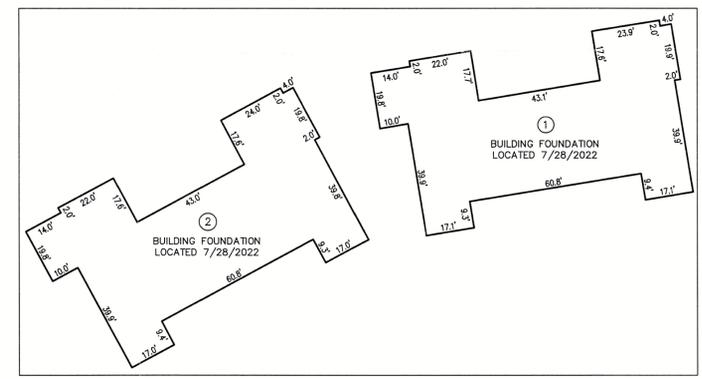

AS BUILT MAPPING
GENEVA NATIONAL CONDOMINIUM NO. 55
 LOCATED IN PART OF THE NE 1/4, NW 1/4, SW 1/4, AND SE 1/4 OF THE
 SE 1/4 OF SECTION 19, TOWN 2 NORTH, RANGE 17 EAST,
 WALWORTH COUNTY, WISCONSIN

ASSIGNED NORTH LINE OF THE SE 1/4
 SEC. 19-2-17
 S 88°50'55" W

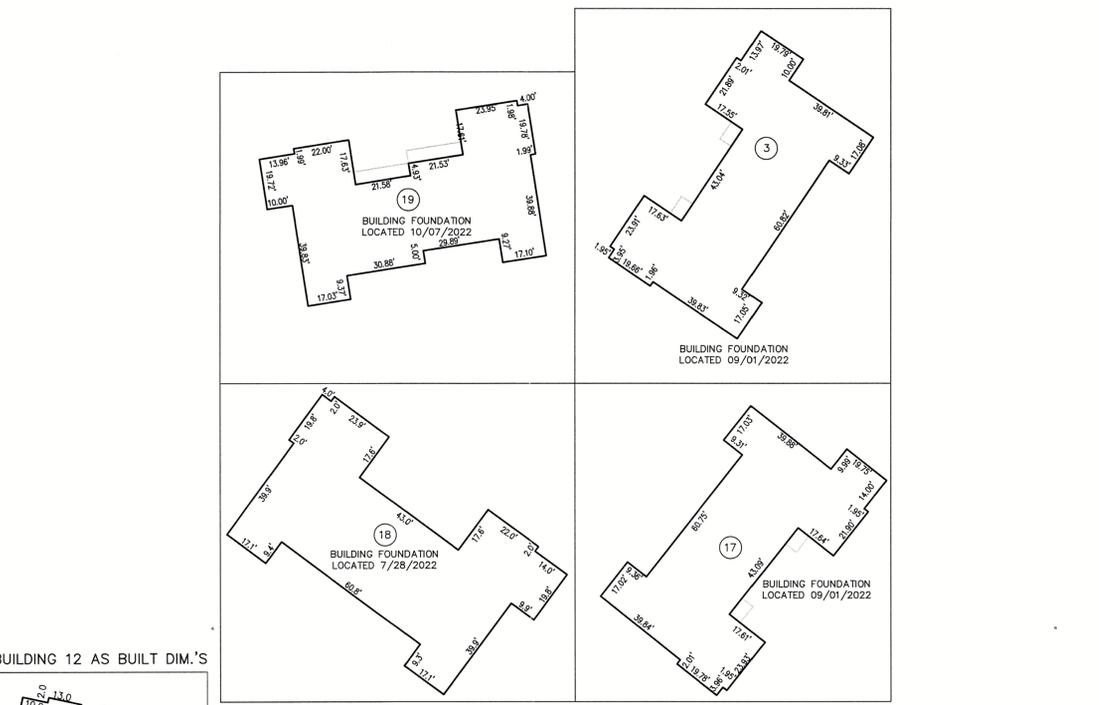

L1	S 85°00'34" E	25.84'
L2	S 86°06'34" W	66.74'
L3	S 33°29'55" W	81.28'
L4	S 56°05'18" W	21.27'
L5	S 34°31'53" E	21.96'
L6	S 34°21'22" E	73.71'
L7	S 48°28'11" E	22.00'
L8	S 48°03'40" E	55.54'
L9	S 48°10'13" E	27.48'
L10	S 47°10'20" E	47.18'
L11	S 85°31'28" W	94.43'
L12	S 83°42'03" E	22.00'

NOTE: COPIES OF THIS MAP TO WHICH THE FOLLOWING CERTIFICATE WILL APPLY SHOW SURVEYOR'S ORIGINAL SEAL AND SIGNATURE IN RED INK. COPIES BY ANY OTHER MEANS MAY HAVE ALTERATIONS WHICH DO NOT REPRESENT THE SURVEYOR'S WORK PRODUCT.

I HEREBY CERTIFY THAT THE ABOVE DESCRIBED PROPERTY HAS BEEN SURVEYED UNDER MY DIRECTION AND THAT THE ABOVE MAP IS A TRUE REPRESENTATION THEREOF AND SHOWS THE SIZE AND LOCATION OF THE PROPERTY AND ITS EXTERIOR BOUNDARIES. THIS SURVEY IS MADE FOR THE USE OF THE PRESENT OWNERS OF THE PROPERTY, AND ALSO THOSE WHO PURCHASE, MORTGAGE, OR GUARANTEE THE TITLE THERETO WITHIN ONE YEAR FROM THE DATE HEREOF.

DATED: 7/29/2022

Christopher A. Hodges

CHRISTOPHER A. HODGES P.L.S. 2760

WISCONSIN LAND SURVEYOR

REVISED 11-07-2005 TO SHOW SIZE & LOCATION OF BUILDINGS 12 & 15.

REVISED 01-16-2007 TO SHOW SIZE AND LOCATION OF AS-BUILT POOL HOUSE AND POOL.

REVISED 7/29/2022 TO UPDATE THIS MAP, SURVEYED AND LAST UPDATED BY PETER S. GORDON. ADDED BUILDINGS 1, 2, & 18.

REVISED 10/07/2022 TO UPDATE THIS MAP, SURVEYED AND LAST UPDATED BY PETER S. GORDON. ADDED BUILDINGS 3, 17, & 19.

I FURTHER CERTIFY THAT THE LANDS SURVEYED FALL IN FLOOD HAZARD AREA "C" (AREAS OF MINIMAL FLOODING), AS SHOWN ON FLOOD INSURANCE RATE MAP PANEL NO. 5504820090B, EFFECTIVE DATE OF AUGUST 15, 1983 AS PUBLISHED BY THE FEDERAL EMERGENCY MANAGEMENT AGENCY.

10/7/2022 A:\Projects\31989\CONDO_55\UPCAD\Drawings

FARRIS, HANSEN & ASSOCIATES, INC.
 ENGINEERING - ARCHITECTURE - SURVEYING
 7 RIDGWAY COURT P.O. BOX 437
 ELKHORN, WISCONSIN 53121
 OFFICE: (262) 723-2098 FAX: (262) 723-5886

REVISIONS
PROJECT NO. 3269.55
DATE 07-26-2005
SHEET NO. 1 OF 1

JGN 55-1 thru 55-6, 55-15 to 55-18, 55-23 to 55-30, 55-33 to 55-38 217-5287