




 SCALE 1"=20'

 1"=IRON PIPE

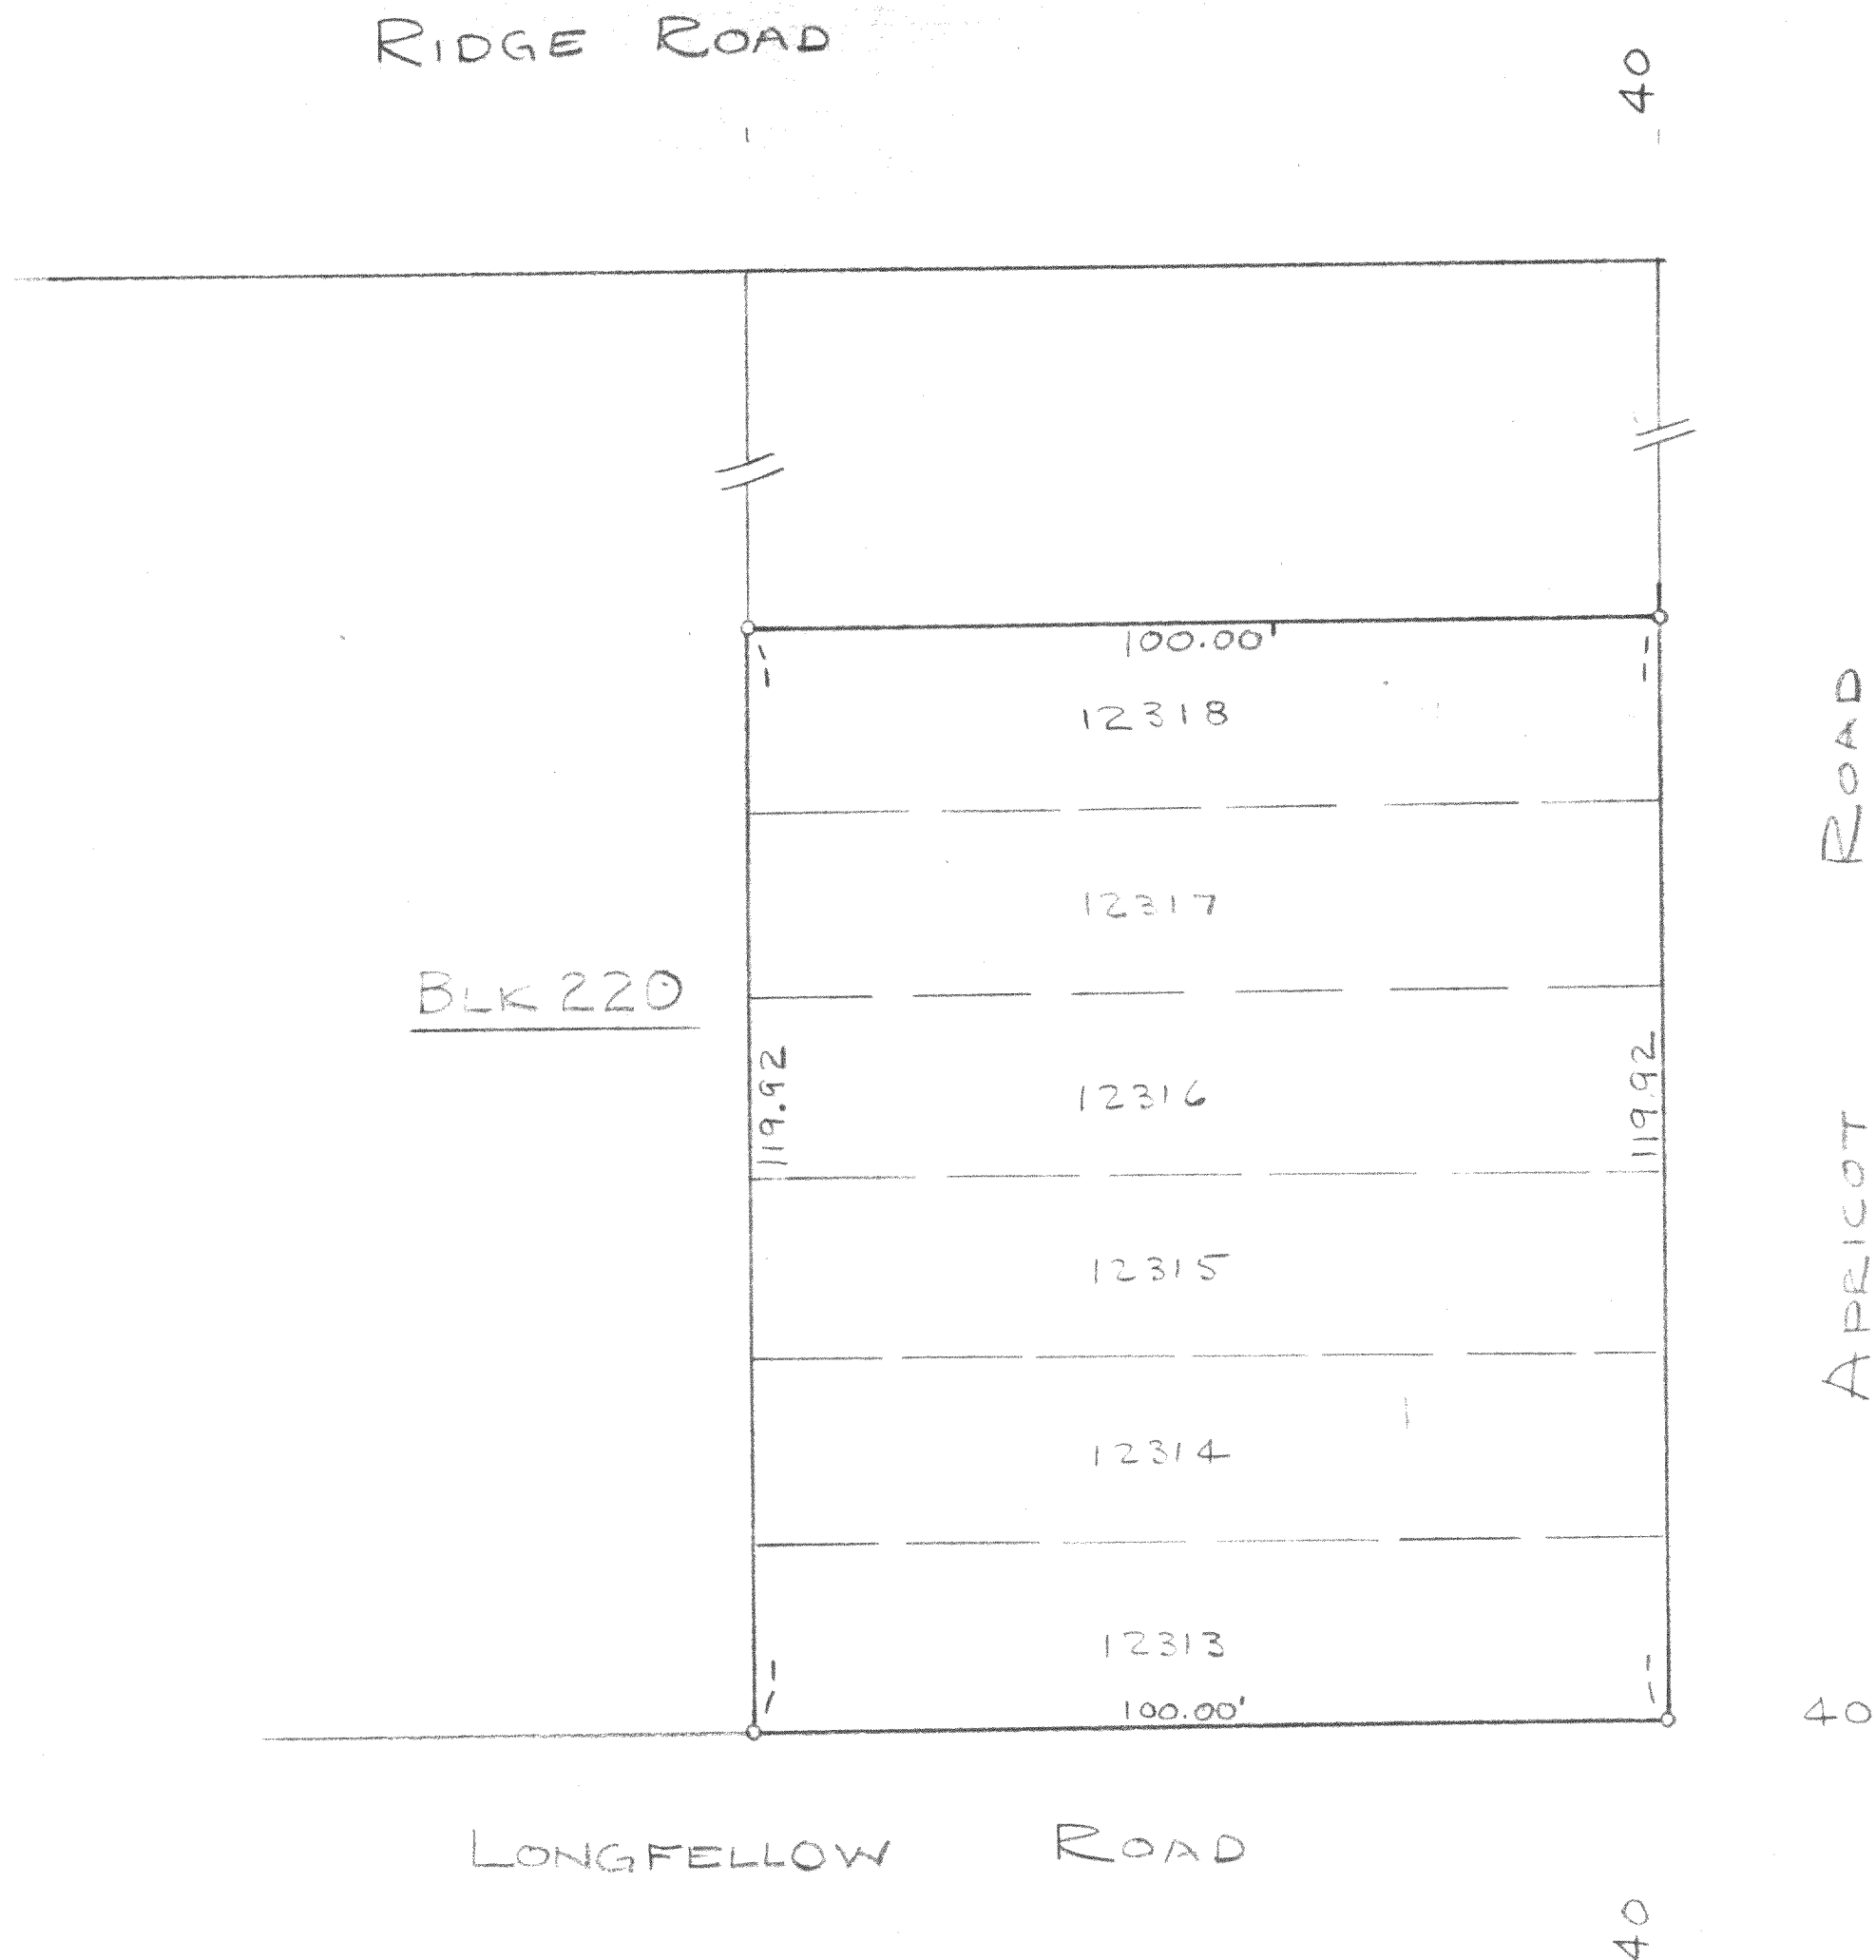


STATE OF WISCONSIN)^{SS}
 COUNTY OF WALWORTH)

I, LLOYD L. JENSEN, DO HEREBY CERTIFY THAT I
 HAVE SURVEYED THE FOLLOWING PARCEL OF LAND DESCRIBED
 ACCORDING TO THE OFFICIAL RECORDS AS FOLLOWS:

LOTS 12313 THRU 12318, INCLUSIVE, OF BLOCK
 220 OF THE FIFTH MAP OF LAKE COMO BEACH, A
 SUBDIVISION IN SECTION 29 OF T2N R17E OF WAL-
 WORTH COUNTY, WISCONSIN,

AND THAT THE PLAT ABOVE IS A CORRECT REPRESENT-
 ATION OF THE LOT LINES THEREOF.

ELKHORN, WISCONSIN
 APRIL 24, 1951

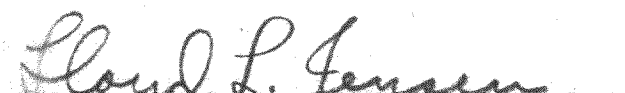
 COUNTY SURVEYOR

217-53.