


PLAT OF SURVEY WITH TOPOGRAPHIC MAPPING
OF LOT 1 OF CERTIFIED SURVEY MAP NO. 3915,
BEING PART OF THE NE 1/4 OF THE SW 1/4 OF SECTION 14, T. 2 N., R. 17 E., OF
THE 4TH P.M., TOWN OF GENEVA, WALWORTH COUNTY, WISCONSIN

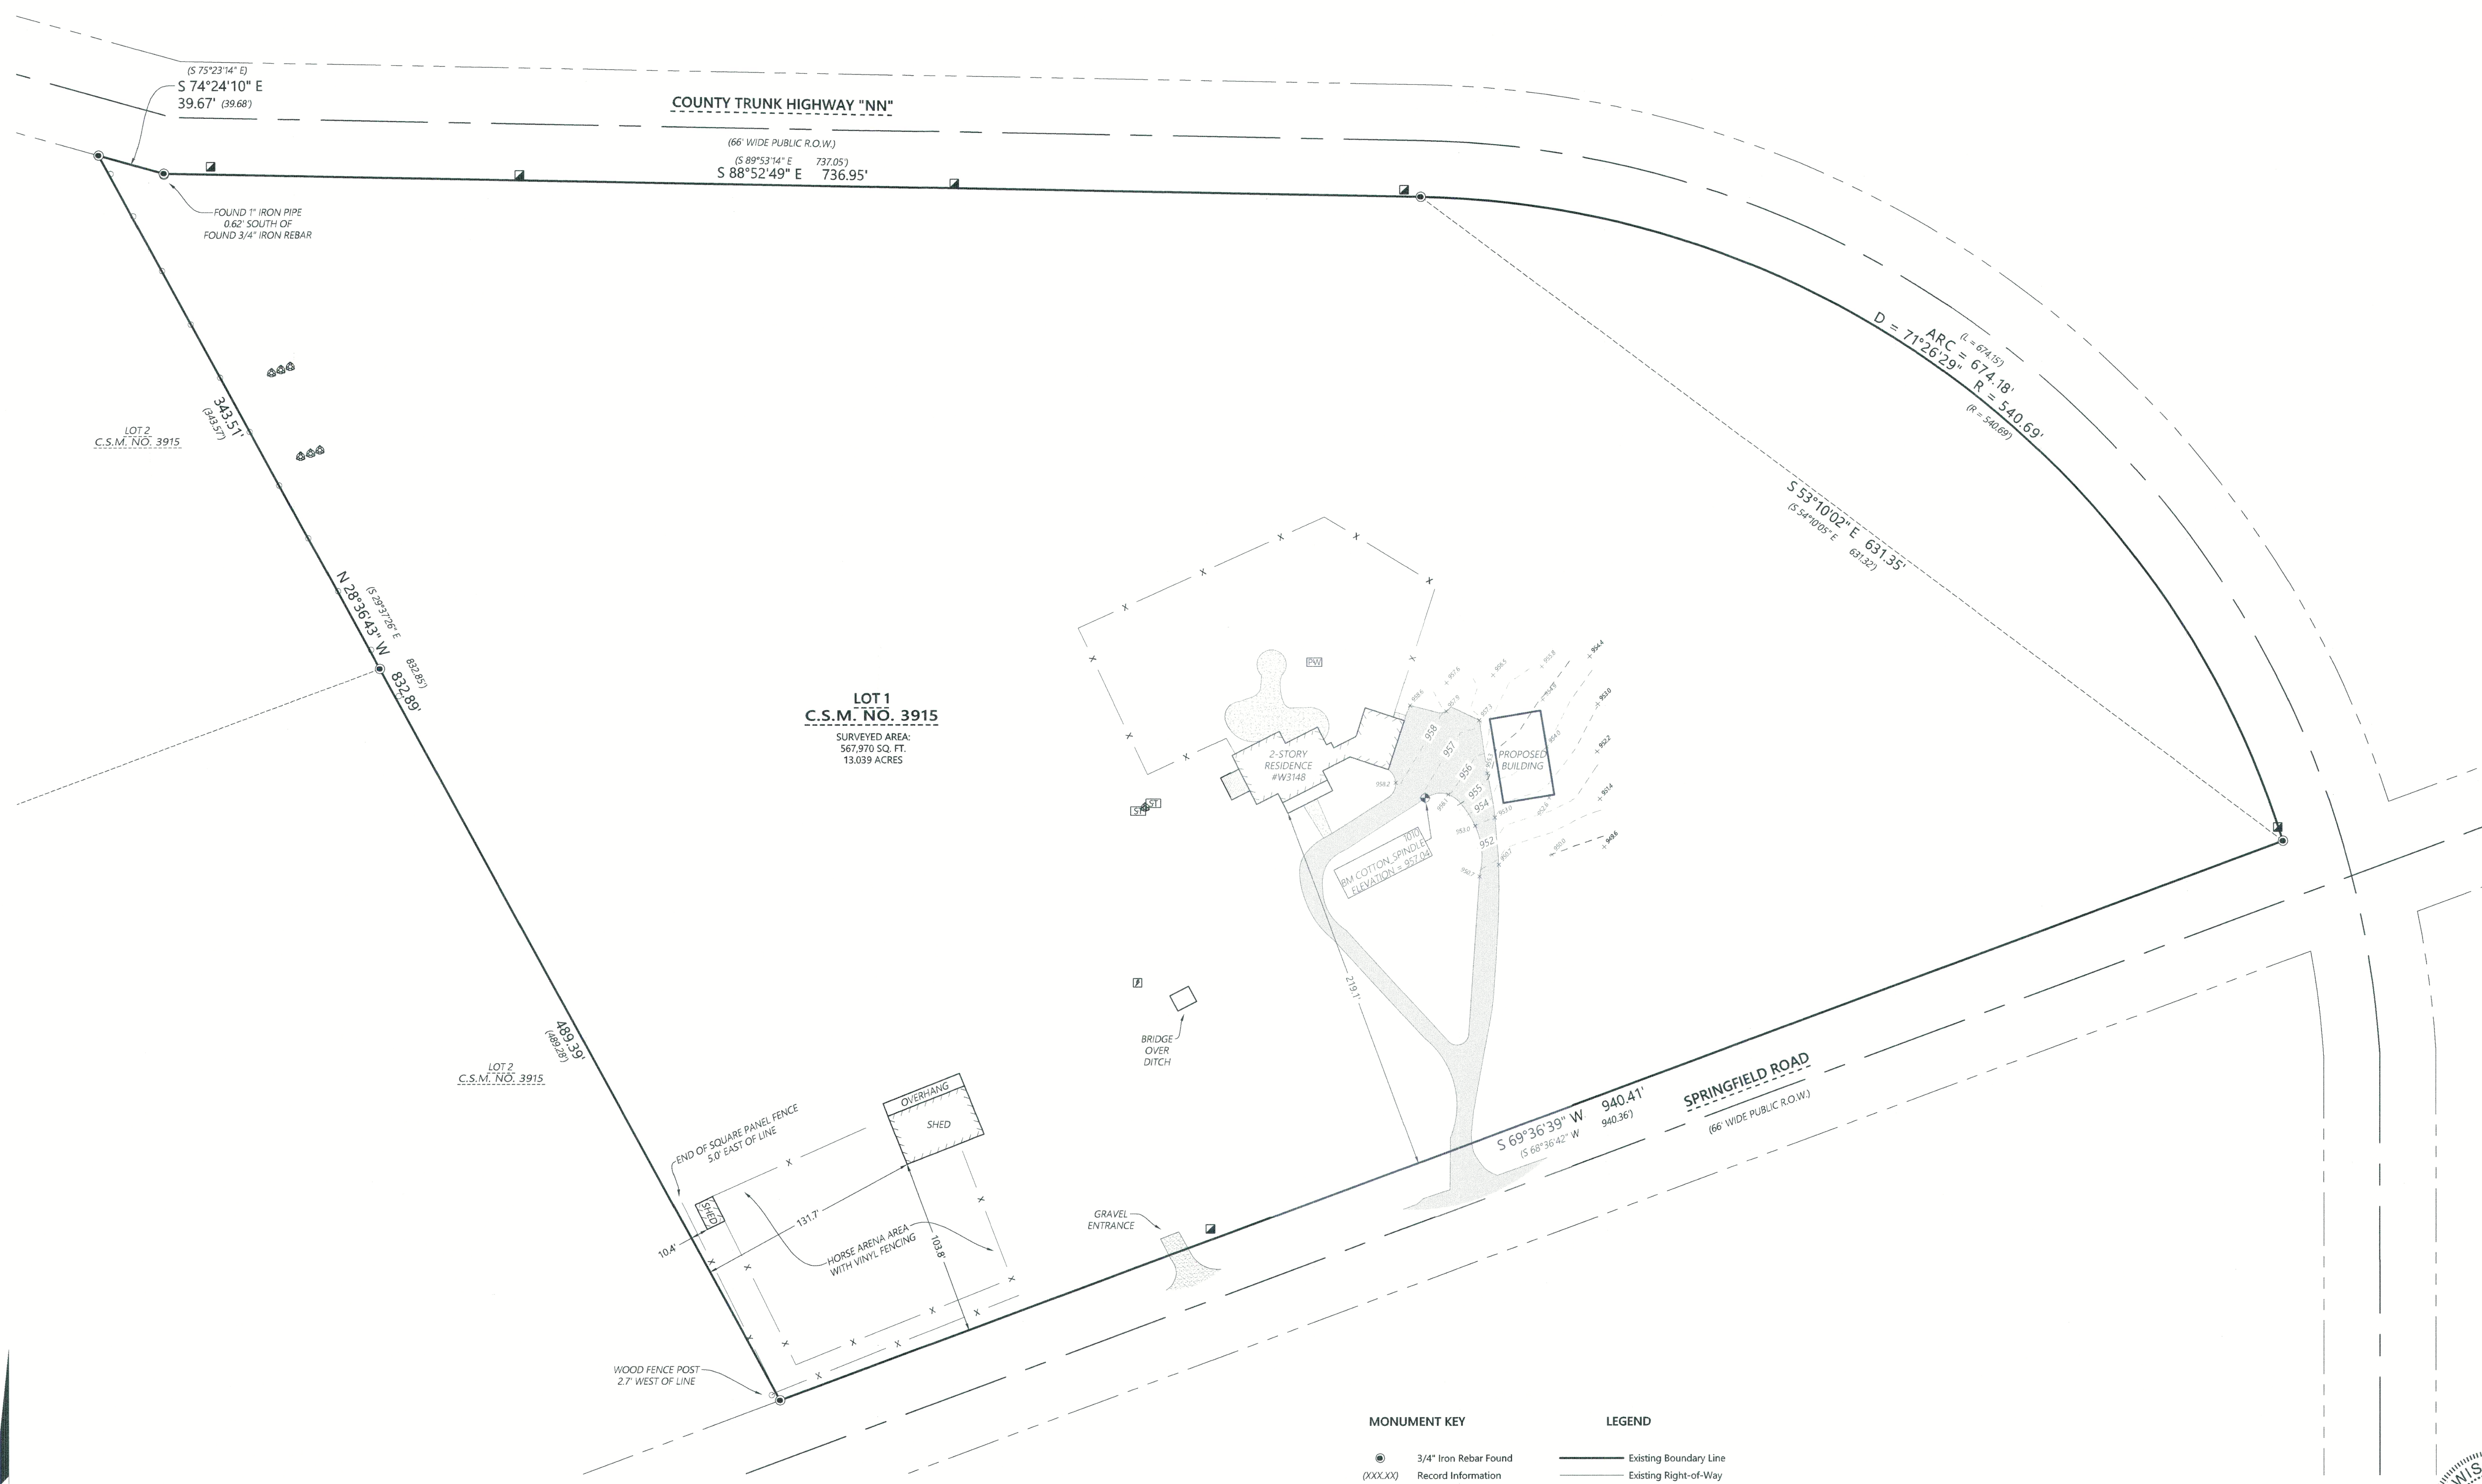

Scale: 1" = 50'

DISTANCE UNITS BASED ON THE UNITED STATES SURVEY FOOT

BEARINGS BASED ON THE WISCONSIN COORDINATE REFERENCE SYSTEM, WALWORTH ZONE. THE NORTH LINE OF SPRINGFIELD ROAD BEARING S 69°36'39"

VERTICAL DATUM BASED ON NAVD-88 (2012)
GEOID 18 WISCONSIN
STARTING BENCHMARK:
NGS MONUMENT PID: DG4876
PUBLISHED ELEVATION: 898.5'

- SURVEY NOTES**
1. SURVEYED PROPERTY SUBJECT TO ANY AND ALL EASEMENTS AND AGREEMENTS RECORDED AND UNRECORDED.
 2. THIS SURVEY IS A RETRACEMENT OF A SURVEY PERFORMED BY MARK L. MIRITZ, DATED 8-25-2018.


- MONUMENT KEY**
- 3/4" Iron Rebar Found
 - (XXX) Record Information
 - ⊕ Benchmark
- LEGEND**
- Existing Boundary Line
 - - - Existing Right-of-Way
 - - - Existing Adjacent Property
 - - - Existing Centerline
 - - - Existing Fence
 - - - Curve Chord/Radius Line
 - ⊡ Existing Transformer
 - ⊡ Existing Telephone Pedestal
 - ⊡ Existing Well
 - ⊡ Existing Septic Tank
 - ⊡ Existing Septic Vent
 - ⊡ Existing Spot Elevation
 - Existing Asphalt Pavement
 - Existing Concrete
 - Existing Wood Deck

Kristin J. Belongia

Kristin J. Belongia, P.L.S.
Wisconsin Professional Land Surveyor S-2943

State of Wisconsin } ss
County of Walworth }

I hereby certify that I have supervised the survey of the property described above and to the best of my knowledge and belief, the plat drawn hereon complies with Chapter A-E 7 of the State of Wisconsin Administrative Code, Minimum Standards for Property Surveys and correctly represents said survey and its location.
Given under my hand and seal at Elkhorn, Wisconsin this 15th day of May, 2026
Last day of field work: April 27th, 2026

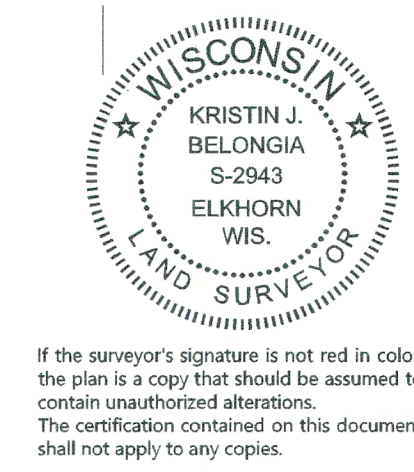

If the surveyor's signature is not red in color, the plan is a copy that should be assumed to contain unauthorized alterations. The certification contained on this document shall not apply to any copies.

Batterman
engineers, surveyors, planners
BELOIT | ELKHORN | JANESVILLE
2857 S. Baraboo Dr., Beloit, WI 53511
608.365.4464 | www.batterman.com

PLAT OF SURVEY WITH TOPOGRAPHIC MAPPING
FOR
W3148 SPRINGFIELD ROAD
BELOIT, WISCONSIN

FOR THE EXCLUSIVE USE OF:
Adam R. Levy & Kimberly A. Levy
W3148 Springfield Road
Lake Geneva, WI 53147

ORDER NO: 35905
FIELD CREW: BMR
DRAWN BY: BMR
SHEET 1 OF 1

File Name: 1310002 - 35905-0305 - Adam Levy SURVEY PLOT DRAWING FILES