



PLAT OF SURVEY
OF LOTS 2, 3, AND 4, BLOCK 20, OF SUNSET HILLS (UNIT "B"),
BEING PART OF THE NE 1/4 OF THE SW 1/4 OF SECTION 33, T. 2 N., R. 17 E.,
OF THE 4TH P.M., TOWN OF GENEVA, WALWORTH COUNTY, WISCONSIN

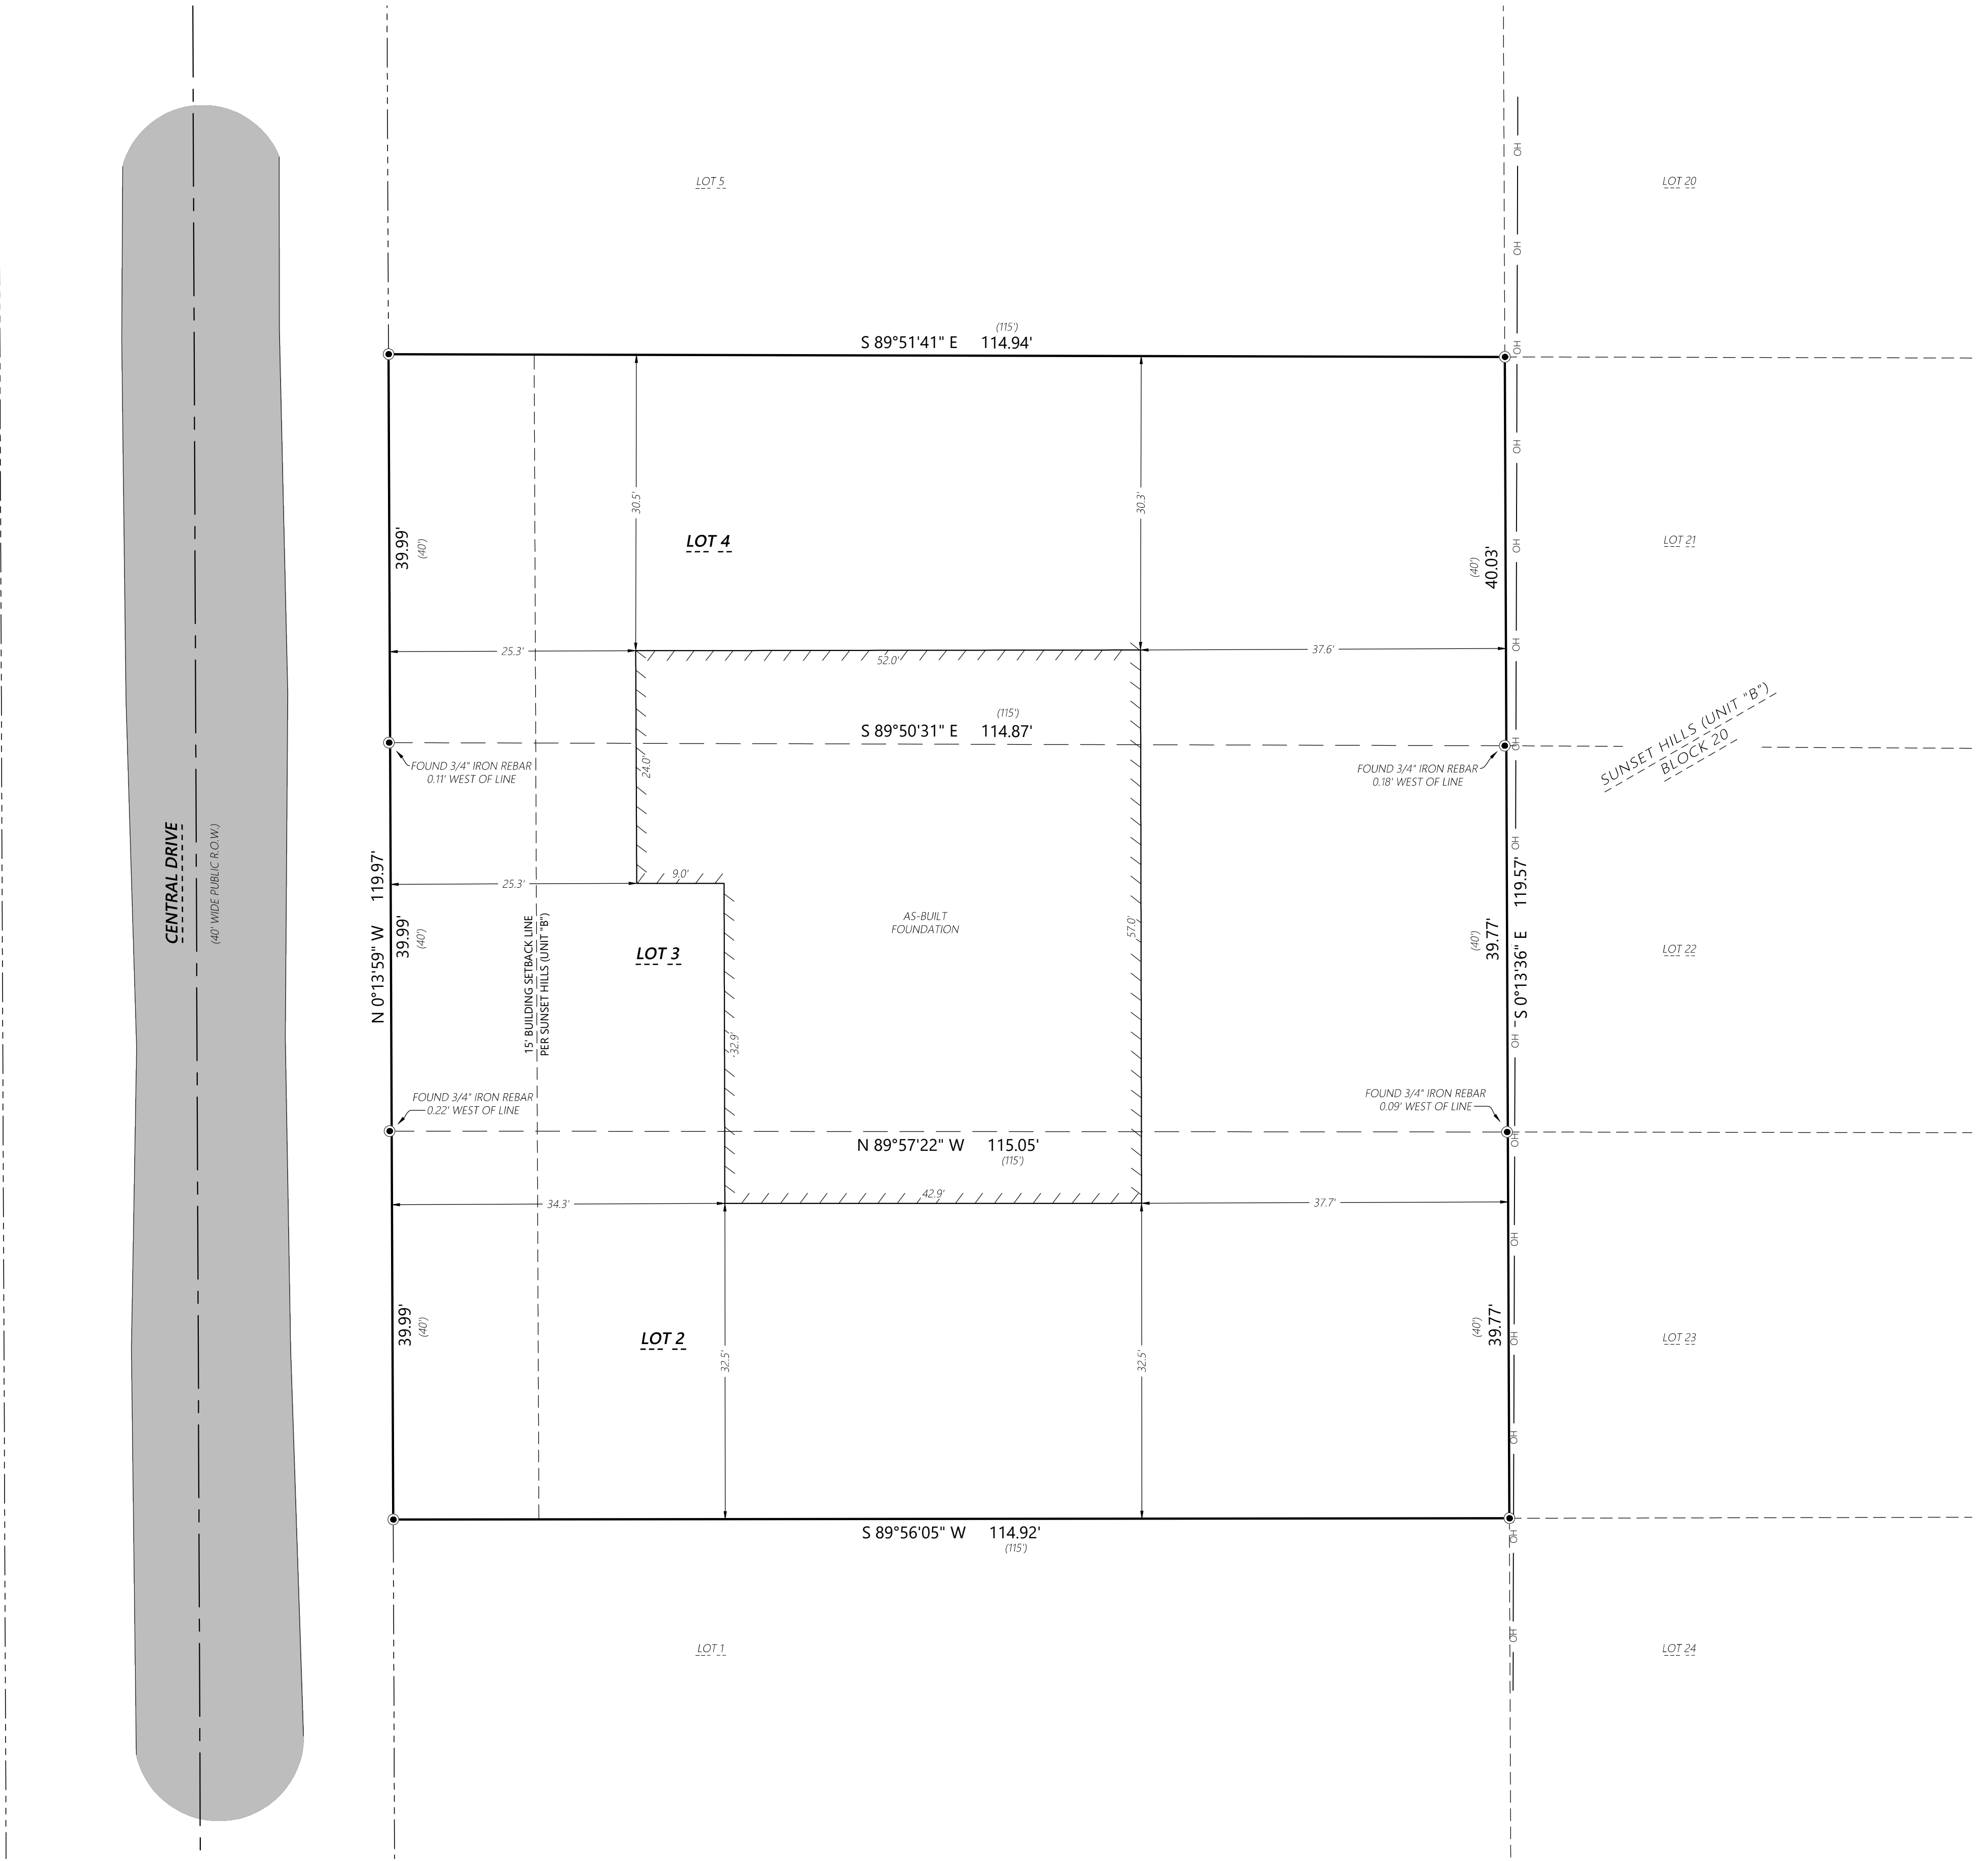

MONUMENT KEY		LEGEND	
●	3/4" Iron Rebar Found	—	Existing Boundary Line
(XXX)XX	Record Information	- - - - -	Existing Right-of-Way
		- - - - -	Existing Adjacent Property
		- - - - -	Existing Centerline
		— OH —	Existing Overhead Power
		■	Existing Asphalt Pavement

SURVEY NOTES
1. SURVEYED PROPERTY SUBJECT TO ANY AND ALL EASEMENTS AND AGREEMENTS RECORDED AND UNRECORDED.

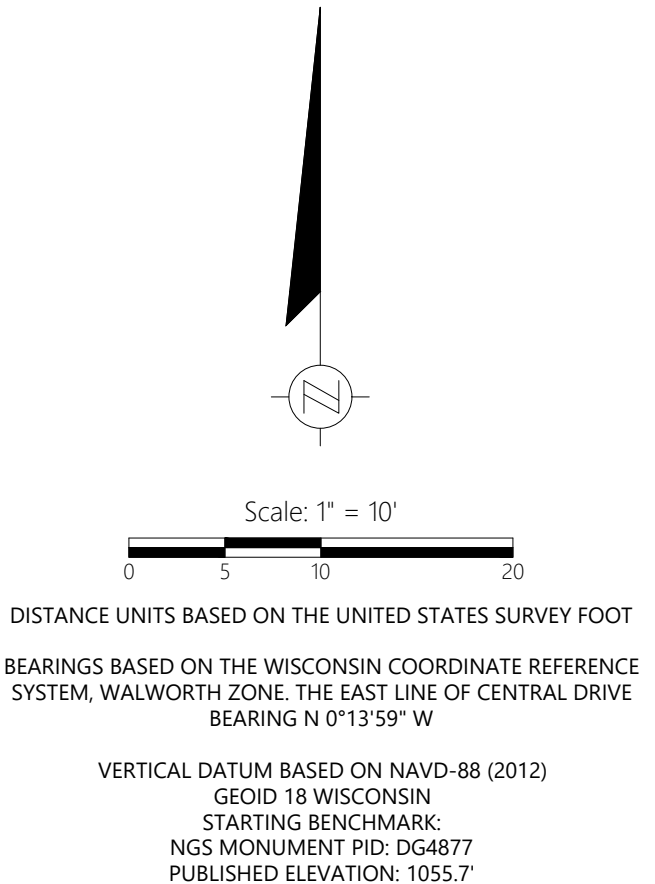

Kristin J. Belongia
Kristin J. Belongia, P.L.S.
Wisconsin Professional Land Surveyor S-2943
State of Wisconsin } ss
County of Walworth }

I hereby certify that I have supervised the survey of the property described above and to the best of my knowledge and belief, the plat drawn hereon complies with Chapter A-E 7 of the State of Wisconsin Administrative Code, Minimum Standards for Property Surveys, and correctly represents said survey and its location.
Given under my hand and seal at Elkhorn, Wisconsin this 25th day of February, 2026.
Last day of field work: February 9th, 2026
Revised to show As-Built Residence Foundation August 25th, 2026

ORDER NO: 35820

FIELD CREW: BMR
DRAWN BY: BMR
SHEET 1 OF 1

FOR THE EXCLUSIVE USE OF:

Mackay Builders, LLC c/o Ryan Mackay
W3896 Woodland Drive
Lake Geneva, WI 53147

PLAT OF SURVEY

Batterman
engineers surveyors planners
BELOIT | ELKHORN | JANESVILLE
2857 S. Bartells Dr., Beloit, WI 53511
608.365.4464 | www.rhbatterman.com

