


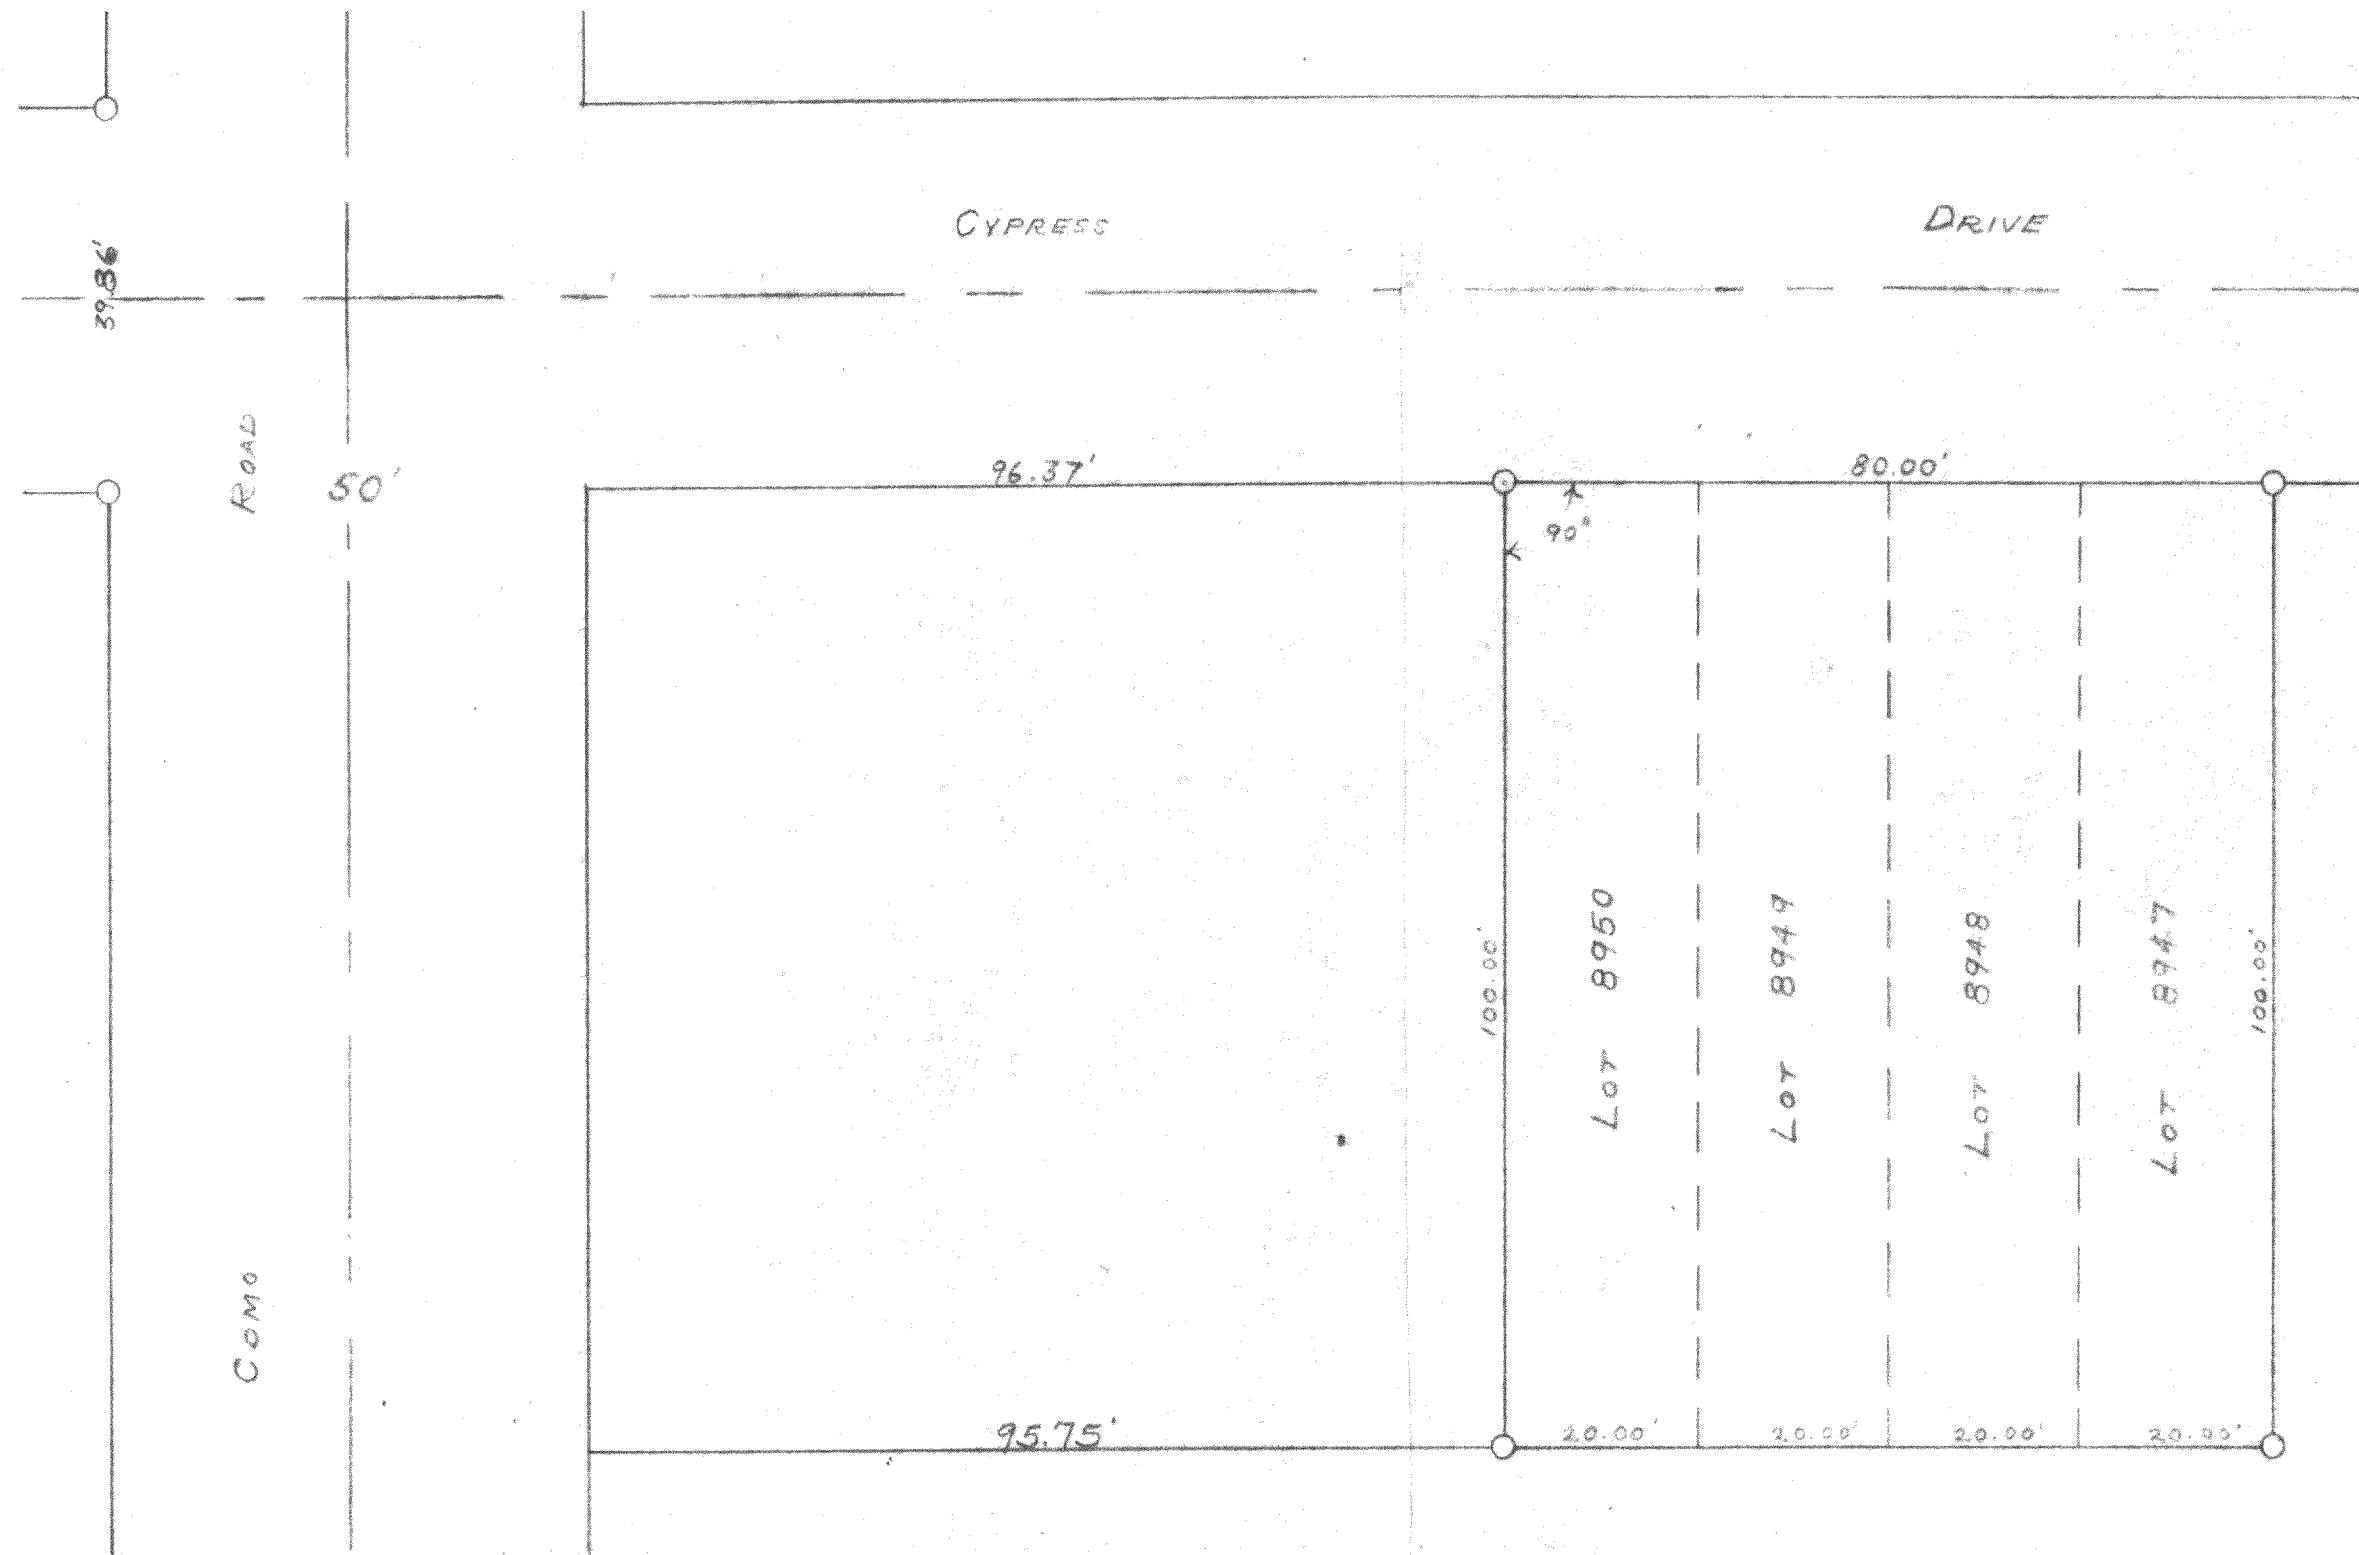

SCALE 1" = 20'
O = IRON PIPE

PLAT OF SURVEY OF LOTS 8947 -
8950 INCLUSIVE IN LAKE COMO BEACH SUBDIVISION,
WALWORTH COUNTY, WISCONSIN
AUGUST 1, 1951

Lloyd L. Jensen
COUNTY SURVEYOR

217-54.1

JLCB-1922