

HAROLD H. KOLB


REGISTERED PROFESSIONAL LAND SURVEYOR
LAKE GENEVA, WISCONSIN

LINCOLN DRIVE 50' WIDE

40' WIDE

ROAD

NYMPH

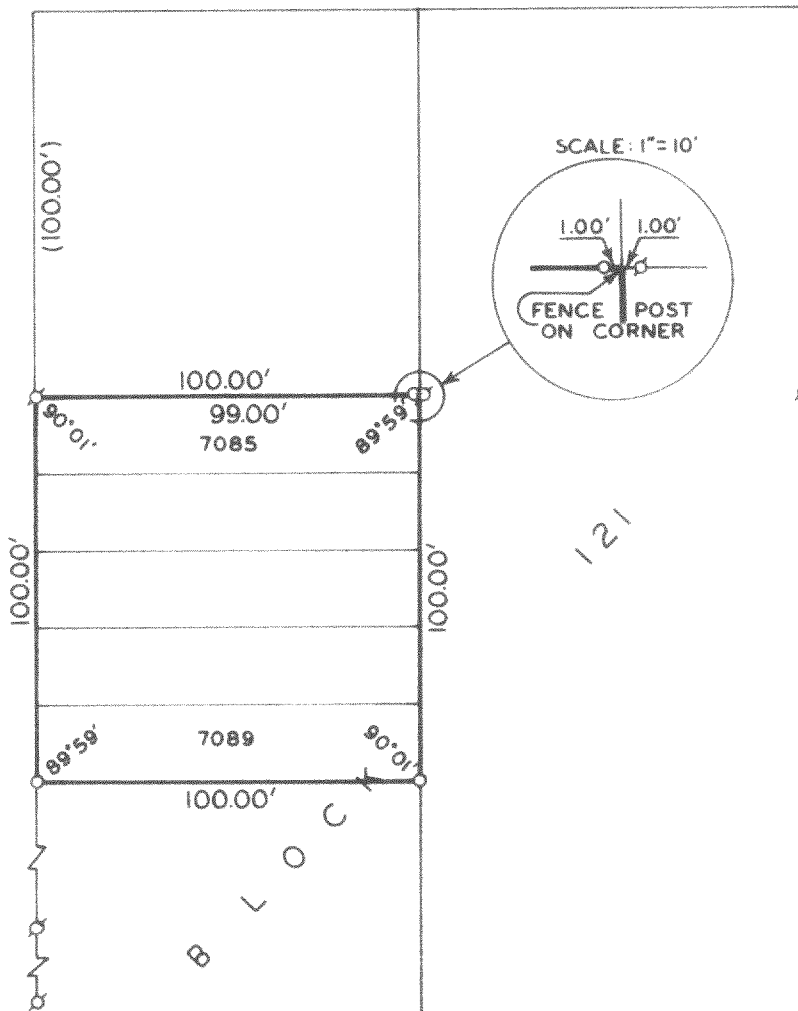

40' WIDE

ROAD

MISTLE

PLAT OF SURVEY OF

LOTS 7085 THROUGH 7089, BLOCK 121,
LAKE COMO BEACH, TOWN 2 NORTH,
RANGE 17 EAST, WALWORTH COUNTY,
WISCONSIN.

ORDERED BY: WILLIAM E. STOLTZ

JLCB-01499

N



SCALE : 1"=50'

LEGEND

- O — IRON PIPE PLACED. 1" x 24" 1.13 LB./LIN. FT.
- — CONCRETE MONUMENT. 5" DIA. x 30"
- ∅ — IRON PIPE FOUND

I, HAROLD H. KOLB, DO HEREBY CERTIFY THAT I HAVE
SURVEYED THE PROPERTY HEREON DESCRIBED ACCORDING
TO THE OFFICIAL RECORDS, AND THAT THE PLAT HEREON
IS A CORRECT REPRESENTATION OF THE LOT LINES.

Harold H. Kolb

HAROLD H. KOLB
WISCONSIN REGISTERED LAND SURVEYOR, S-187

DATE Oct. 26, 1977

217-541