


HAROLD H. KOLB

REGISTERED PROFESSIONAL LAND SURVEYOR
LAKE GENEVA, WISCONSIN


LINCOLN DRIVE 50' WIDE

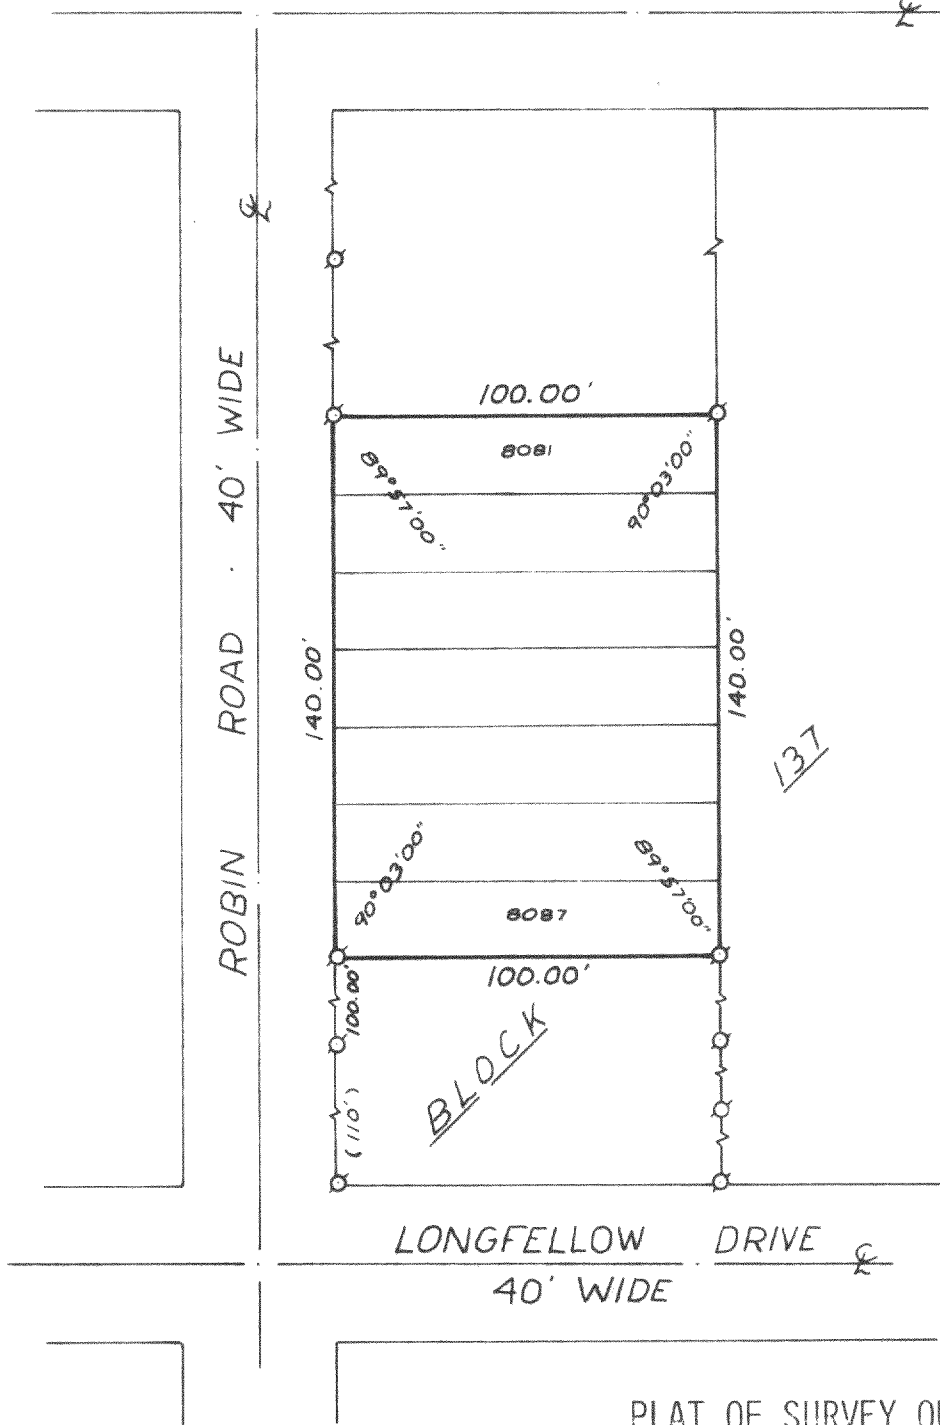

PLAT OF SURVEY OF

JLCB-01721-8081+8082 LOTS 8081--8087, BLOCK 137, LAKE
COMO BEACH SUBDIVISION, T 2 N,
-01722-8083-87 R 17 E, WALWORTH COUNTY, WISCONSIN.

ORDERED BY: CATHERINE ZUCKMANTEL

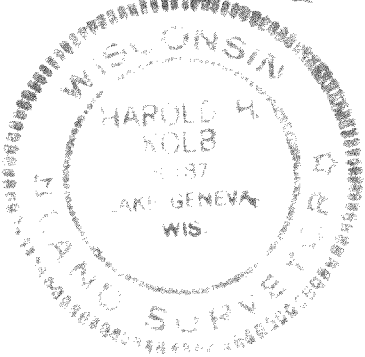

N

SCALE 1"=50'

LEGEND

- O - IRON PIPE PLACED, 1" x 24" 1.13 LB./LIN. FT.
- - CONCRETE MONUMENT, 5" DIA. x 30"
- ⊘ - IRON PIPE FOUND

I, HAROLD H. KOLB, DO HEREBY CERTIFY THAT I HAVE
SURVEYED THE PROPERTY HEREON DESCRIBED ACCORDING
TO THE OFFICIAL RECORDS, AND THAT THE PLAT HEREON
IS A CORRECT REPRESENTATION OF THE LOT LINES.

Harold H. Kolb

HAROLD H. KOLB
WISCONSIN REGISTERED LAND SURVEYOR, S-187

DATE May 12, 1977

217-543