


HAROLD H. KOLB

REGISTERED PROFESSIONAL LAND SURVEYOR
LAKE GENEVA, WISCONSIN

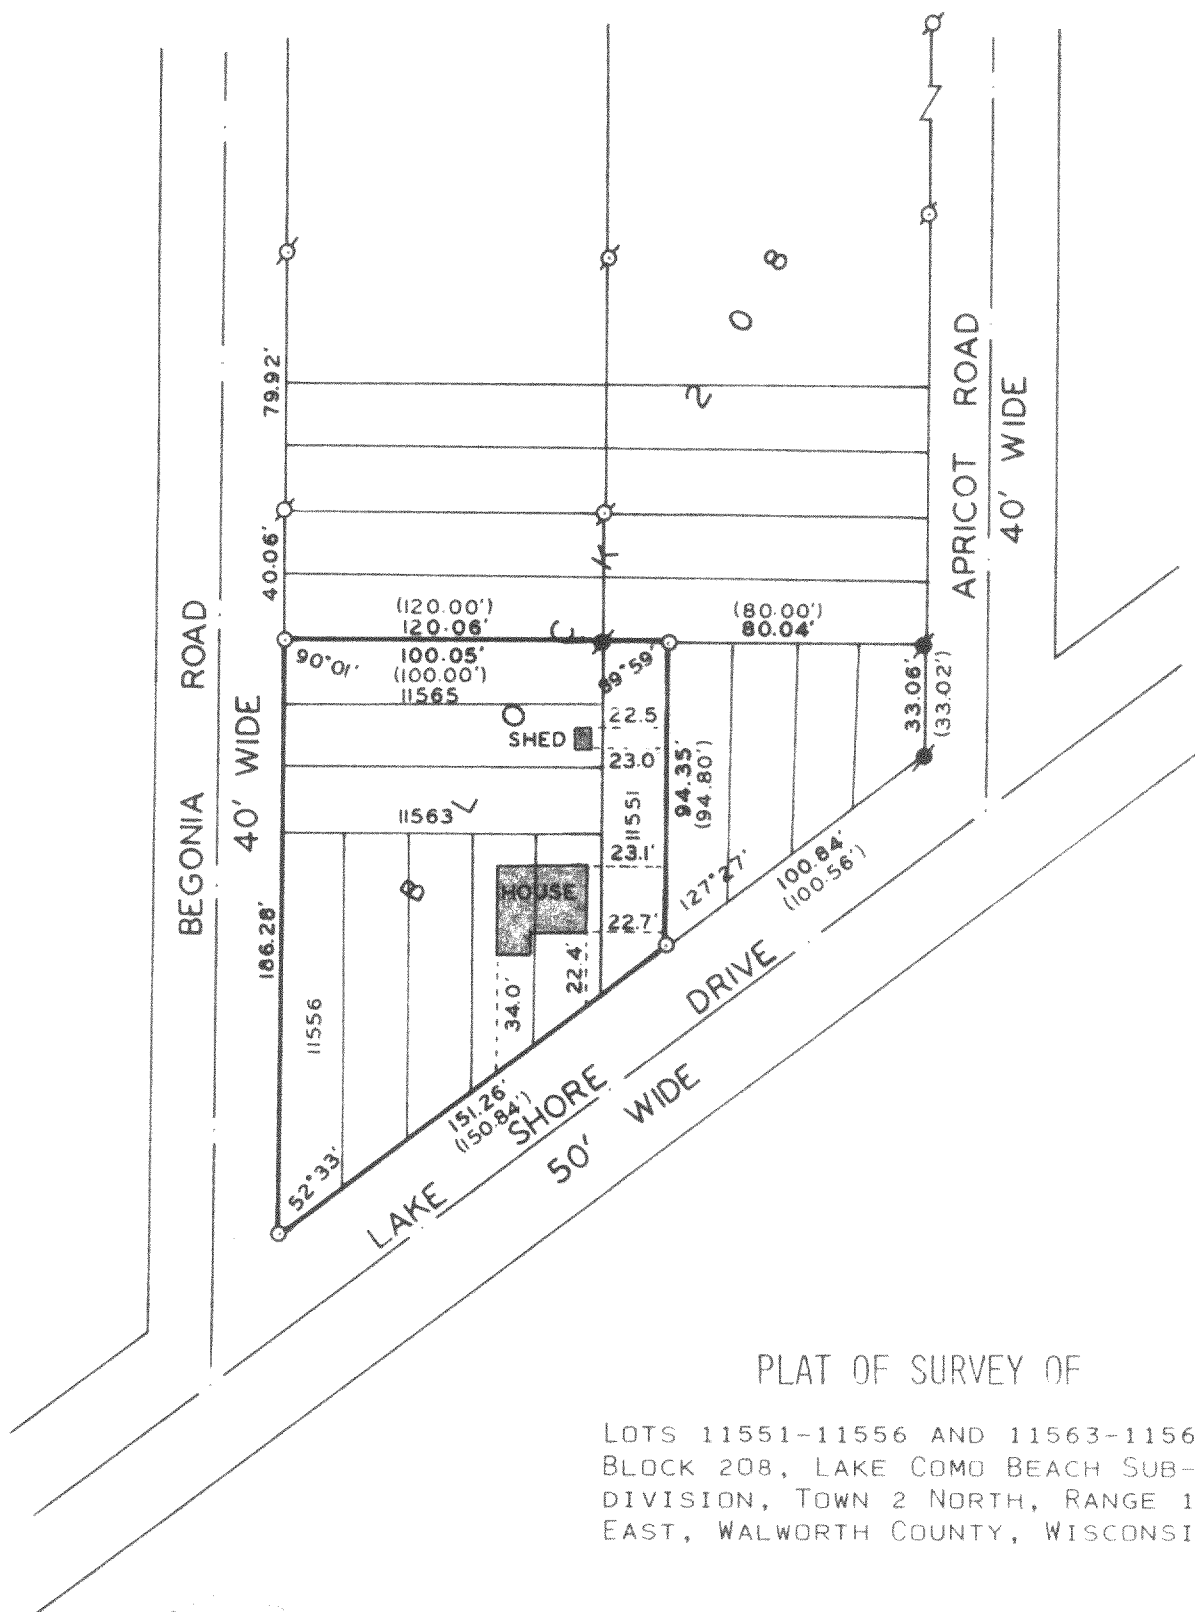

PLAT OF SURVEY OF

LOTS 11551-11556 AND 11563-11565,
BLOCK 208, LAKE COMO BEACH SUB-
DIVISION, TOWN 2 NORTH, RANGE 17,
EAST, WALWORTH COUNTY, WISCONSIN.

ORDERED BY: BOB KEEFE & ASSOCIATES, INC.

FOR: JOHN BAUER, OWNER

I, HAROLD H. KOLB, DO HEREBY CERTIFY THAT I HAVE
SURVEYED THE PROPERTY HEREON DESCRIBED ACCORDING
TO THE OFFICIAL RECORDS, AND THAT THE PLAT HEREON
IS A CORRECT REPRESENTATION OF THE LOT LINES.

Harold H. Kolb

HAROLD H. KOLB
WISCONSIN REGISTERED LAND SURVEYOR, S-187

DATE Oct 27, 1977

N
↑
SCALE: 1" = 60'
LEGEND

- — IRON PIPE PLACED, 1" x 24" 1.13 LB./LIN. FT.
- — CONCRETE MONUMENT, 5" DIA. x 30"
- () — AS PLATTED
- ⊘ — IRON PIPE FOUND