


PLAT OF SURVEY of Lots 11547, 11548, 11549, 11550, 11557 & 11558, Block 208,
5th Map of Lake Como Beach Subdivision, T2N R17E, Walworth County, Wis.

Nov. 22, 1977

Surveyed for: J. Tolson, Tolson Realty, P.O. Box 209, Fontana, Wis. 53125

I certify that I have surveyed the above described property and that the
plat shown hereon is an accurate survey and a true representation thereof
and correctly shows the boundary lines of said property and all buildings
thereon.

Thomas P. A. Jensen
THOMAS P. A. JENSEN S-1084
JENSEN SURVEYING & MAPPING
ELKHORN, WISCONSIN

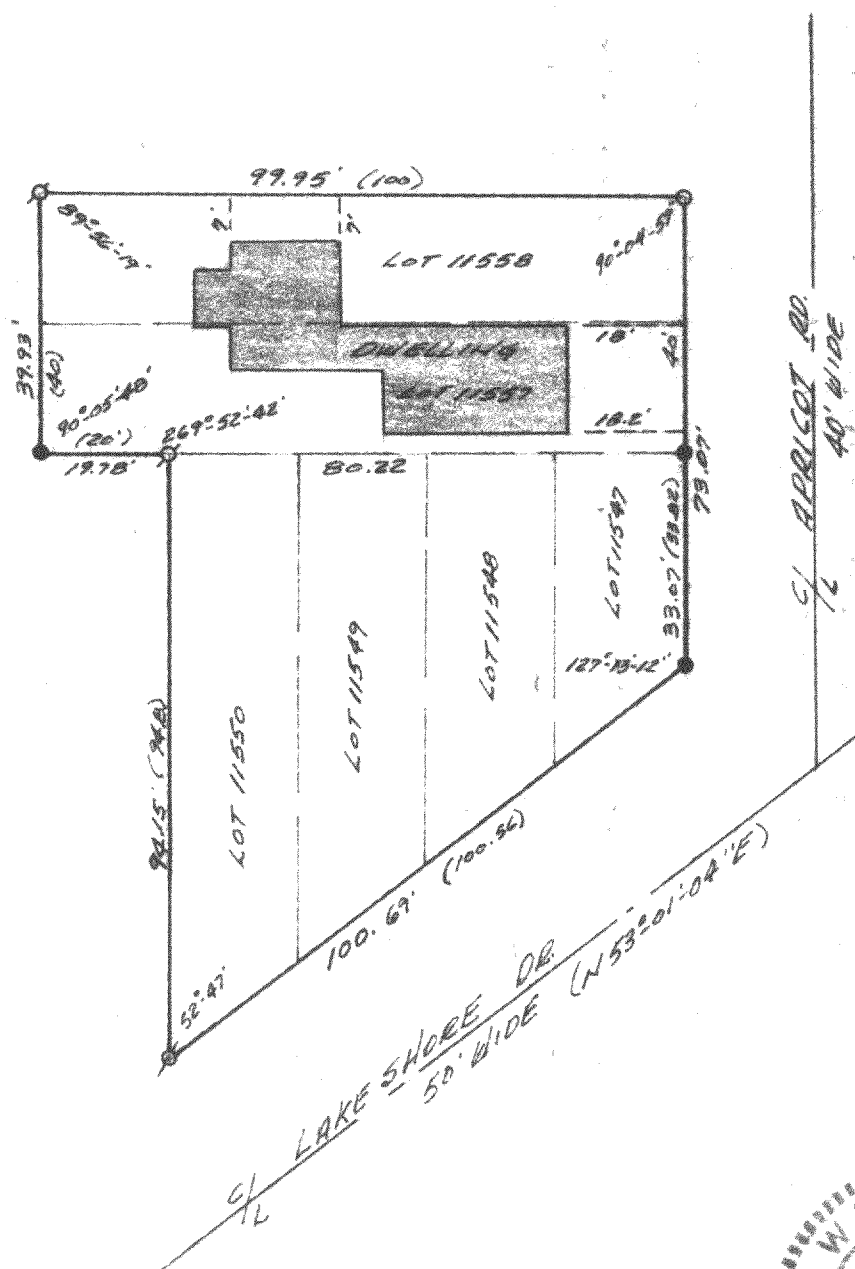

SCALE 1" = 30'
X - IRON PIPE FOUND
O - IRON PIPE SET
● - CONC. MONUMENT FOUND
() - AS PLATTED

