


DUNHAM SURVEYING, S. C.  
SURVEYING & SUBDIVIDING  
DELAVAN, WISCONSIN 53115


20' Wide Road as shown on the recorded plat of The Consumers Company Subdivision. It is not improved, but can find no evidence of having ever been vacated.

N

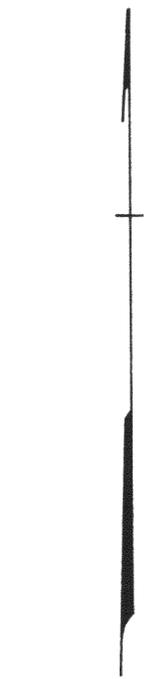

Scale - 1" = 30'

- = Iron Pipe Found
- = Iron Pipe Set
- = Fence Line
- = Sash Weight Found
- x = Cross Cut in Concrete

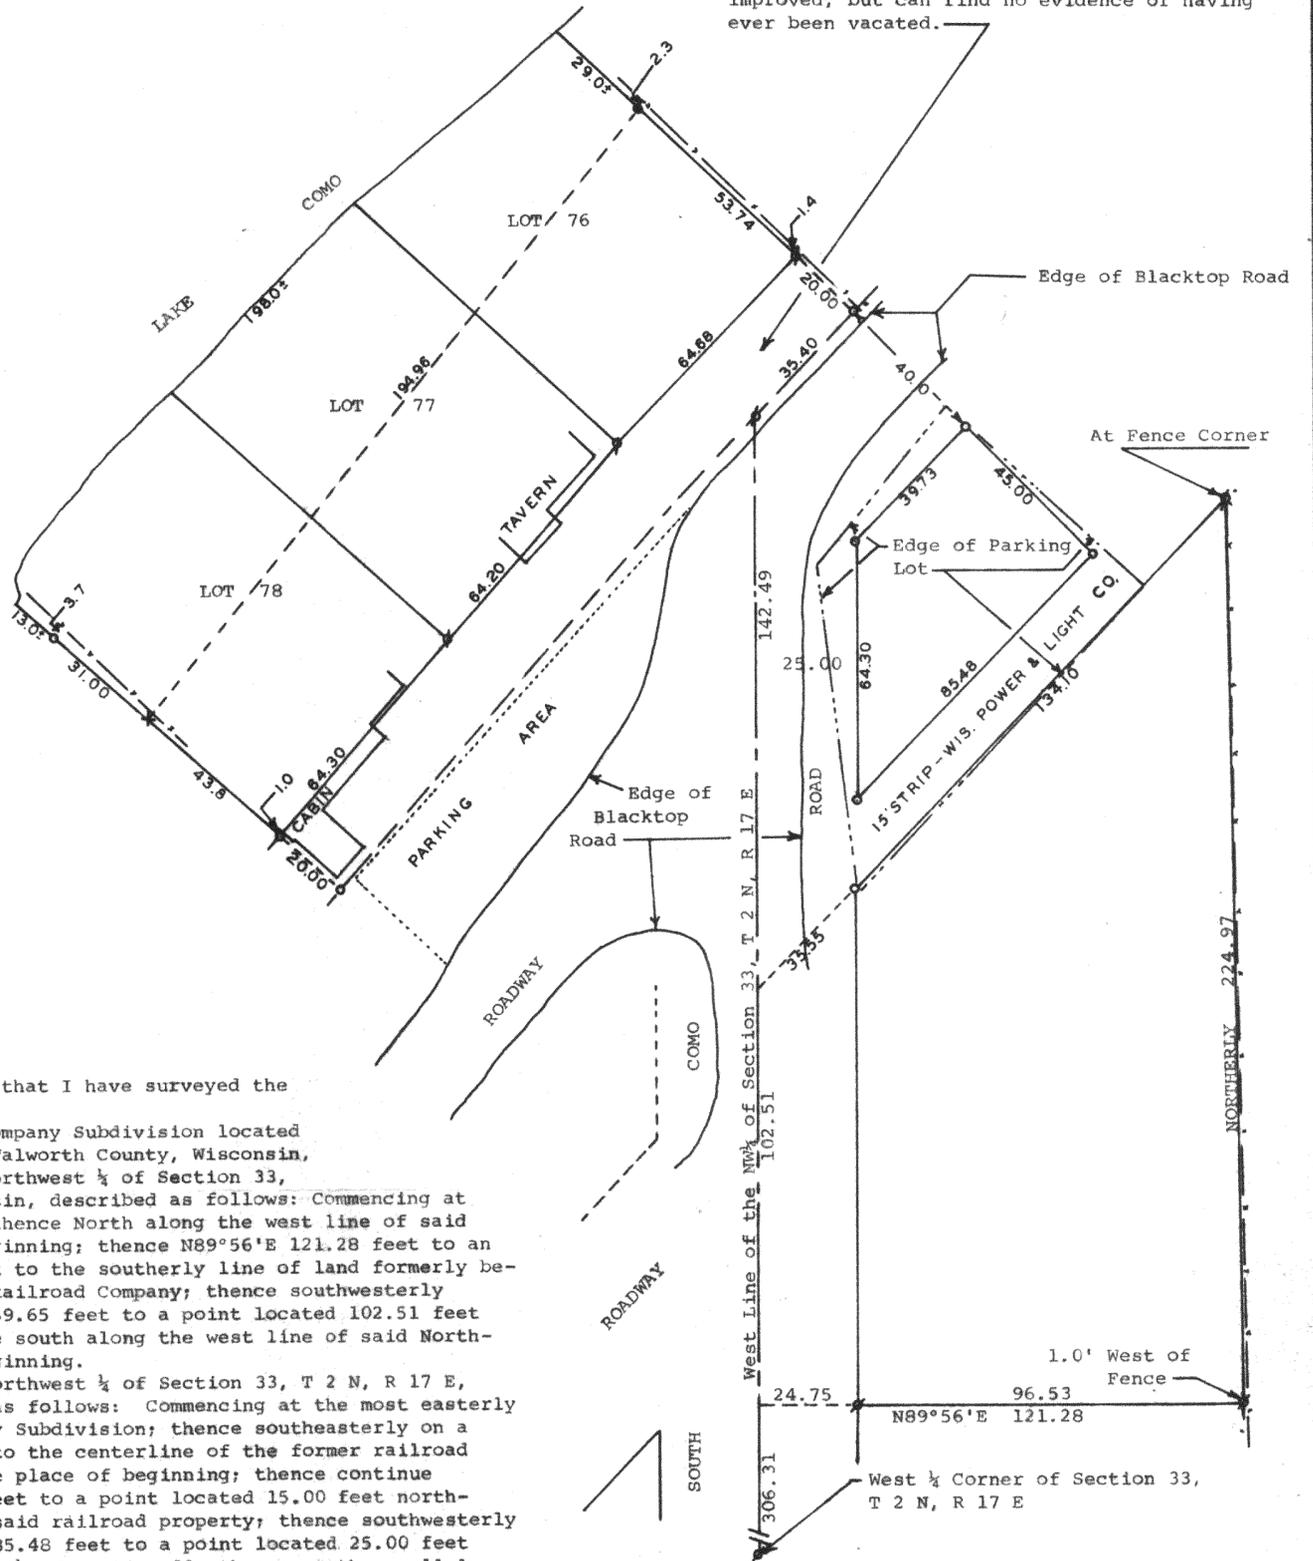

STATE OF WISCONSIN) SS  
COUNTY OF WALWORTH)

I, George T. Dunham, Surveyor, certify that I have surveyed the property described as follows:

Lots 76, 77, and 78 of The Consumers Company Subdivision located in Sections 32 and 33, T 2 N, R 17 E, Walworth County, Wisconsin, ALSO A parcel of land located in the Northwest 1/4 of Section 33, T 2 N, R 17 E, Walworth County, Wisconsin, described as follows: Commencing at the West 1/4 corner of said Section 33; thence North along the west line of said section 306.31 feet to the place of beginning; thence N89°56'E 121.28 feet to an iron pipe; thence Northerly 224.97 feet to the southerly line of land formerly belonging to the Chicago & Northwestern Railroad Company; thence southwesterly along said railroad company property 169.65 feet to a point located 102.51 feet north of the place of beginning; thence south along the west line of said Northwest 1/4, 102.51 feet to the place of beginning.  
ALSO A parcel of land located in the Northwest 1/4 of Section 33, T 2 N, R 17 E, Walworth County, Wisconsin, described as follows: Commencing at the most easterly corner of Lot 76, The Consumers Company Subdivision; thence southeasterly on a line described as being perpendicular to the centerline of the former railroad company right of way, 60.00 feet to the place of beginning; thence continue southeasterly on the same line 45.00 feet to a point located 15.00 feet northeasterly of the southeasterly line of said railroad property; thence southwesterly parallel with said southeasterly line 85.48 feet to a point located 25.00 feet east of the west line of said Northwest 1/4 of section 33; thence north parallel with said west line 64.30 feet to a point located 60.00 feet southeasterly of the southeasterly line of said Lot 76; thence northeasterly parallel with said southeasterly line 39.73 feet to the place of beginning.

and the above map is a true representation thereof and shows the size and location of the property, its exterior boundaries, boundary fences, roadways and visible encroachments, if any.

This survey is made for the use of the present owners of the property, and also those who purchase, mortgage, or guarantee the title thereto within one (1) year from date hereof. August 20, 1979

*George T. Dunham*  
George T. Dunham, Surveyor

